


92-156

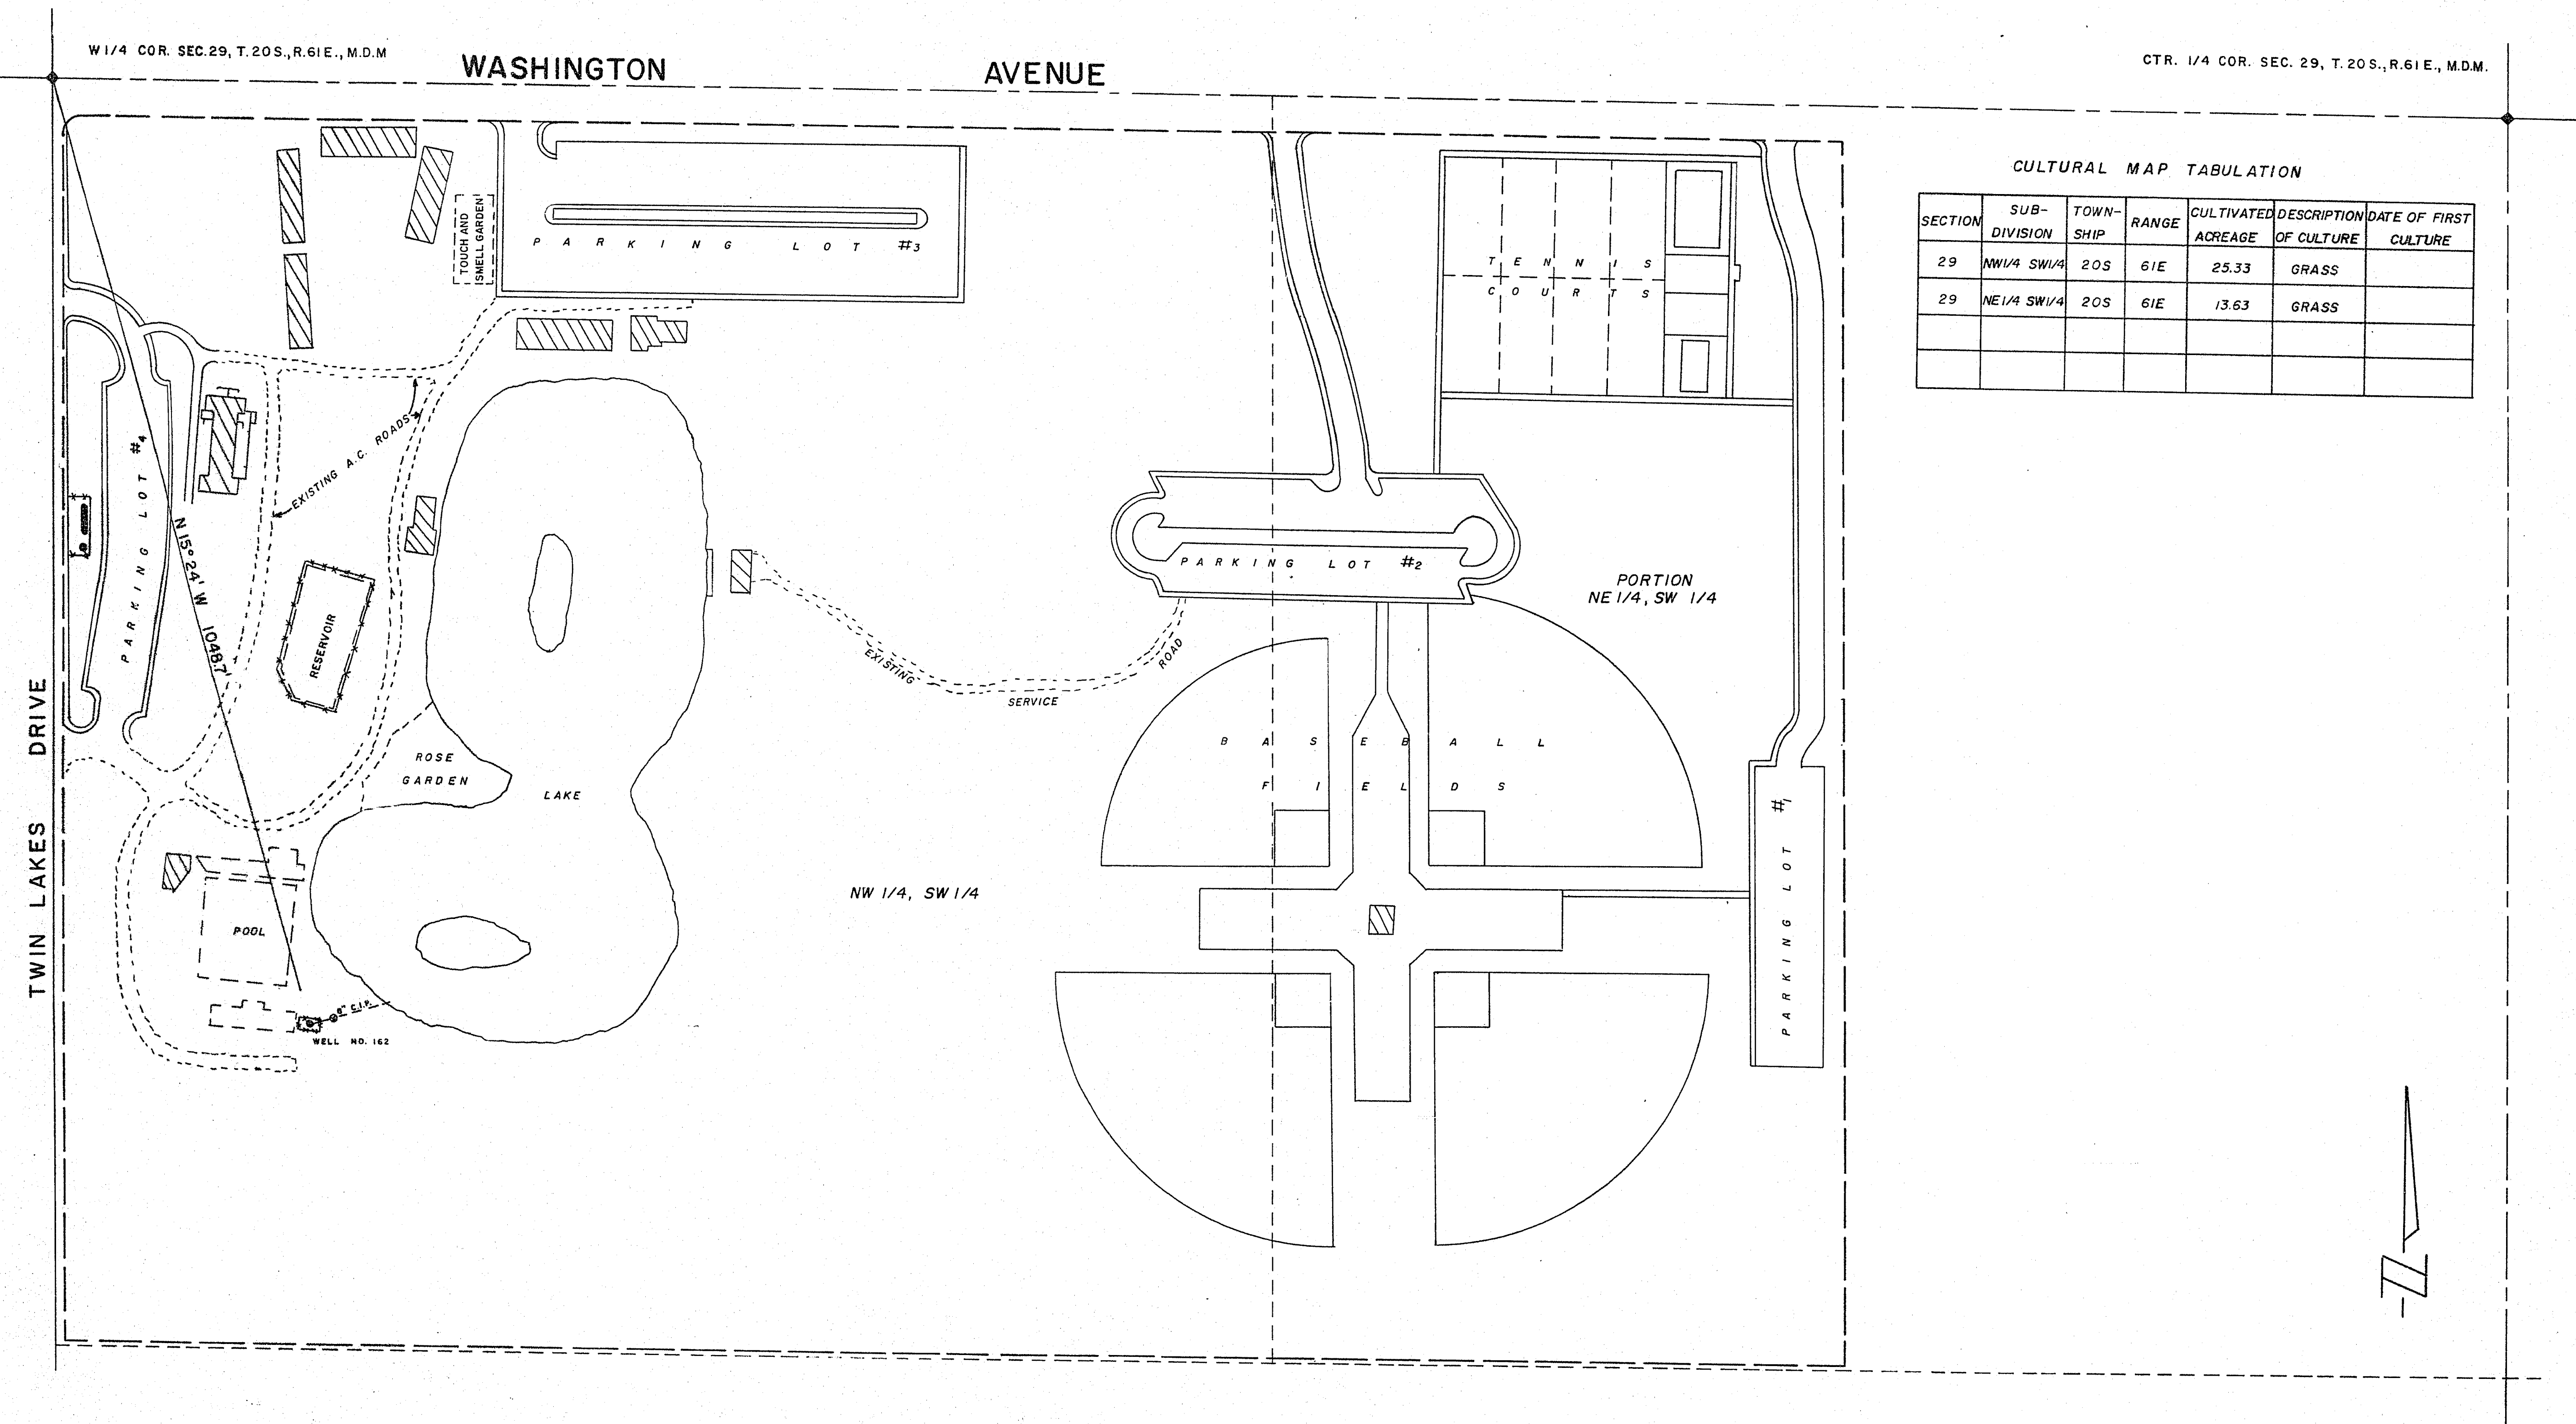

CULTURAL MAP TABULATION

SECTION	SUB-DIVISION	TOWN-SHIP	RANGE	CULTIVATED ACREAGE	DESCRIPTION OF CULTURE	DATE OF FIRST CULTURE
29	NW 1/4 SW 1/4	20S	61E	25.33	GRASS	
29	NE 1/4 SW 1/4	20S	61E	13.63	GRASS	

- LEGEND
- LIMIT OF BENEFICIAL USE
 - WELL SITE
 - WATER LINE (SIZE NOTED)
 - o GATE VALVE
 - ▨ BUILDING
 - WATER TANK

STATE OF NEVADA }
COUNTY OF CLARK } SS

I CARL P. MALONE, BEING FIRST DULY SWORN, DEPOSE AND SAY THAT THIS MAP CONSISTING OF 1 SHEET HAS BEEN CORRECTLY DRAWN TO THE DESIGNATED SCALE FROM FIELD NOTES OF A SURVEY MADE UNDER MY SUPERVISION AND DIRECTION BETWEEN THE 4TH DAY OF SEPTEMBER AND THE 8TH DAY OF SEPTEMBER, 1978. THAT IT TRULY AND CORRECTLY REPRESENTS THE LOCATION AND EXTENT OF THE WORKS USED TO DIVERT WATER FROM THE LAS VEGAS VALLEY WATER BASIN IN CLARK COUNTY BY THE CITY OF LAS VEGAS, NEVADA FOR RECREATION AND DOMESTIC PURPOSES UNDER APPLICATION NO. 26915. THAT THE POINT OF DIVERSION, THE LOCATION AND SIZE OF THE DIVERTING CONDUIT, THE LOCATION AND EXTENT OF LANDS OWNED OR CONTROLLED BY THE APPLICANT UPON WHICH WATER APPLIED FOR UNDER APPLICATION NO. 26915 IS USED, TOGETHER WITH THE AREA AND KIND OF CULTURE IN EACH 40-ACRE SUBDIVISION AND THE LOCATION AND NAMES OF ALL OTHER WORKS OR STREAMS WHICH ARE CROSSED BY OR CONNECTED WITH SAID WORKS ARE FULLY AND CORRECTLY DESIGNATED THEREON.

Carl P. Malone
STATE WATER RIGHTS SURVEYOR, NO. 505


SUBSCRIBED AND SWORN TO BEFORE ME THIS 13 DAY OF Oct, 1978

Edward L. McDonald
NOTARY PUBLIC IN AND FOR CLARK COUNTY, NEVADA

MY COMMISSION EXPIRES Feb. 4, 1980

BASIS OF BEARING

THE WEST LINE OF SECTION 29, T. 20S., R. 61E., M.D.M. ASSUMED TO BE NORTH FROM MAP FILED WITH ORIGINAL APPLICATIONS TO DIVERT WATER UNDER APPLICATION NOS. 11567, 10721 & 10722

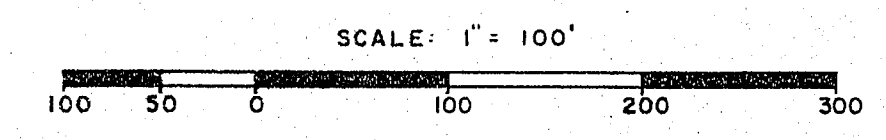

CITY OF LAS VEGAS, NEVADA
DEPARTMENT OF PUBLIC SERVICES

MAP TO ACCOMPANY
PROOF OF BENEFICIAL USE UNDER
APPLICATION NO. 26915
FOR RECREATION AND DOMESTIC
BY THE CITY OF LAS VEGAS, NEVADA
FROM THE LAS VEGAS VALLEY WATER BASIN