


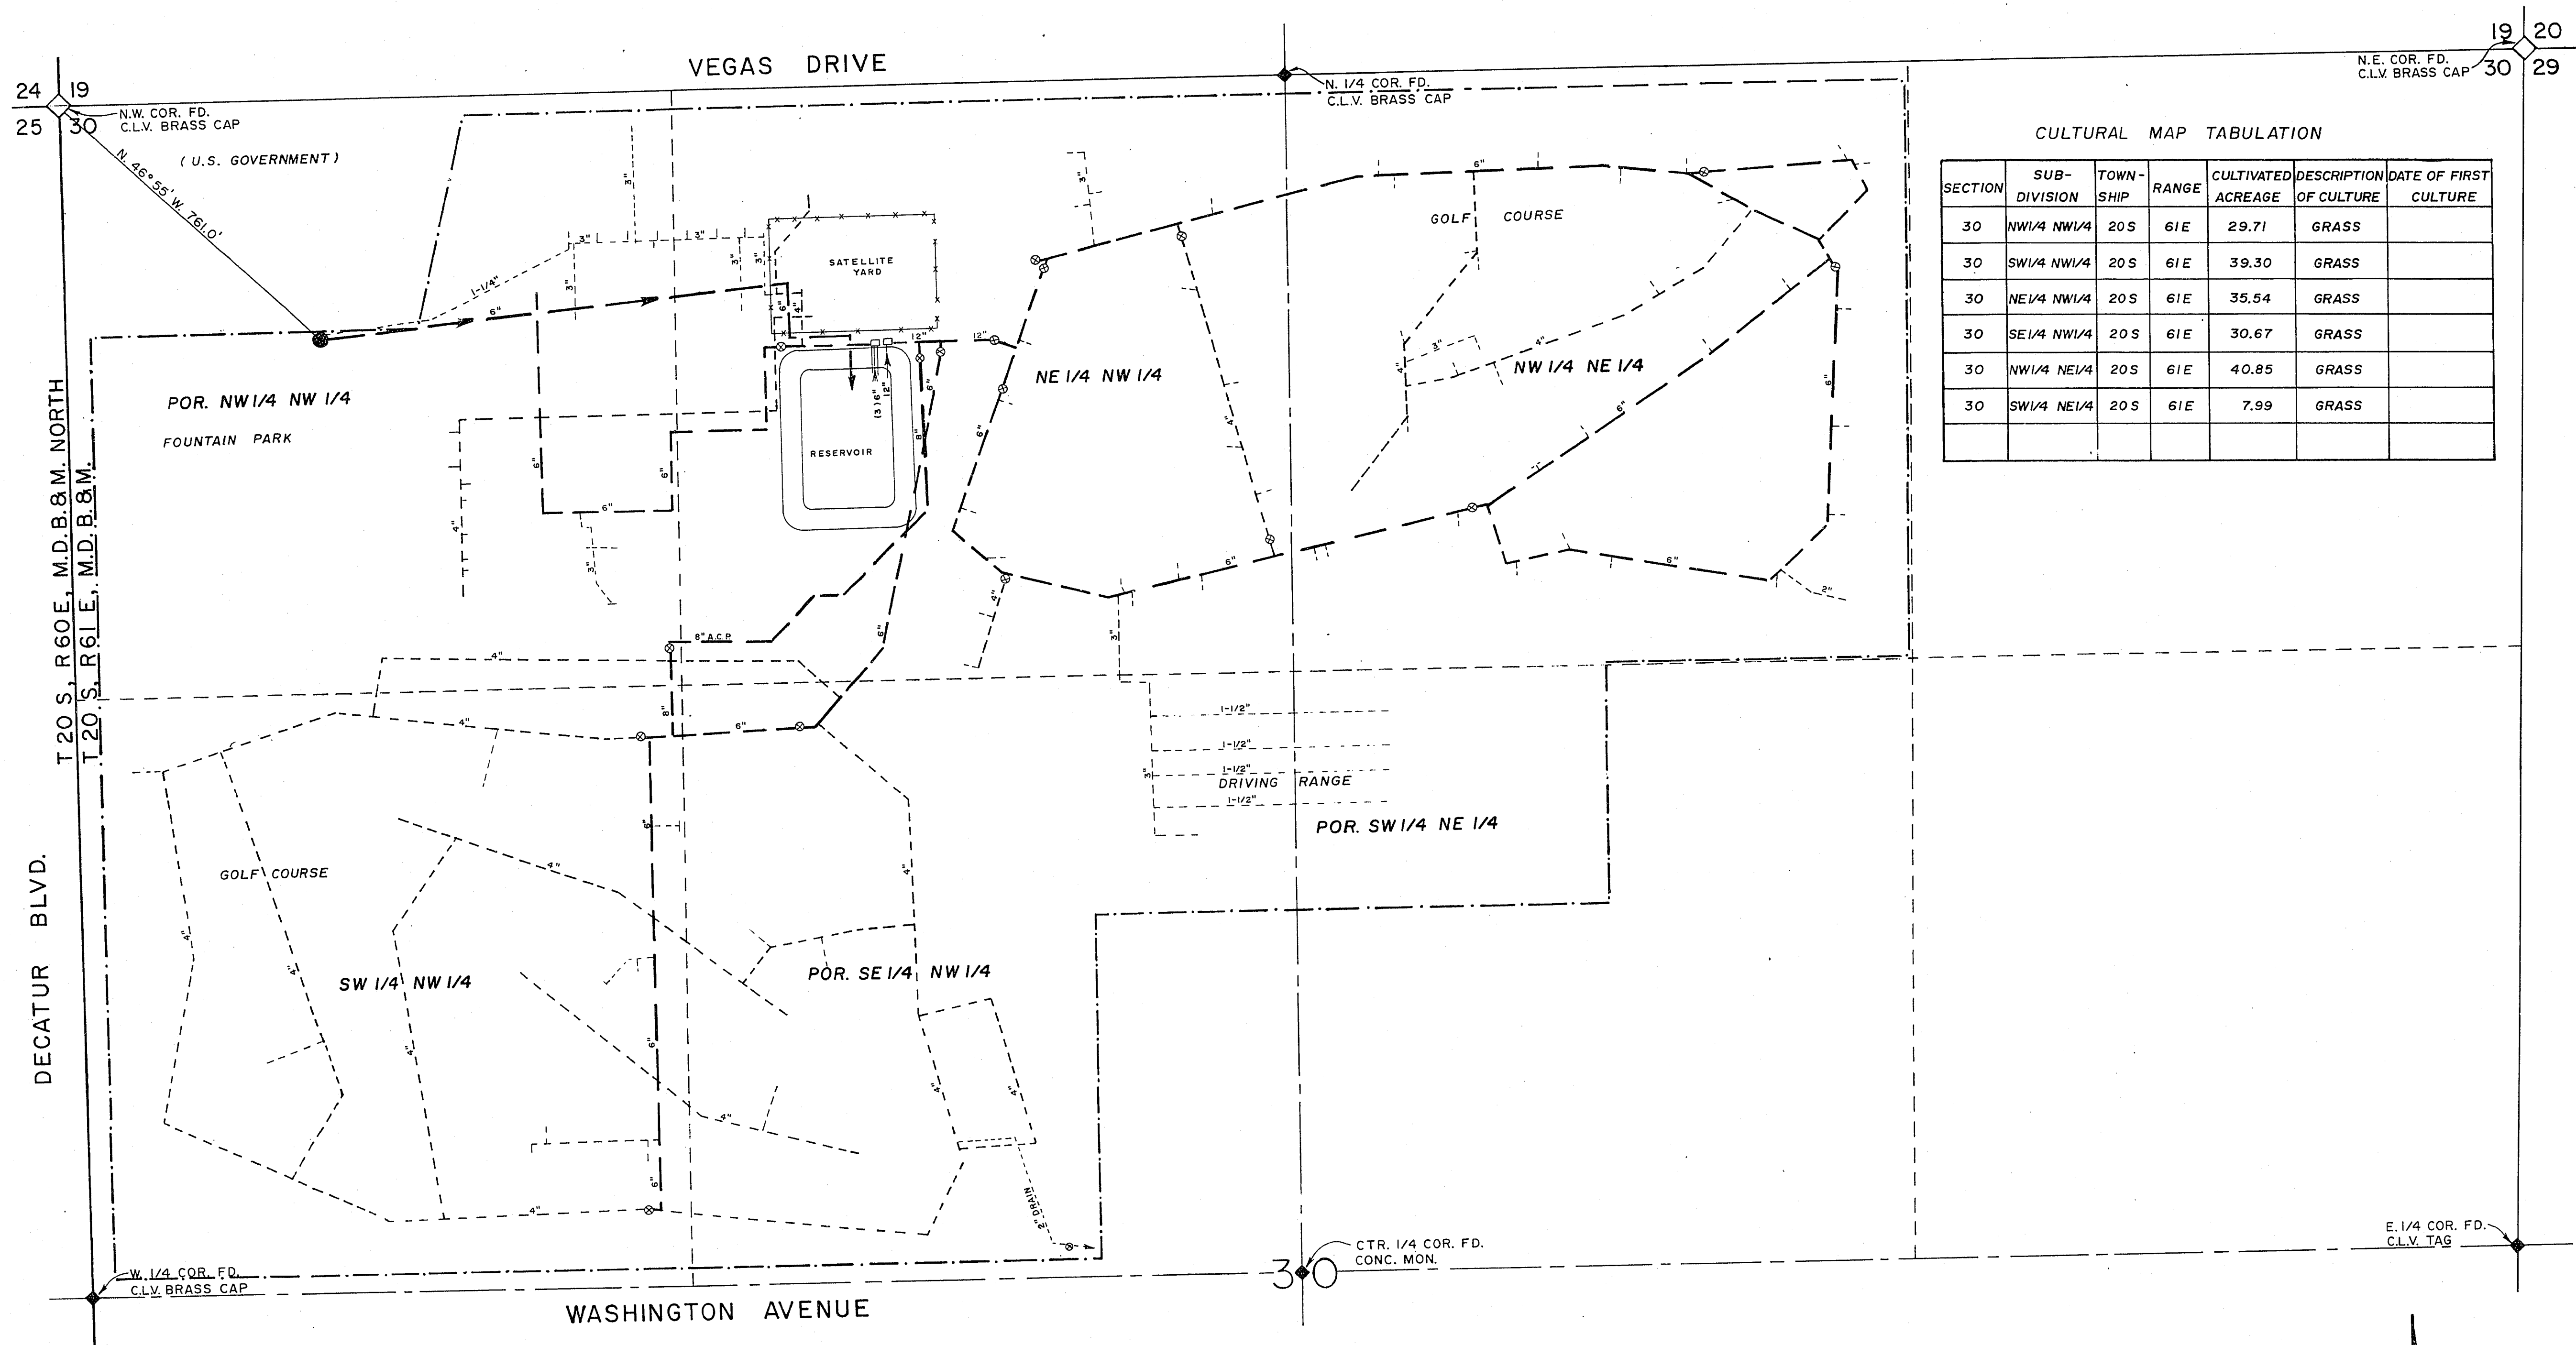

CULTURAL MAP TABULATION						
SECTION	SUB-DIVISION	TOWN-SHIP	RANGE	CULTIVATED ACREAGE	DESCRIPTION OF CULTURE	DATE OF FIRST CULTURE
30	NW 1/4 NW 1/4	20 S	61 E	29.71	GRASS	
30	SW 1/4 NW 1/4	20 S	61 E	39.30	GRASS	
30	NE 1/4 NW 1/4	20 S	61 E	35.54	GRASS	
30	SE 1/4 NW 1/4	20 S	61 E	30.67	GRASS	
30	NW 1/4 NE 1/4	20 S	61 E	40.85	GRASS	
30	SW 1/4 NE 1/4	20 S	61 E	7.99	GRASS	

- LEGEND**
- LIMIT OF BENEFICIAL USE
 - 6" 6" IRRIGATION LINE
 - 4" 4" IRRIGATION LINE
 - IRRIGATION LINE (SIZE NOTED)
 - GATE VALVE
 - WELL SITE

STATE OF NEVADA } ss
COUNTY OF CLARK }

I, WARREN L. JAUBERT, BEING FIRST DULY SWORN, DEPOSE AND SAY THAT THIS MAP, CONSISTING OF 1 SHEET, HAS BEEN CORRECTLY DRAWN TO THE DESIGNATED SCALE FROM FIELD NOTES OF A SURVEY MADE UNDER MY SUPERVISION AND DIRECTION BETWEEN THE 25TH. DAY OF AUGUST AND THE 31ST. DAY OF AUGUST, 1976. THAT IT TRULY AND CORRECTLY REPRESENTS THE LOCATION AND EXTENT OF THE WORKS USED TO DIVERT WATER FROM THE LAS VEGAS VALLEY WATER BASIN IN CLARK COUNTY BY THE CITY OF LAS VEGAS, NEVADA FOR RECREATION PURPOSES UNDER APPLICATION No. 26697. THAT THE POINT OF DIVERSION, THE LOCATION AND SIZE OF THE DIVERTING CONDUIT, THE LOCATION AND EXTENT OF LANDS OWNED OR CONTROLLED BY THE APPLICANT UPON WHICH WATER APPLIED FOR UNDER APPLICATION No. 26697 IS USED, TOGETHER WITH THE AREA AND KIND OF CULTURE IN EACH 40-ACRE SUB-DIVISION, AND THE LOCATION AND NAMES OF ALL OTHER WORKS OR STREAMS WHICH ARE CROSSED BY OR CONNECTED WITH SAID WORKS ARE FULLY AND CORRECTLY DESIGNATED THEREON.

Warren L. Jaubert
STATE WATER RIGHTS SURVEYOR, No. 326


SUBSCRIBED AND SWORN TO BEFORE ME THIS 16 DAY OF September, 1976

V. Fay Flanigan
NOTARY PUBLIC IN AND FOR CLARK COUNTY, NEVADA

MY COMMISSION EXPIRES Jan 27, 1979

BASIS OF BEARING

THE WEST LINE OF SECTION 30, T.20 S., R.61 E., M.D.B. & M., ASSUMED TO BE NORTH FROM ORIGINAL APPLICATIONS 8173 AND 9940.

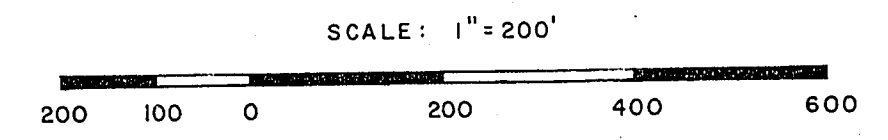

CITY OF LAS VEGAS, NEVADA
ENGINEERING DEPT.

MAP TO ACCOMPANY
PROOF OF BENEFICIAL USE UNDER
APPLICATION NO. 26697
FOR RECREATION
BY THE CITY OF LAS VEGAS, NEVADA
FROM LAS VEGAS VALLEY WATER BASIN