




6TH FLOOR
 C. 927 S.Y.
 T. 76 S.Y.

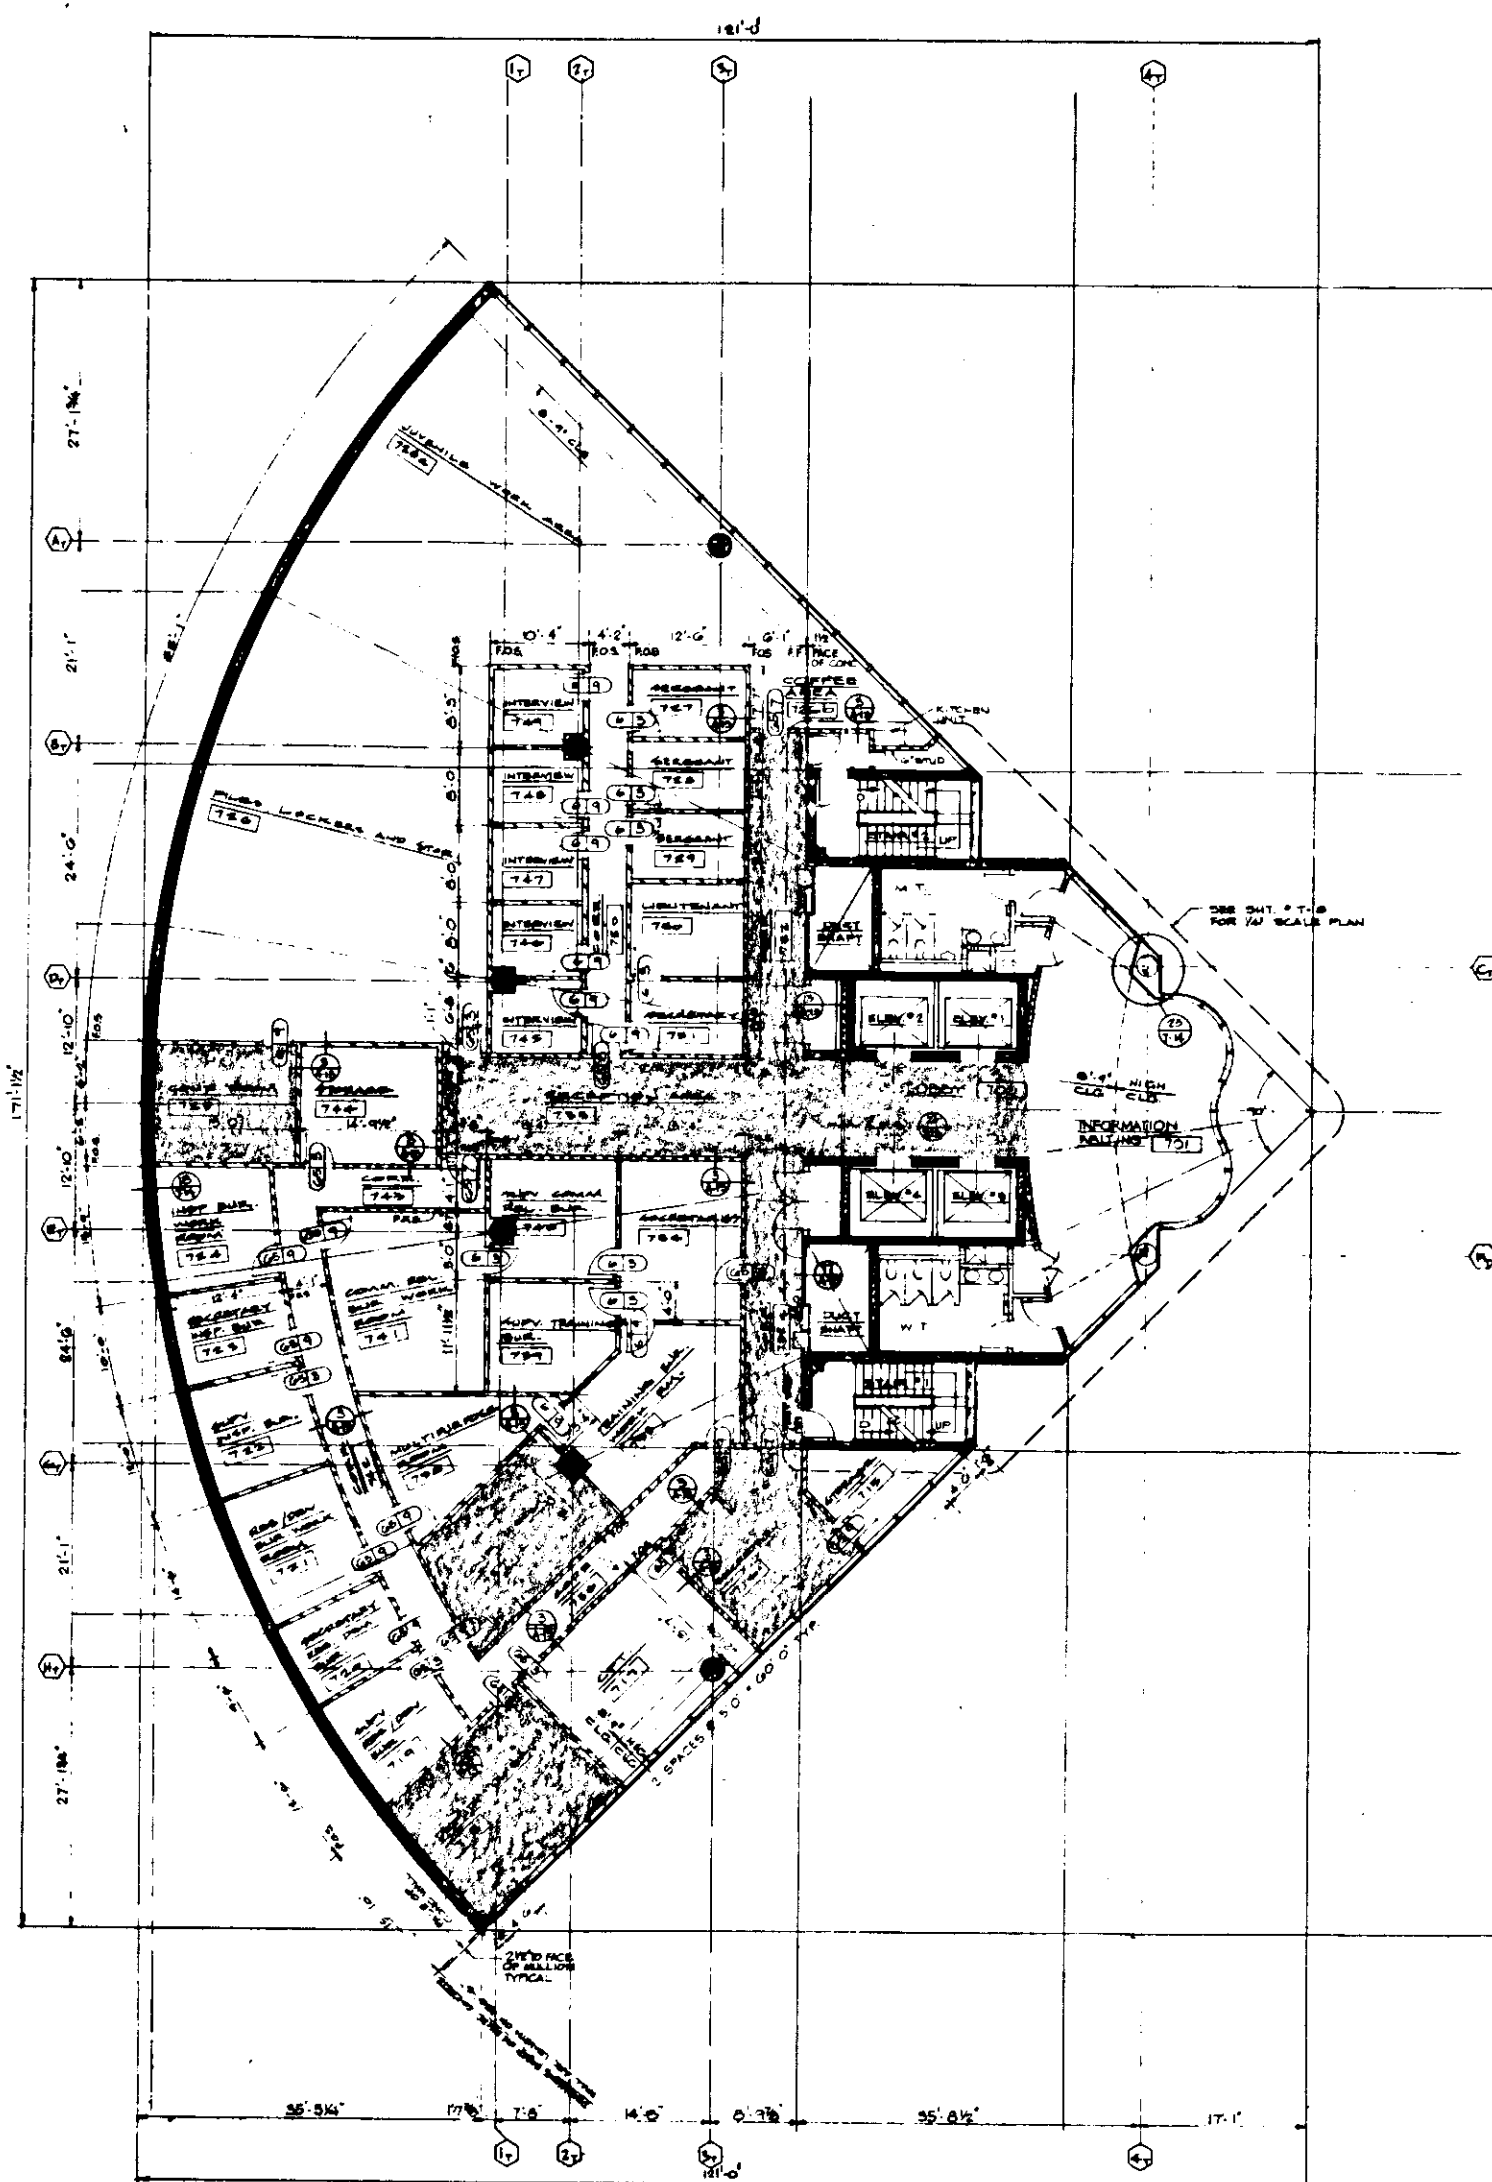


7TH FLOOR
 C. 290 S.Y.
 T. 713 S.Y.

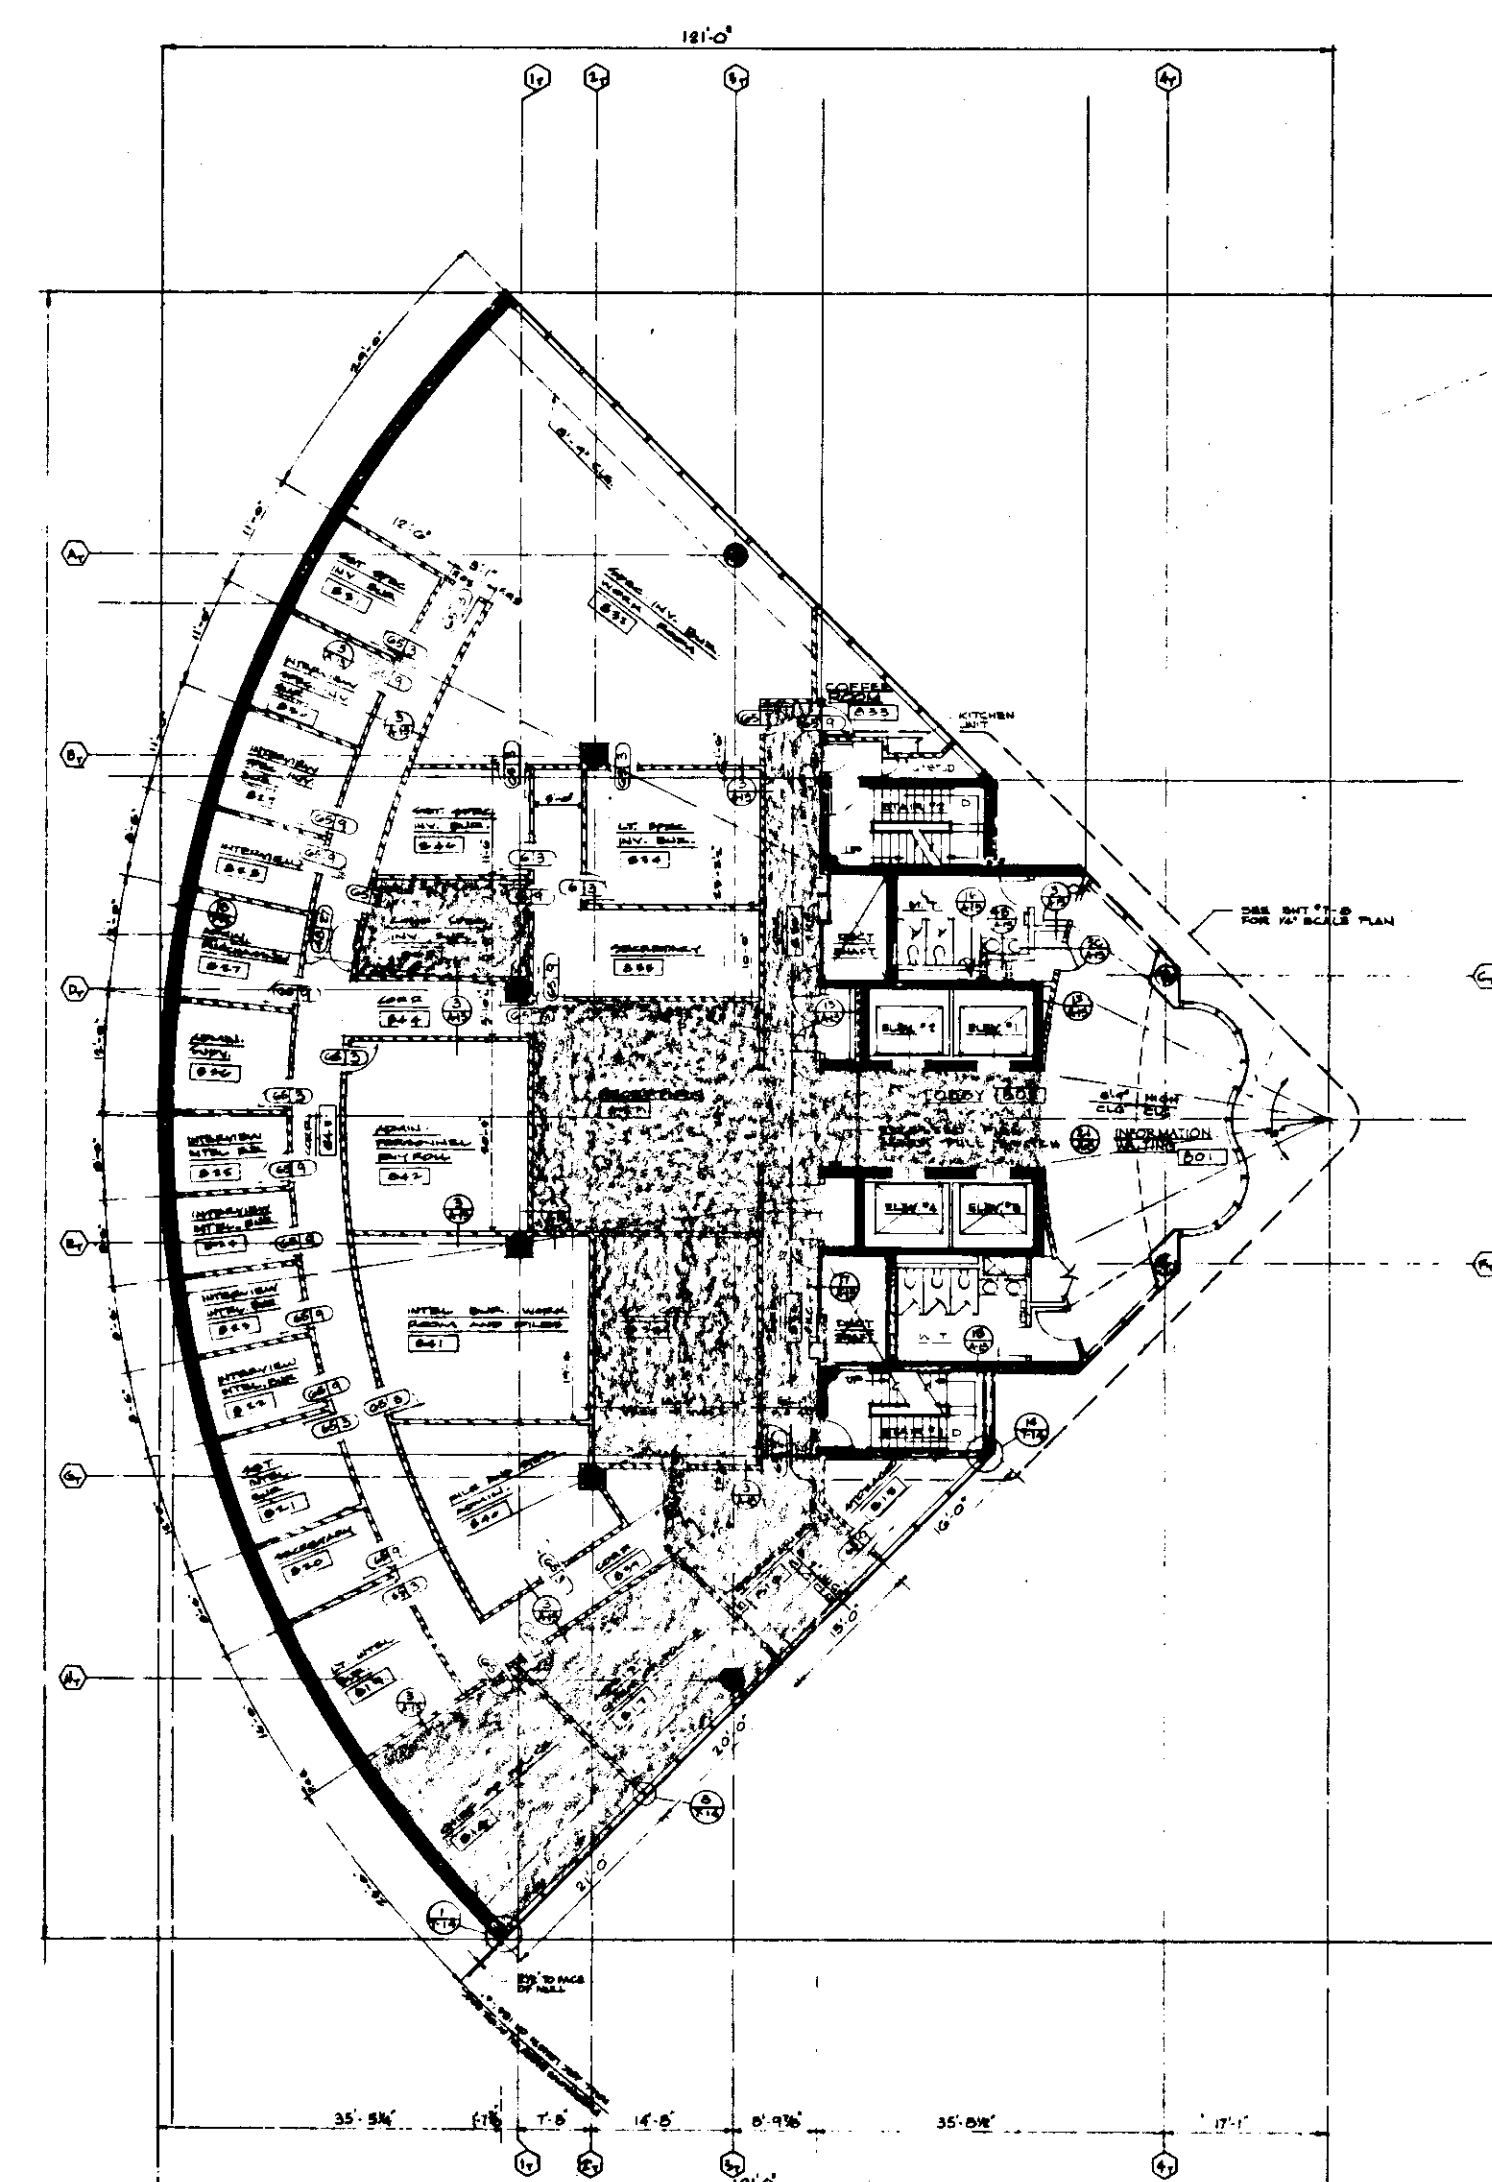

8TH FLOOR
 C. 321 S.Y.
 T. 682 S.Y.

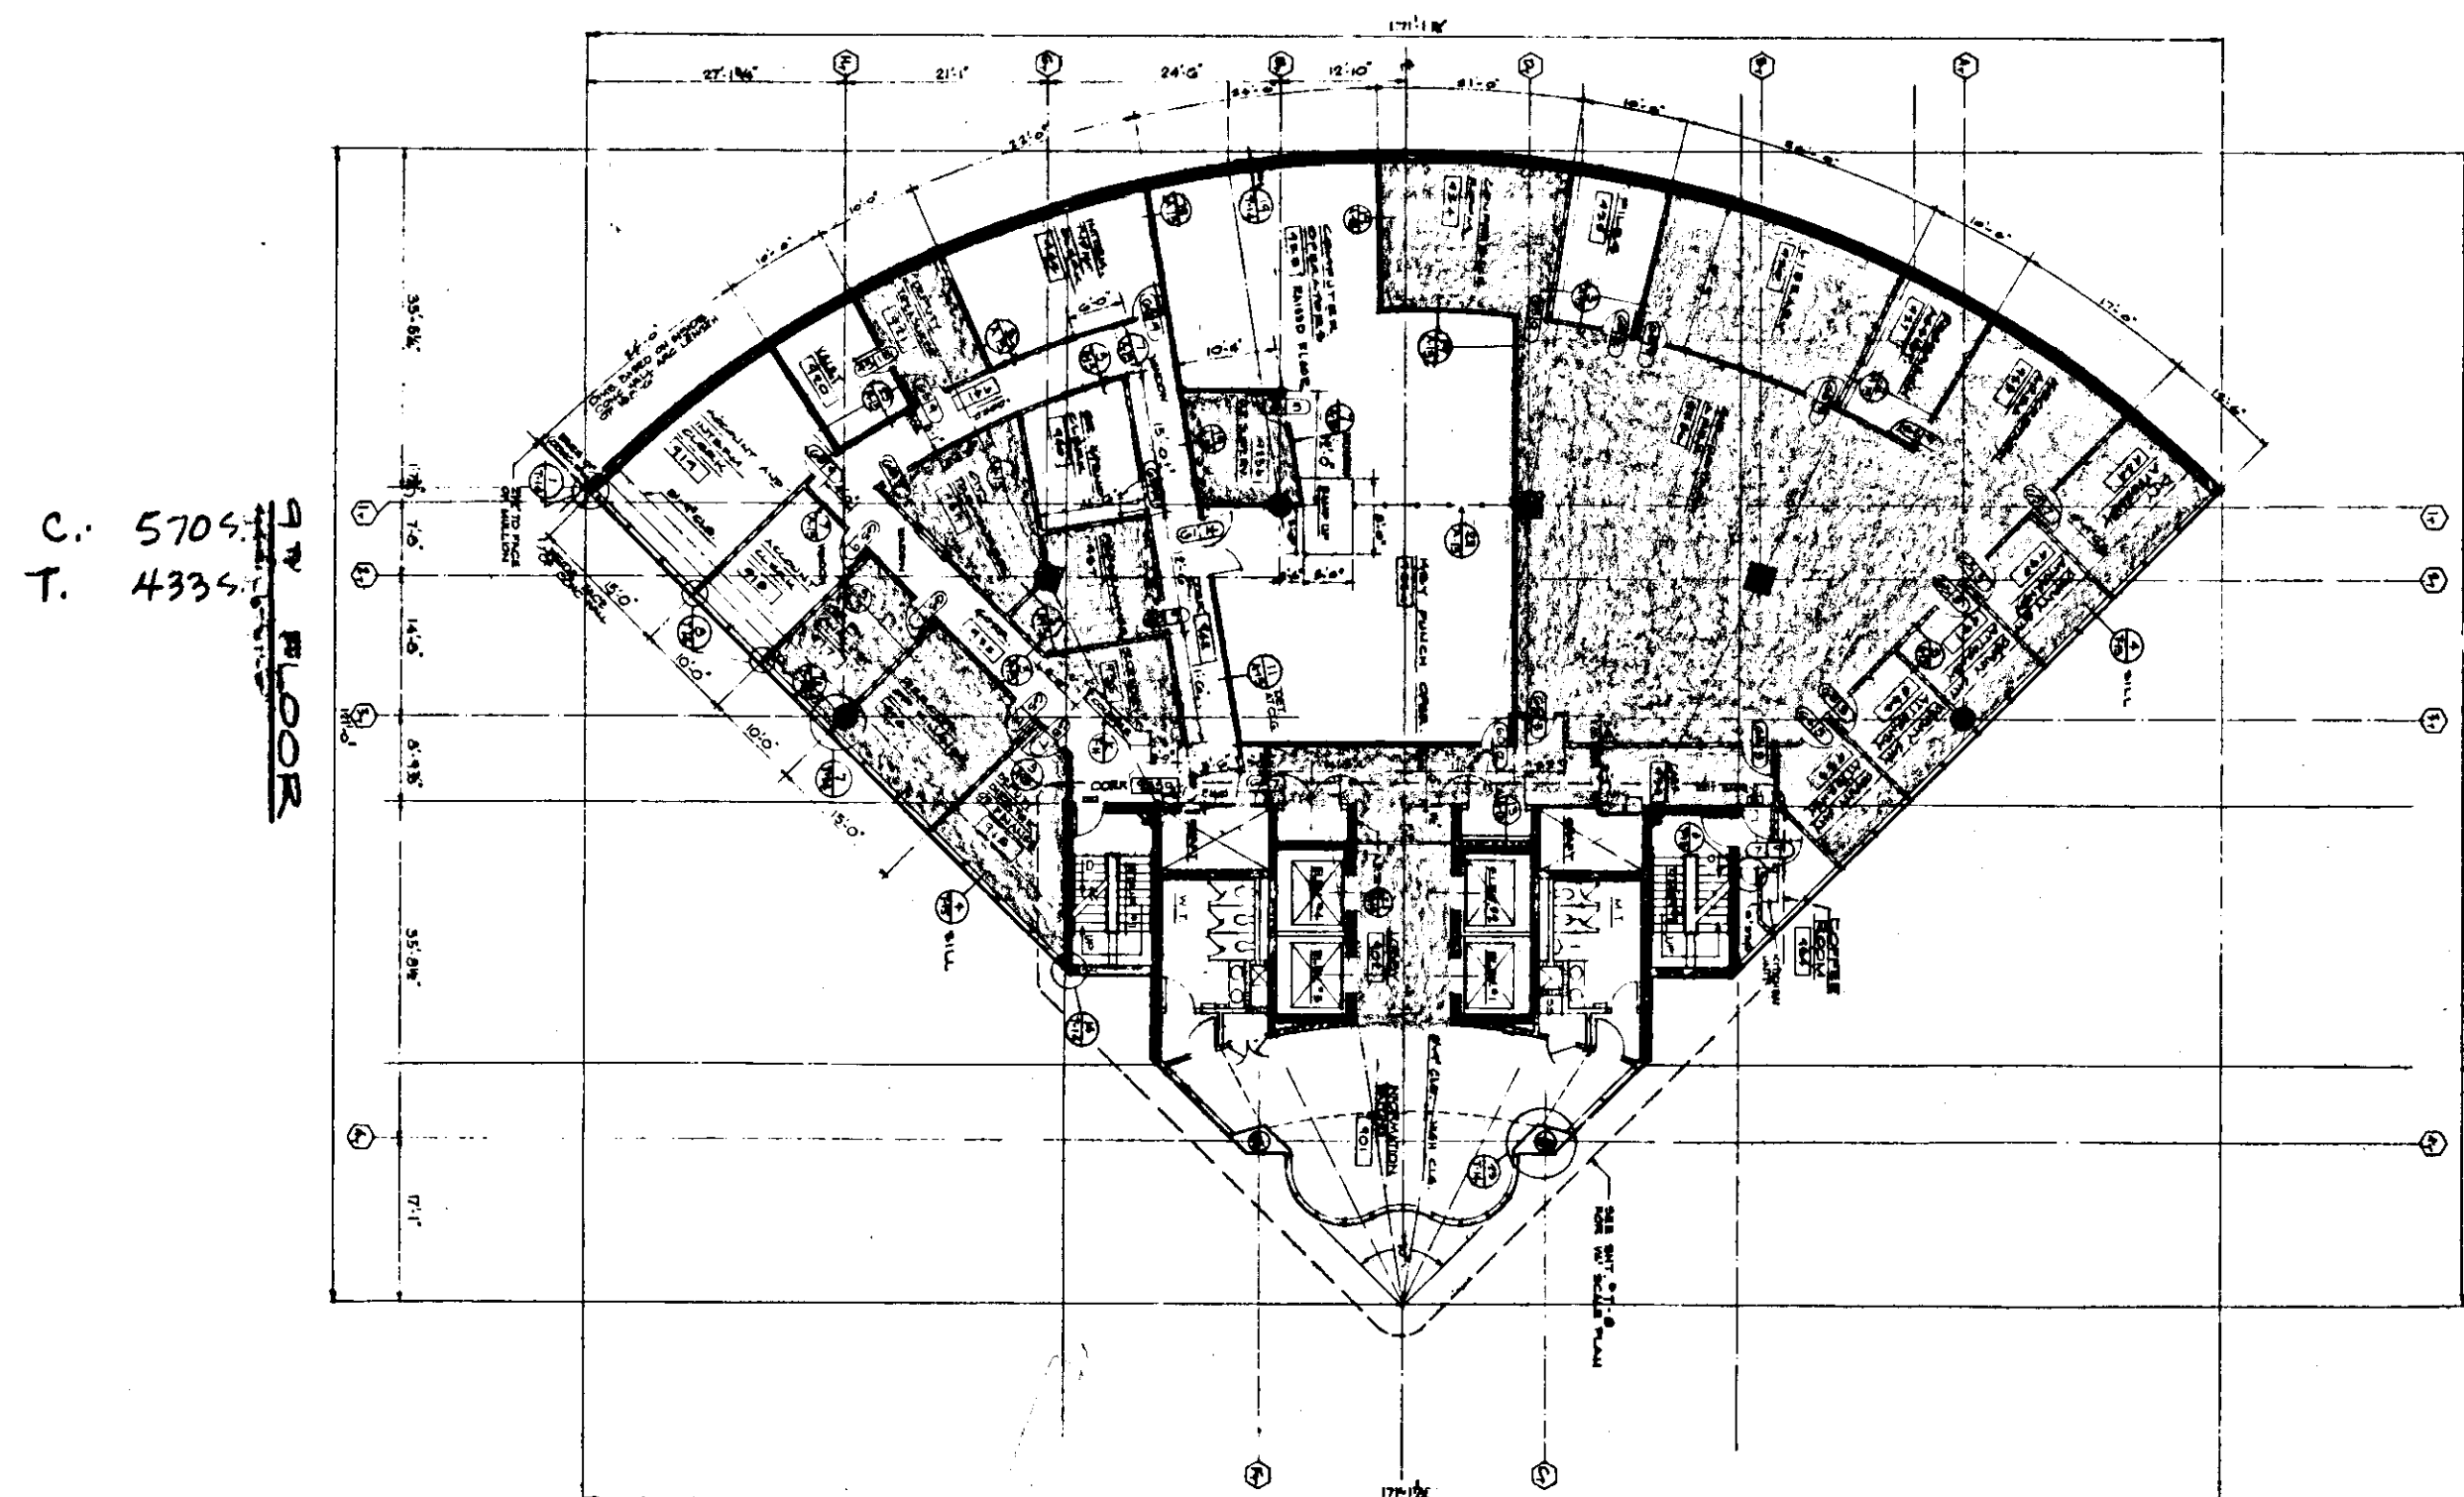

9TH FLOOR
 C. 570 S.Y.
 T. 433 S.Y.

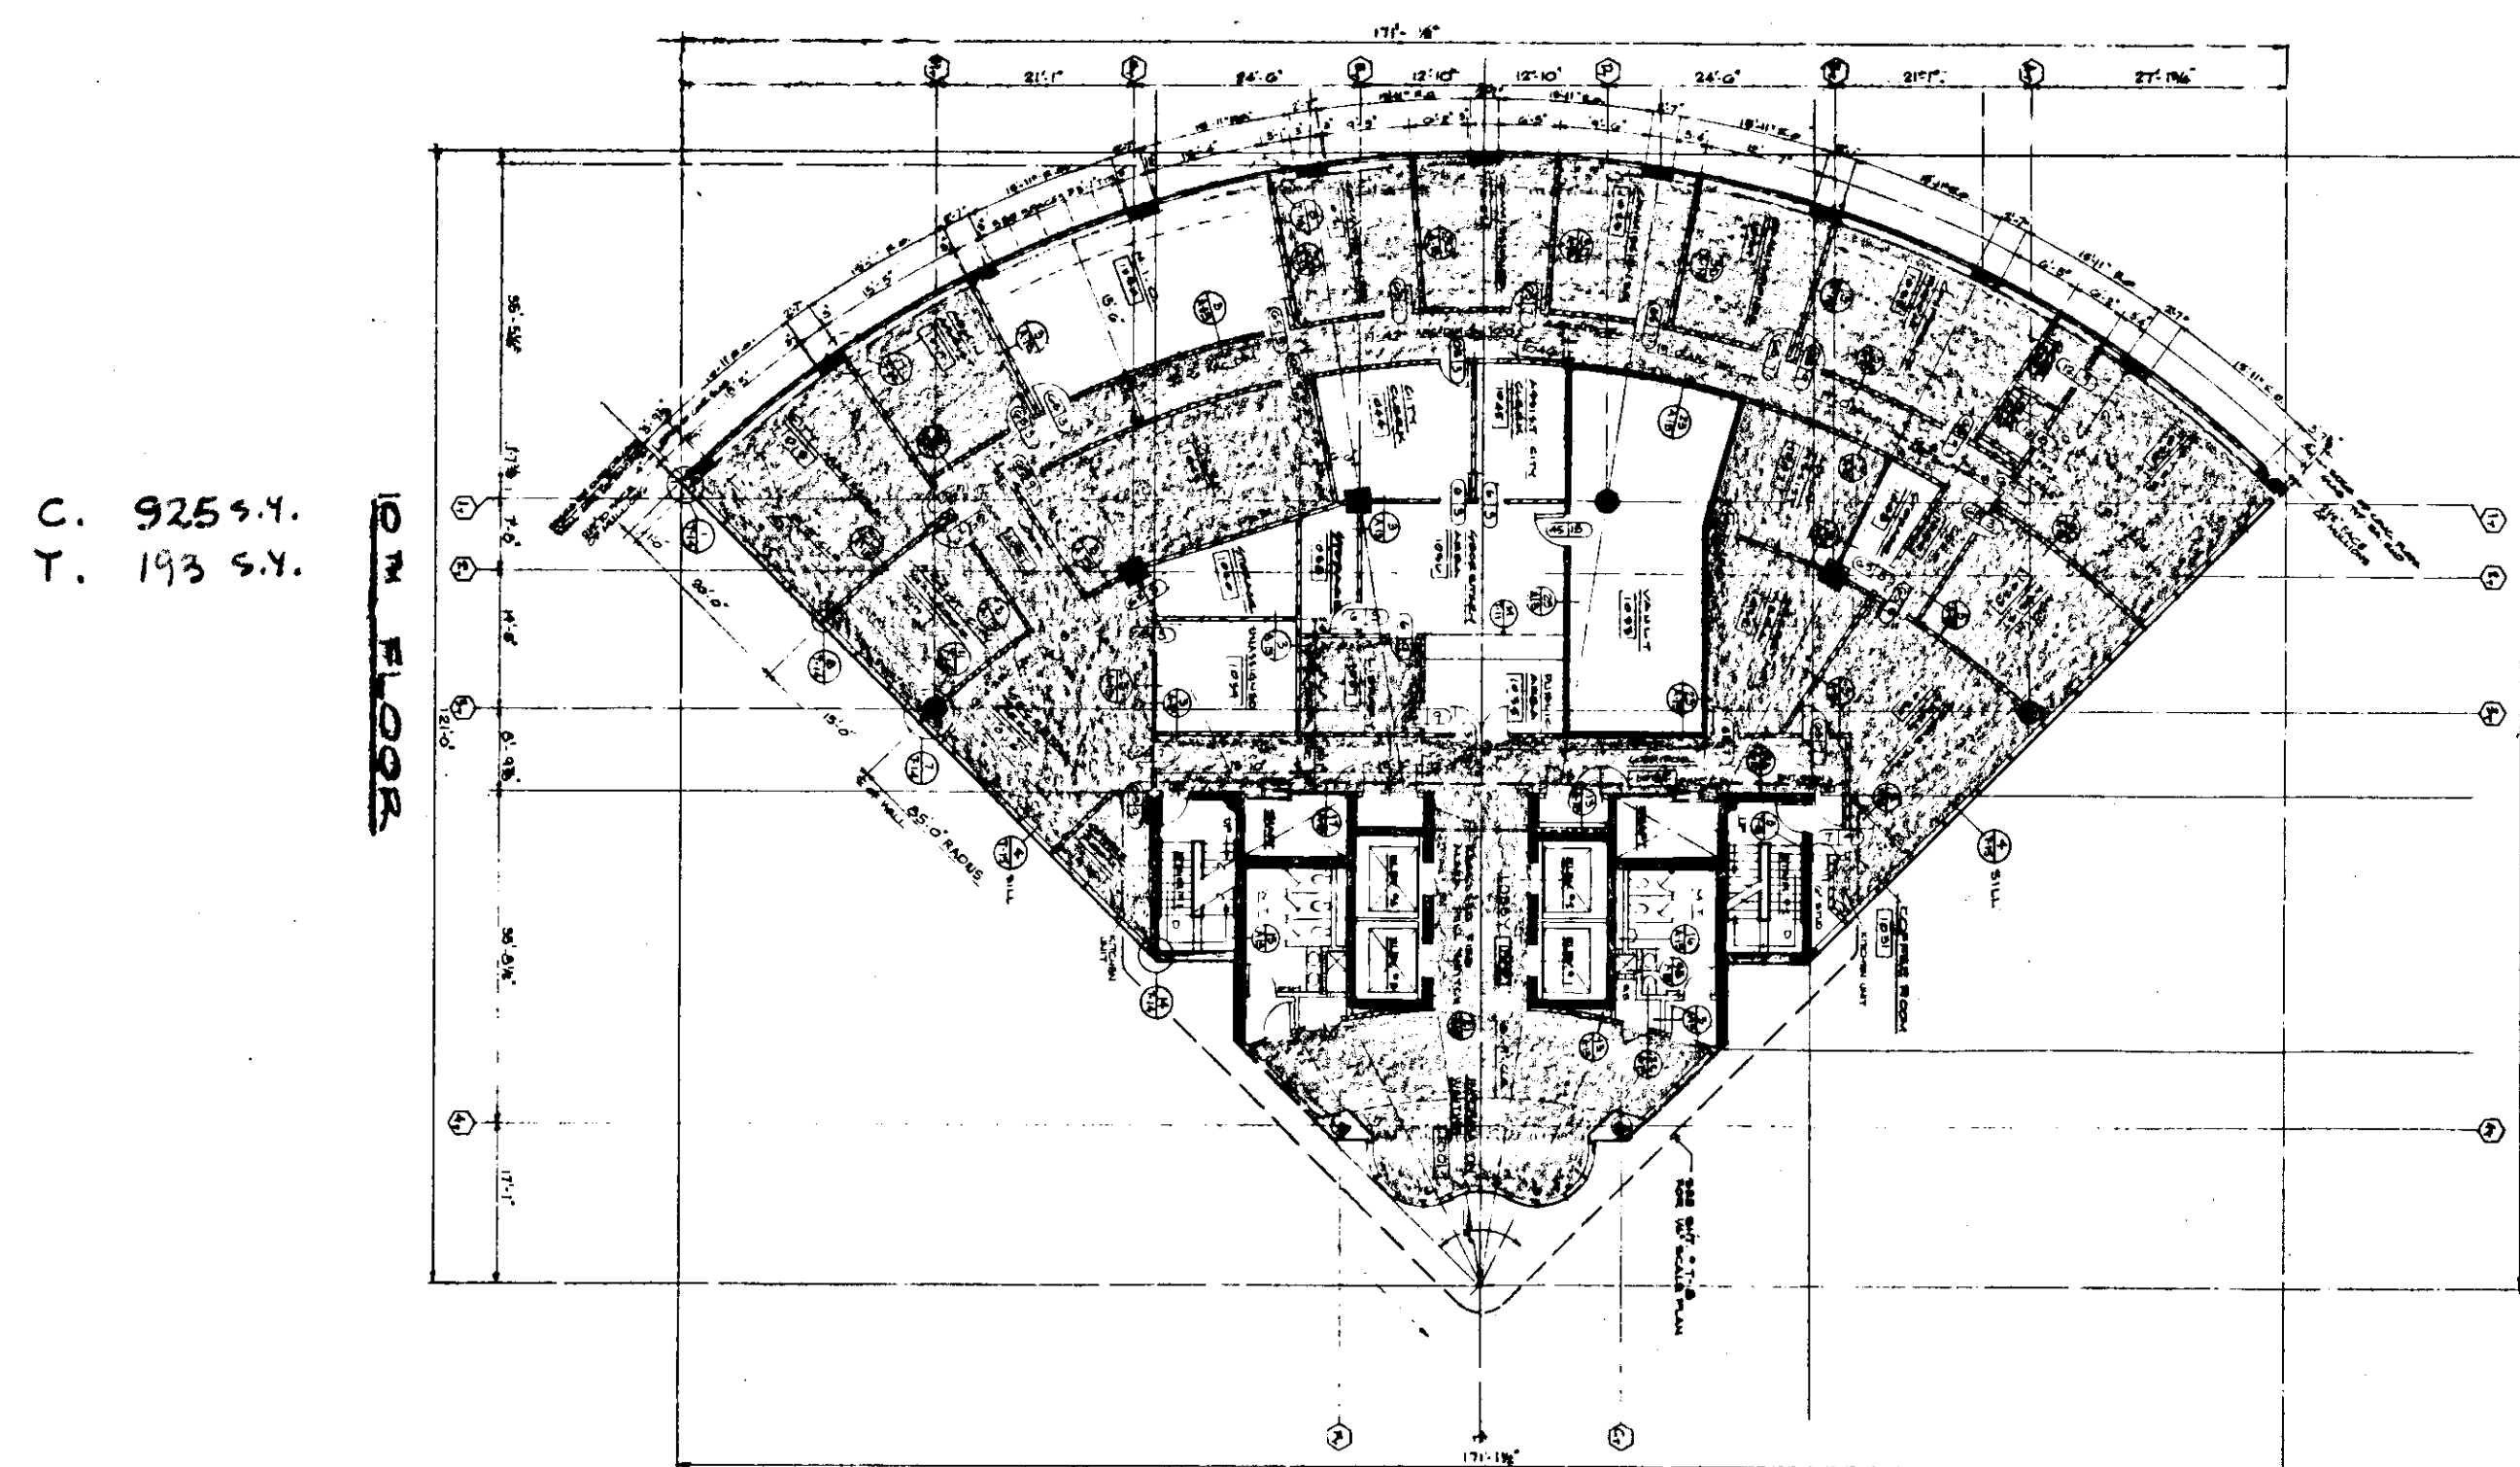

10TH FLOOR
 C. 925 S.Y.
 T. 193 S.Y.

REVISED 2-24-72

521-844