


P.A. RISER J. BOX
F.A. RISER J. BOX

△ INDICATES NEW ADDITION

4TH FLOOR FIRE ALARM


SCALE: 1/8" = 1'-0"

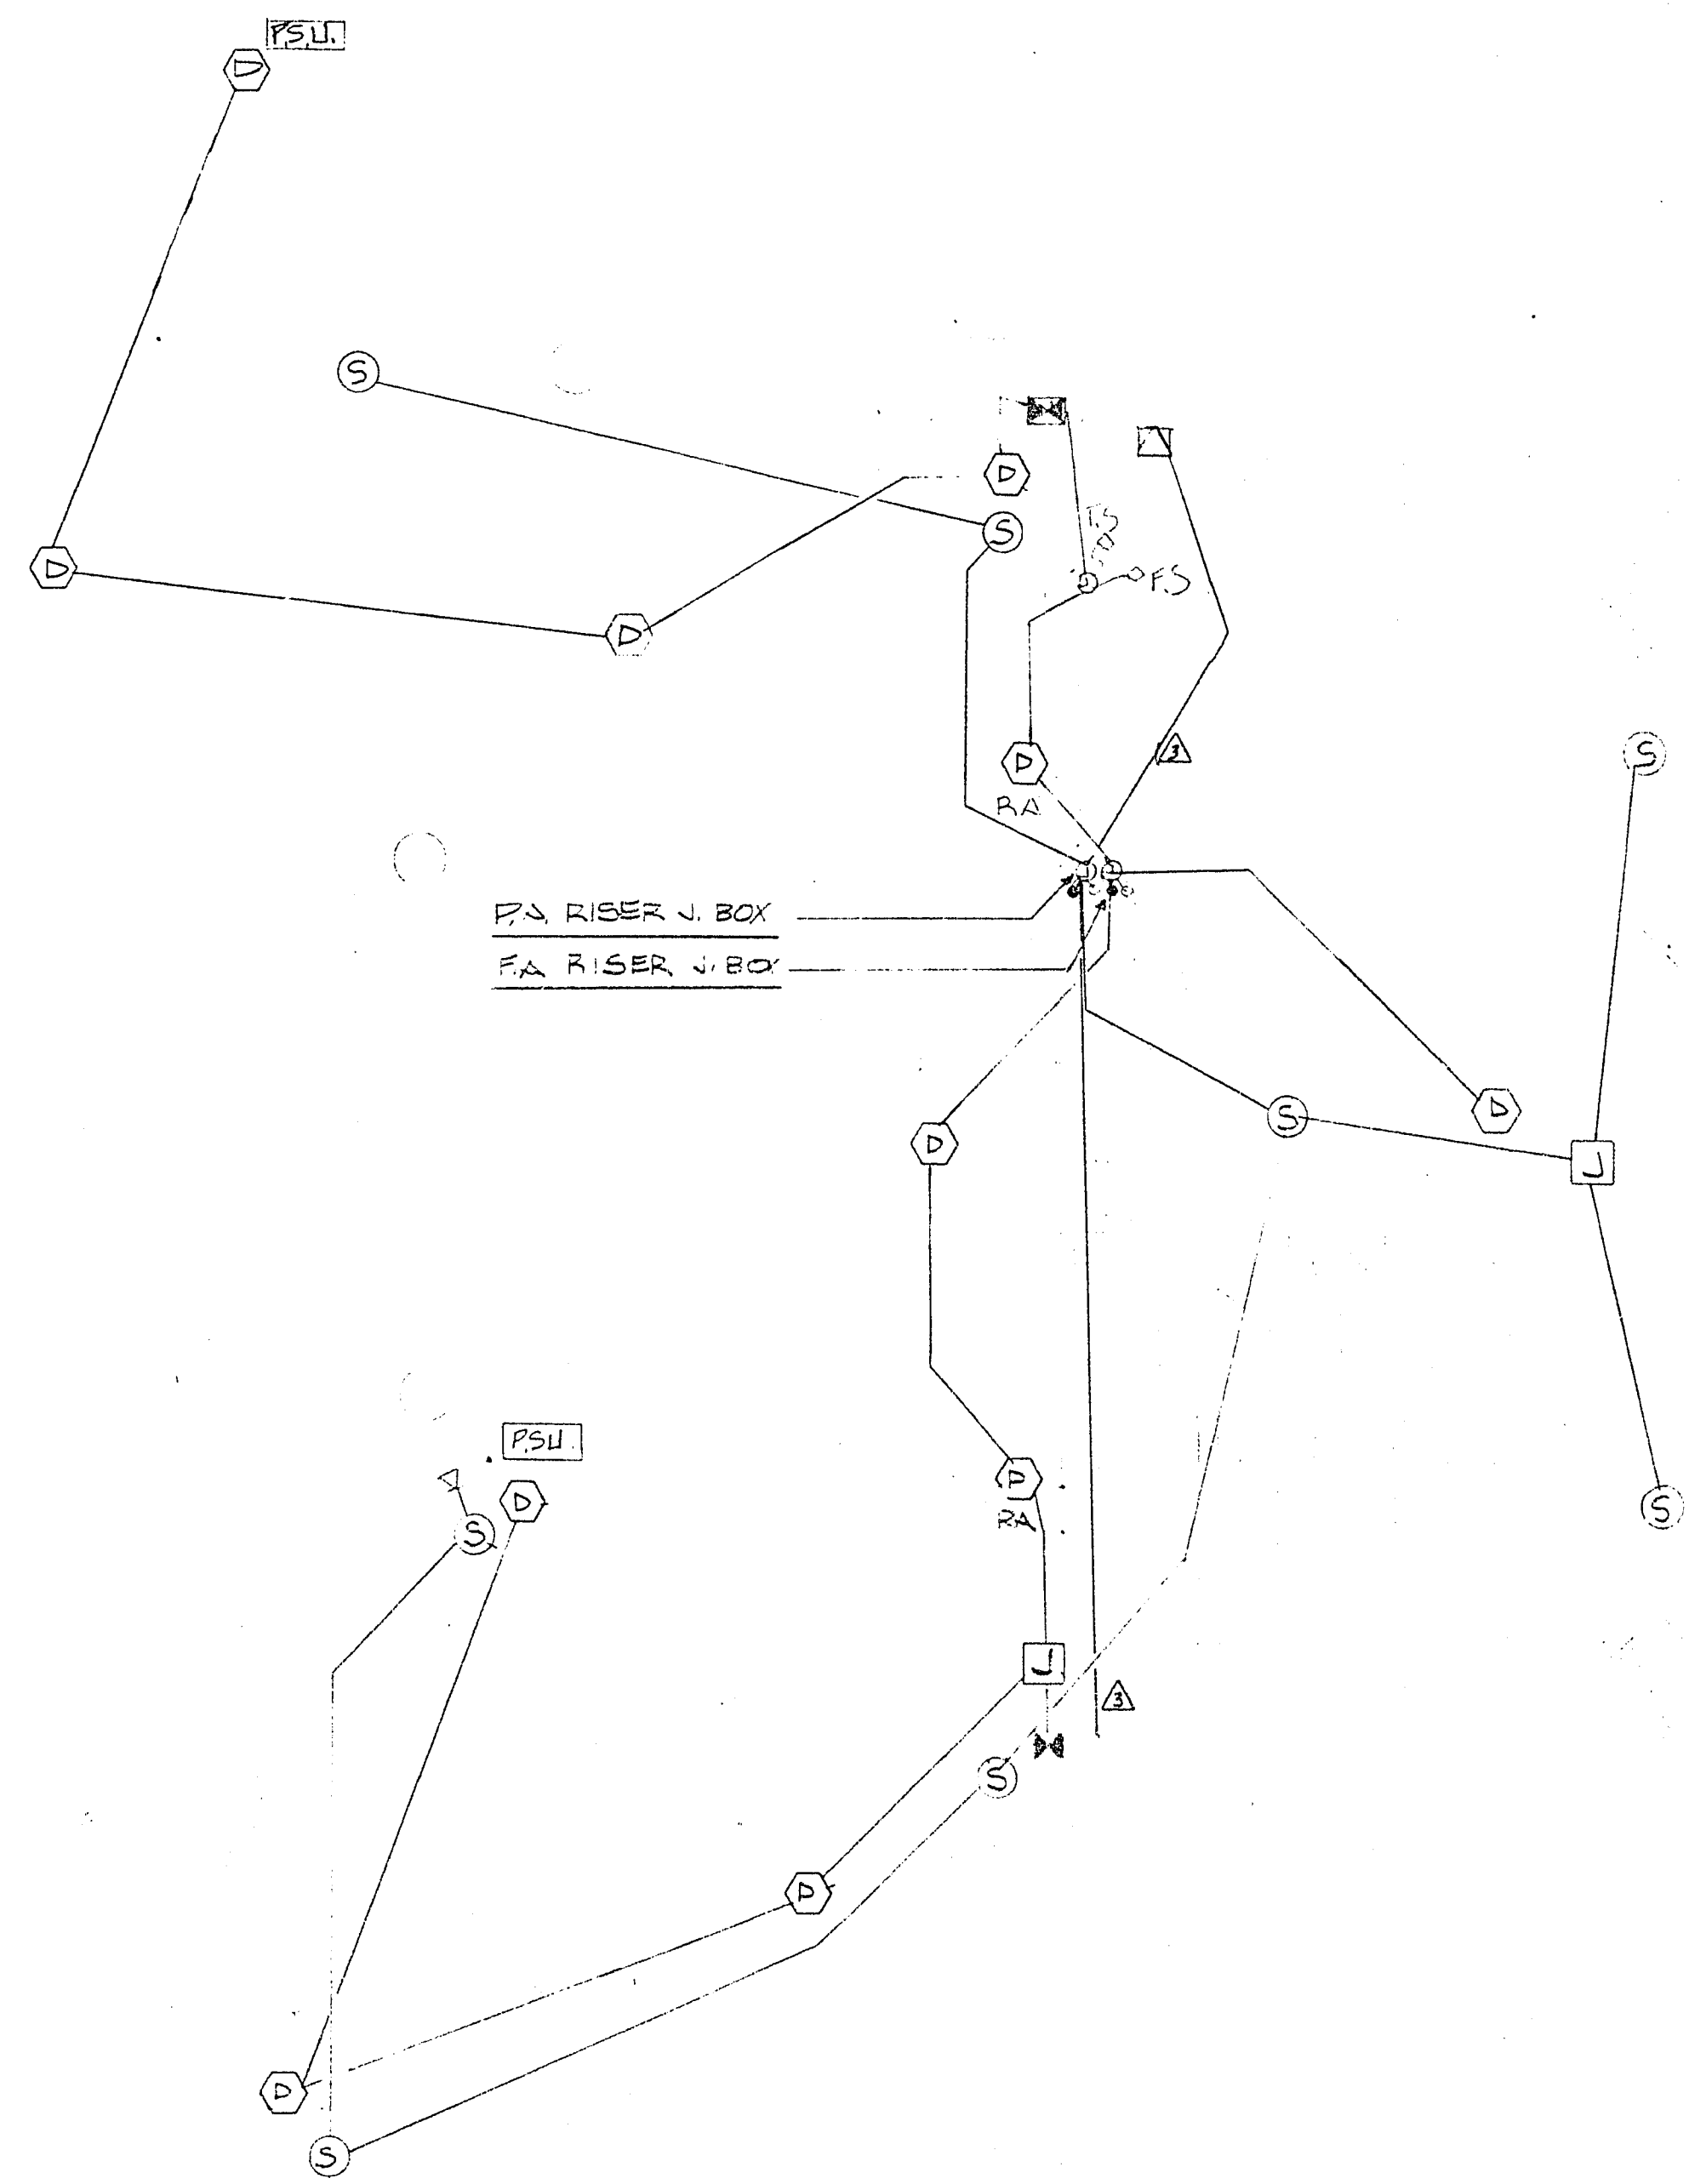

P.A. RISER J. BOX
F.A. RISER J. BOX

3RD FLOOR FIRE ALARM


SCALE: 1/8" = 1'-0"

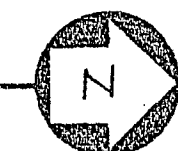

CITY HALL RETROFIT
3RD & 4TH FLOOR FIRE ALARM

Scale: 1/8" = 1'-0"
Date: 10-10-82

Drawing No:
4084-006

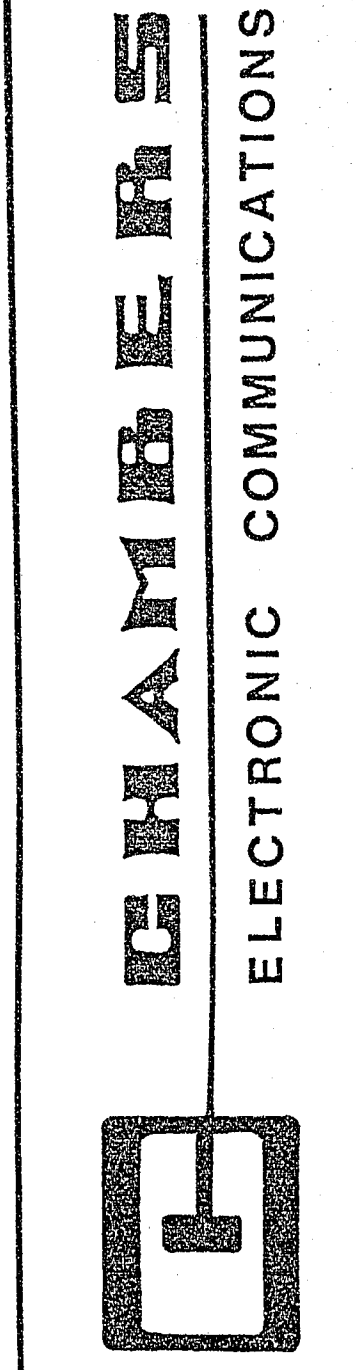

CHAMBERS
ELECTRONIC COMMUNICATIONS

Drawn By: A. STUBBER

REVISED 2-10-83
REVISED 3/3/83
REVISED 3/14/83
CMB/BJB 8/1/83