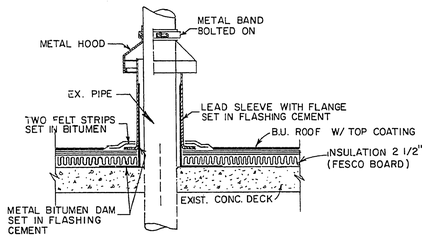

FLASHING DETAIL FIRE STAND PIPE

NOT TO SCALE

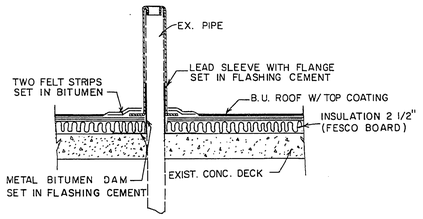

FLASHING VENT PIPE DETAIL

NOT TO SCALE

APPROXIMATE QUANTITIES			
ITEM	DESCRIPTION	UNIT	QUANTITY
	REMOVE EXIST. ROOFING	S. F.	6,950
	INSTALL ROOF INSULATION	S. F.	6,950
	INSTALL BUILT-UP ROOFING	S. F.	6,950
	REPAIR WALL FLASHING	L. F.	514
	TRAFFIC PADS (40 EA.) (2'x3')	S. F.	240
	TRAFFIC PADS (20 EA.) (4'x4')	S. F.	320

TAR PITCH BOX (20EA.) AROUND SOCKET FOR WINDOW WASHING EQUIPMENT SHALL BE REMOVED. EXISTING THREADED BOLTS (80EA.) PROTRUDING UP TO 4" ABOVE DECK SHALL BE CUT TO 2 1/2" ABOVE CONCRETE DECK, CLEANED, DE-RUSTED, GREASED AND TAPED. EXIST. NUTS SHALL BE DISCARDED.

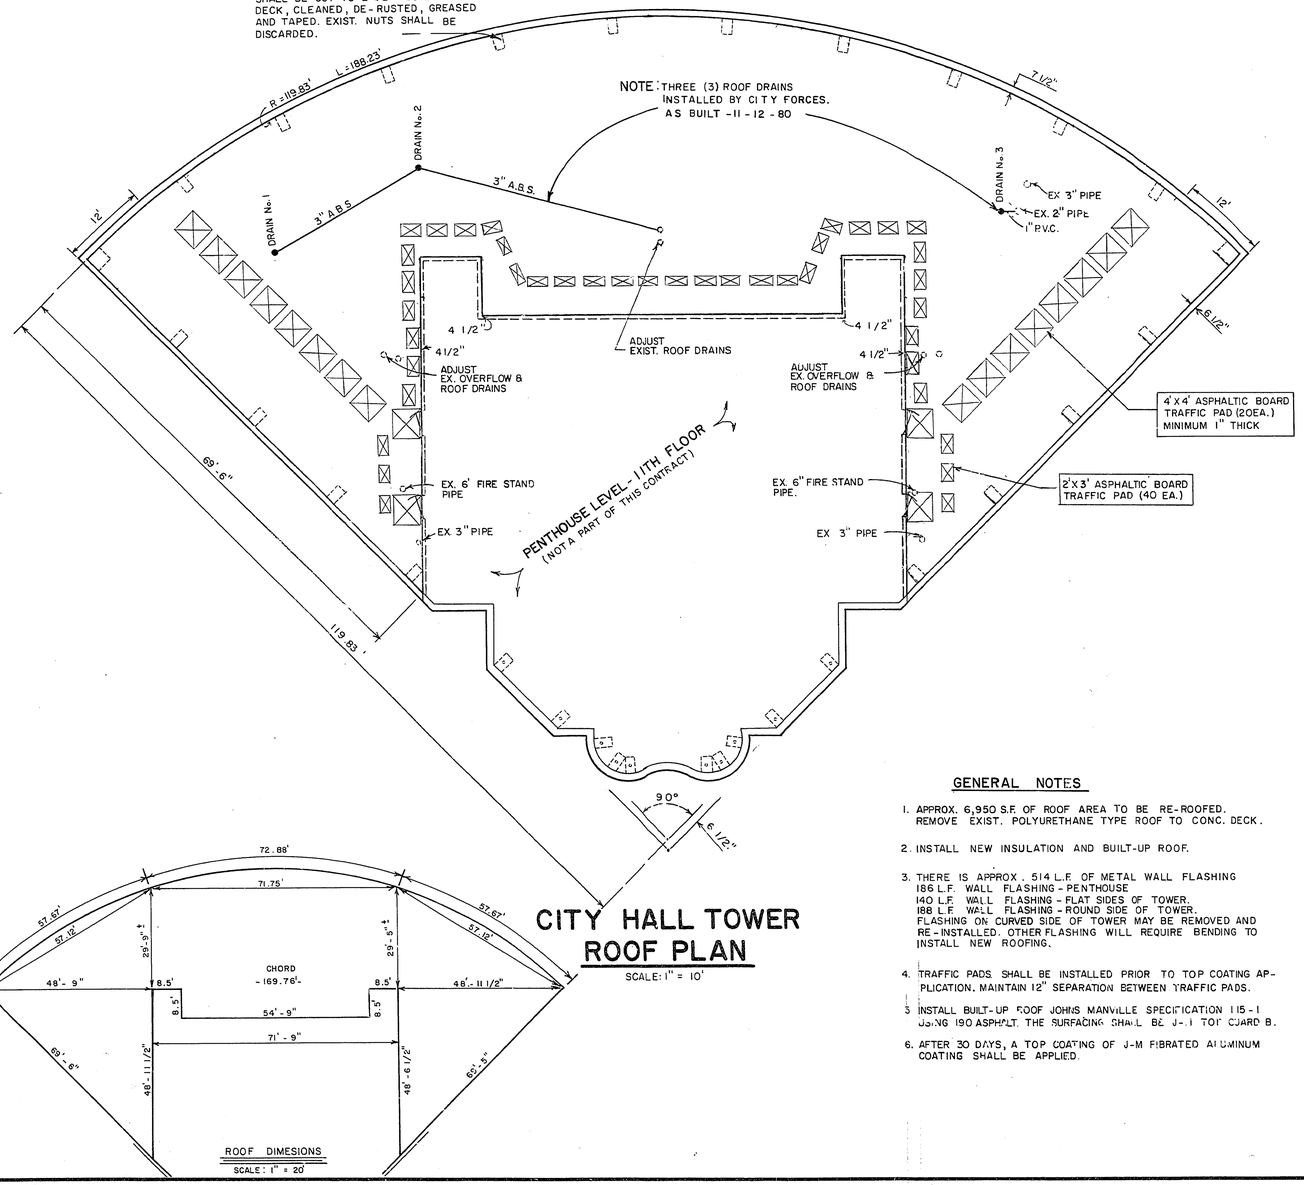

CITY HALL TOWER ROOF PLAN

SCALE: 1" = 10'

ROOF DIMESIONS

SCALE: 1" = 20'

GENERAL NOTES

1. APPROX. 6,950 S.F. OF ROOF AREA TO BE RE-ROOFED. REMOVE EXIST. POLYURETHANE TYPE ROOF TO CONC. DECK.
2. INSTALL NEW INSULATION AND BUILT-UP ROOF.
3. THERE IS APPROX. 514 L.F. OF METAL WALL FLASHING
   186 L.F. WALL FLASHING - PENTHOUSE
   140 L.F. WALL FLASHING - FLAT SIDES OF TOWER.
   188 L.F. WALL FLASHING - ROUND SIDE OF TOWER.
   FLASHING ON CURVED SIDE OF TOWER MAY BE REMOVED AND RE-INSTALLED. OTHER FLASHING WILL REQUIRE BENDING TO INSTALL NEW ROOFING.
4. TRAFFIC PADS SHALL BE INSTALLED PRIOR TO TOP COATING APPLICATION. MAINTAIN 12" SEPARATION BETWEEN TRAFFIC PADS.
5. INSTALL BUILT-UP ROOF JOHNS MANVILLE SPECIFICATION 115-1 USING 190 ASPHALT. THE SURFACING SHALL BE J-M TOP GUARD B.
6. AFTER 30 DAYS, A TOP COATING OF J-M FIBRATED ALUMINUM COATING SHALL BE APPLIED.

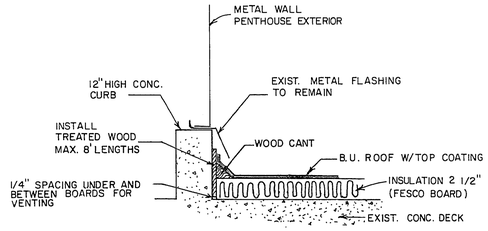

TYPICAL - FLASHING DETAIL - PENTHOUSE WALL

NOT TO SCALE

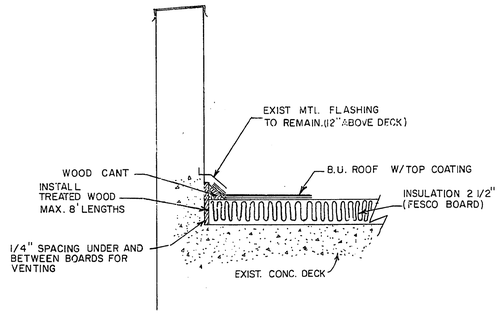

TYPICAL - FLASHING DETAIL - OUTER WALLS

NOT TO SCALE

CONTRACT DRAWING
MAY 9 1980

Revisions	Date

W.A. 2033

Scale (v)

Scale (h) 1" = 100'

Fld. bk. no. ——

Date 3-14-80

Design by D. MCGONEGLE

Drawn by J. MCDOWELL

Department of Public Services
Engineering Design Division

CITY HALL TOWER REROOFING

CITY HALL

CITY OF LAS VEGAS CLARK COUNTY NEVADA

Drawing no. 521.136 1/1

BID No. 80.3550.33