

**FLOOR PLAN**  
SCALE: 1/8" = 1'-0"


SEATING TO BE PROVIDED & INSTALLED BY OTHERS. COORDINATE WORK WITH SEATING CONTRACTOR FOR PROPER INSTALLATION.

**CONGDON ASSOCIATES**  
architecture & planning & interiors  
3311 south jones boulevard, suite 212a  
las vegas, nevada, 89102 702-382-3990

REVISIONS:  
02/19/91  
03/20/91  
04/13/91

DRAWING TITLE: FLOOR PLAN

PROJECT: CITY COUNCIL CHAMBERS renovation

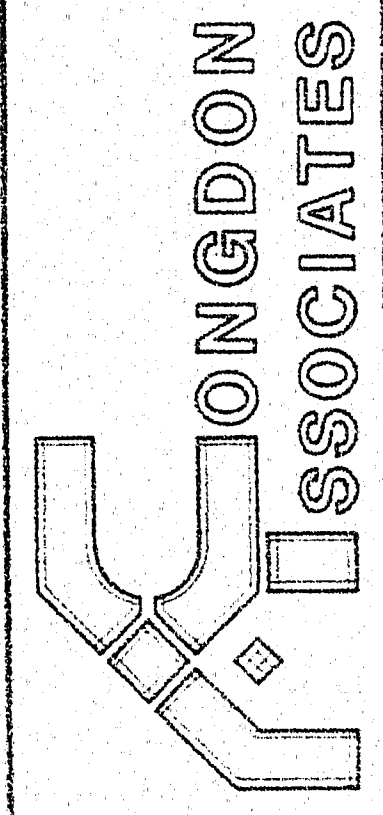

PROJECT: 9019  
DATE: JAN. 21, 1991

DRAWING NO.:  
**A2.1**

**PROJECT RECORD**  
5/29/91