



DOOR SCHEDULE

DOOR NO.	KEYSIDE ROOM	TO ROOM	TYPE	DOOR MAT'L	SIZE	FRAME MAT'L	HOWE SET NO.	LABEL	REMARKS
001	OUTSIDE								EXISTING TO REMAIN
002	003	004	A	H.M.	6'-0"x7'-0"	H.M.	1	20MIN	R.H. ACTIVE
003	003	002	B	H.M.	3'-0"x7'-0"	H.M.	2	20MIN	
004	001	003	B	S.C.W.	4'-0"x7'-0"	H.M.W.	3	20MIN	
005	004								EXISTING TO REMAIN
006	001	005	C	H.M.	3'-0"x7'-0"	H.M.	4	20MIN	PIANO HINGE/ COVER W/MIRROR
006	006	001	A	S.C.W.	6'-0"x8'-0"	H.M.W.	5	20MIN	
009	006		B	EX	EX	EX	6	20MIN	HARDWARE ON ROOM 006 SIDE ONLY
010	OUTSIDE	006	A	do	do	do	7		
011	006		B	do	do	do	6	20MIN	do do do
012	006		B	do	do	do	6		do do do
013	006		B	do	do	do	6		do do do
014	001		B	S.C.W.	3'-0"x7'-0"	H.M.W.	8		
015	001		B	S.C.W.	3'-0"x7'-0"	H.M.W.	9		
016	OUTSIDE	007	A	EX	EX	EX	7		HARDWARE ON ROOM 007 SIDE ONLY
017	007		B	do	do	do	6	20MIN	do do do
018	007		B	do	do	do	6		do do do
019	007	001	A	S.C.W.	6'-0"x8'-0"	H.M.W.	5		
020	001	008	A	S.C.W.	6'-0"x7'-0"	H.M.W.	1		


DOOR TYPES

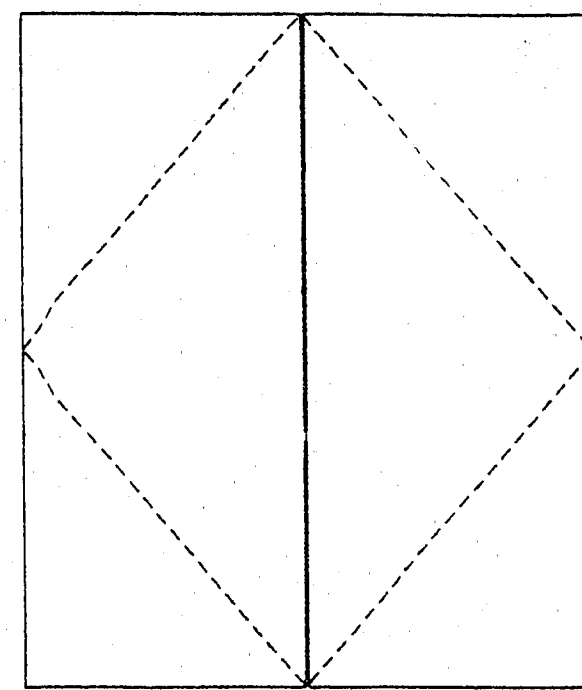

A

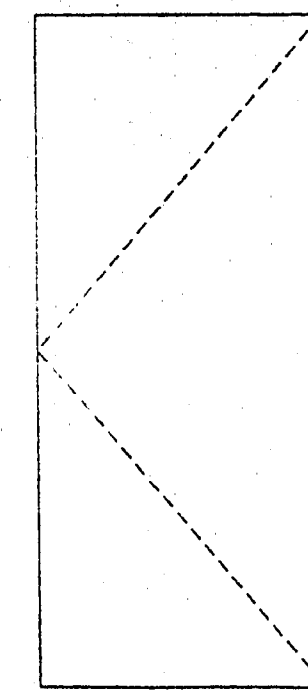

B



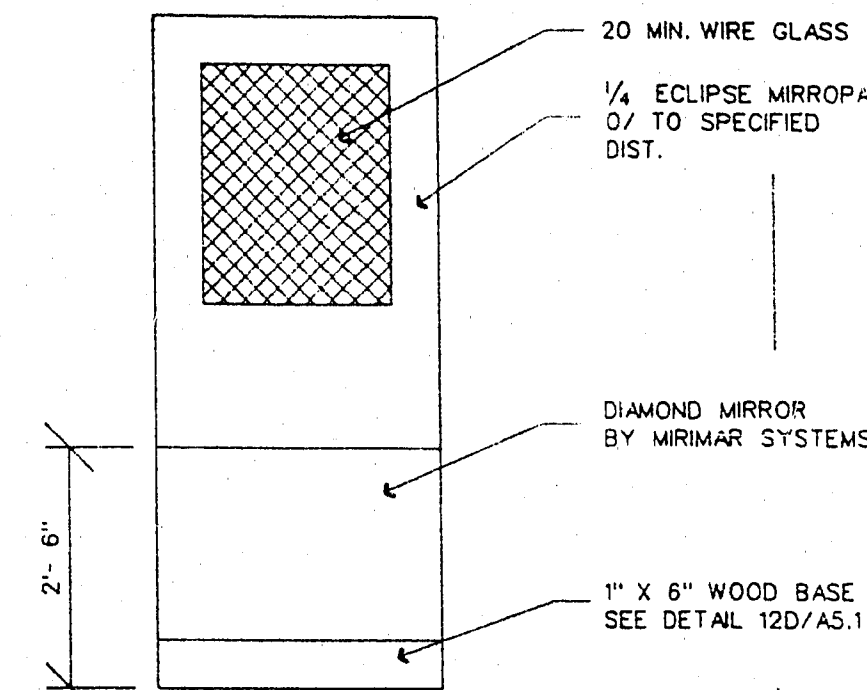


C

ABBREVIATIONS

H.M. - HOLLOW METAL
 R.H. - RIGHT HAND
 S.C.W. - SOLID CORE WOOD
 H.M.W. - HOLLOW METAL- WOOD VENEER
 EX - EXISTING
 do - DITTO


OMIT

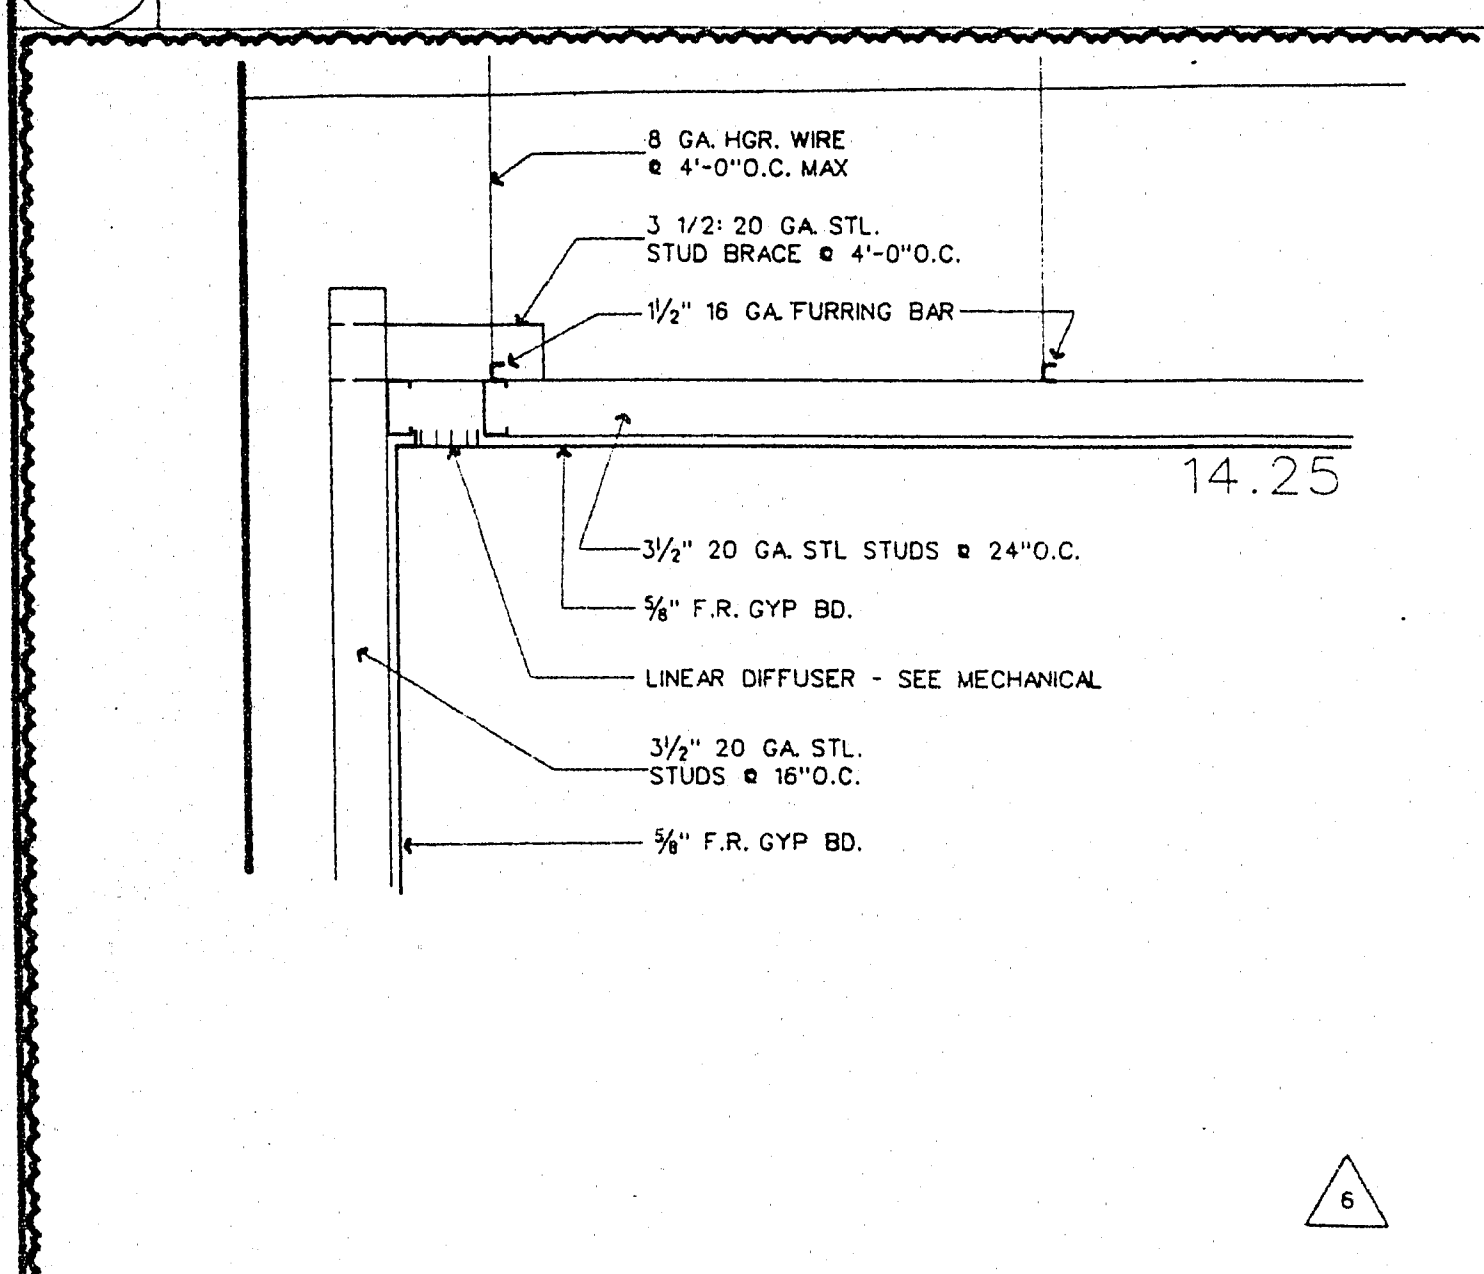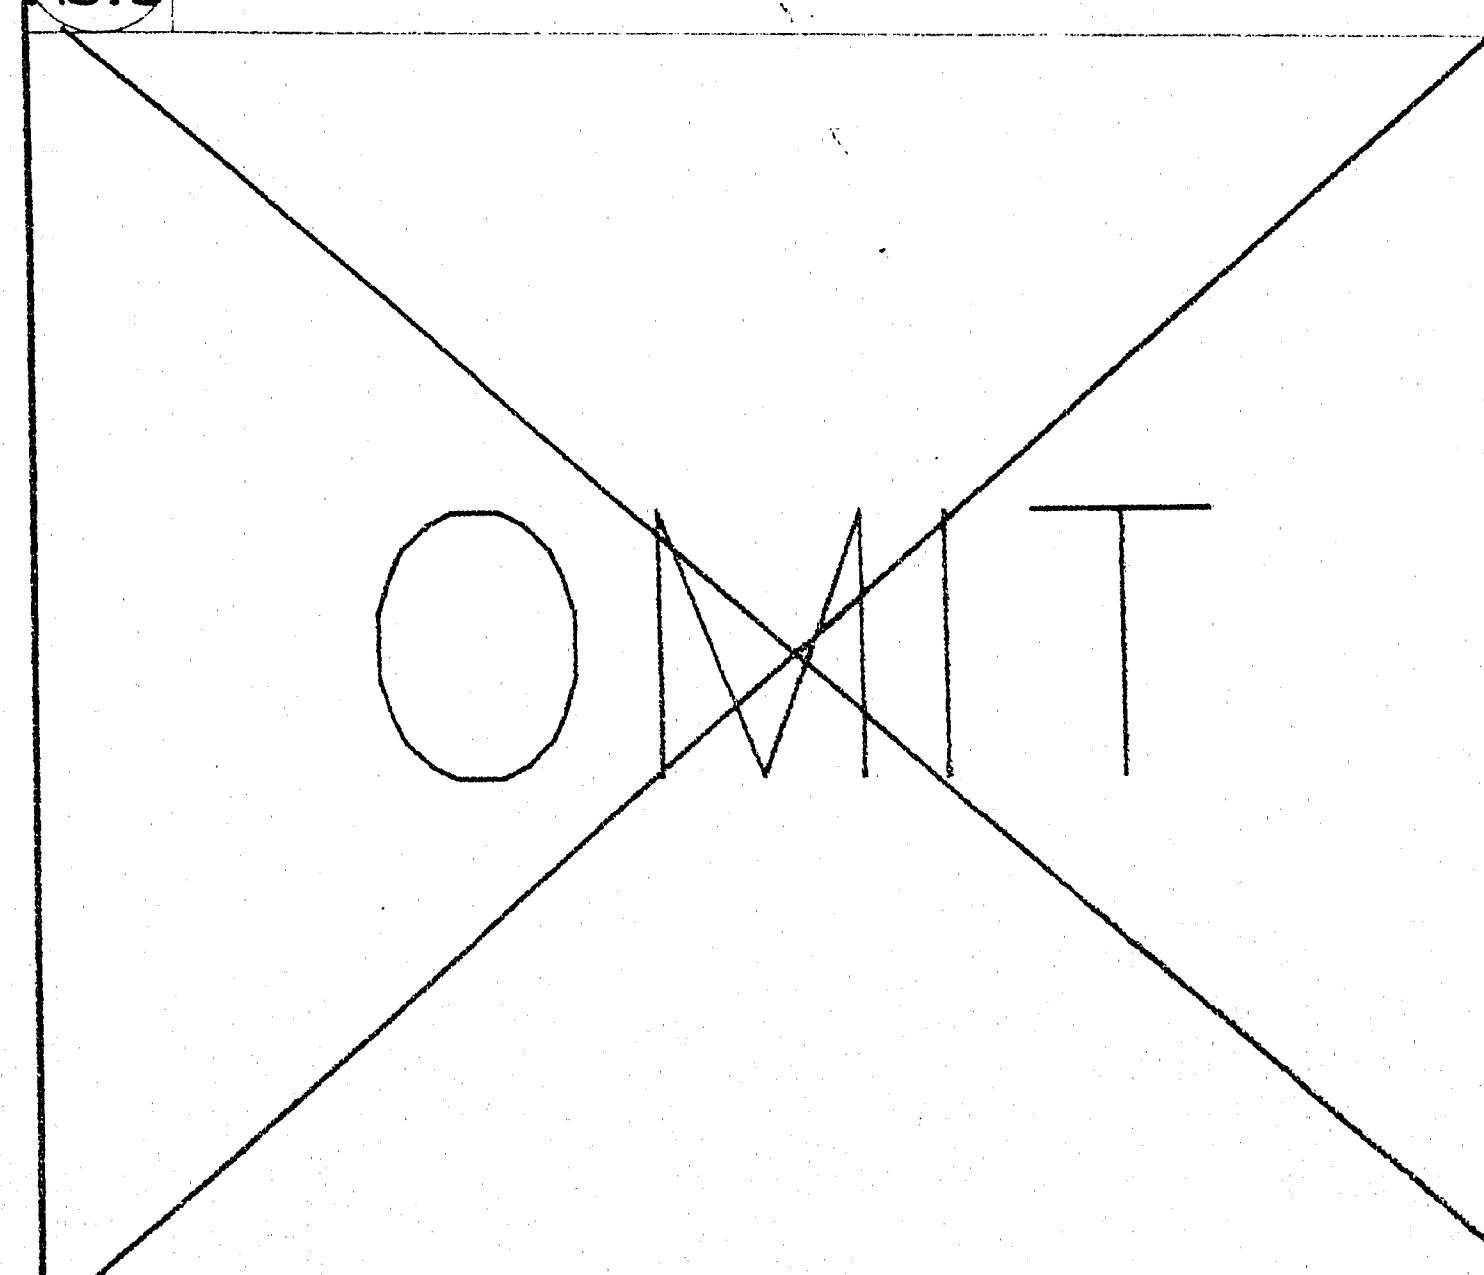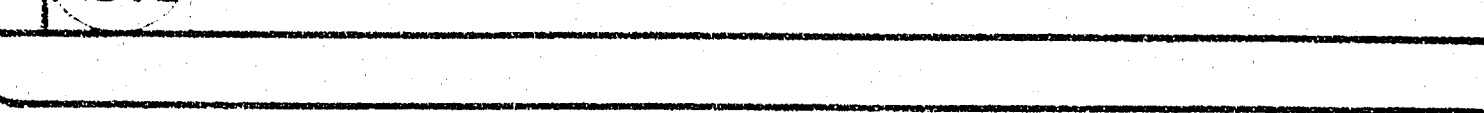1
A5.3 DETAIL5
A5.3 DETAIL9
A5.3 DETAIL

scale: 1/2" = 1'-0"

4
DETAIL

scale: 1" = 1'-0"

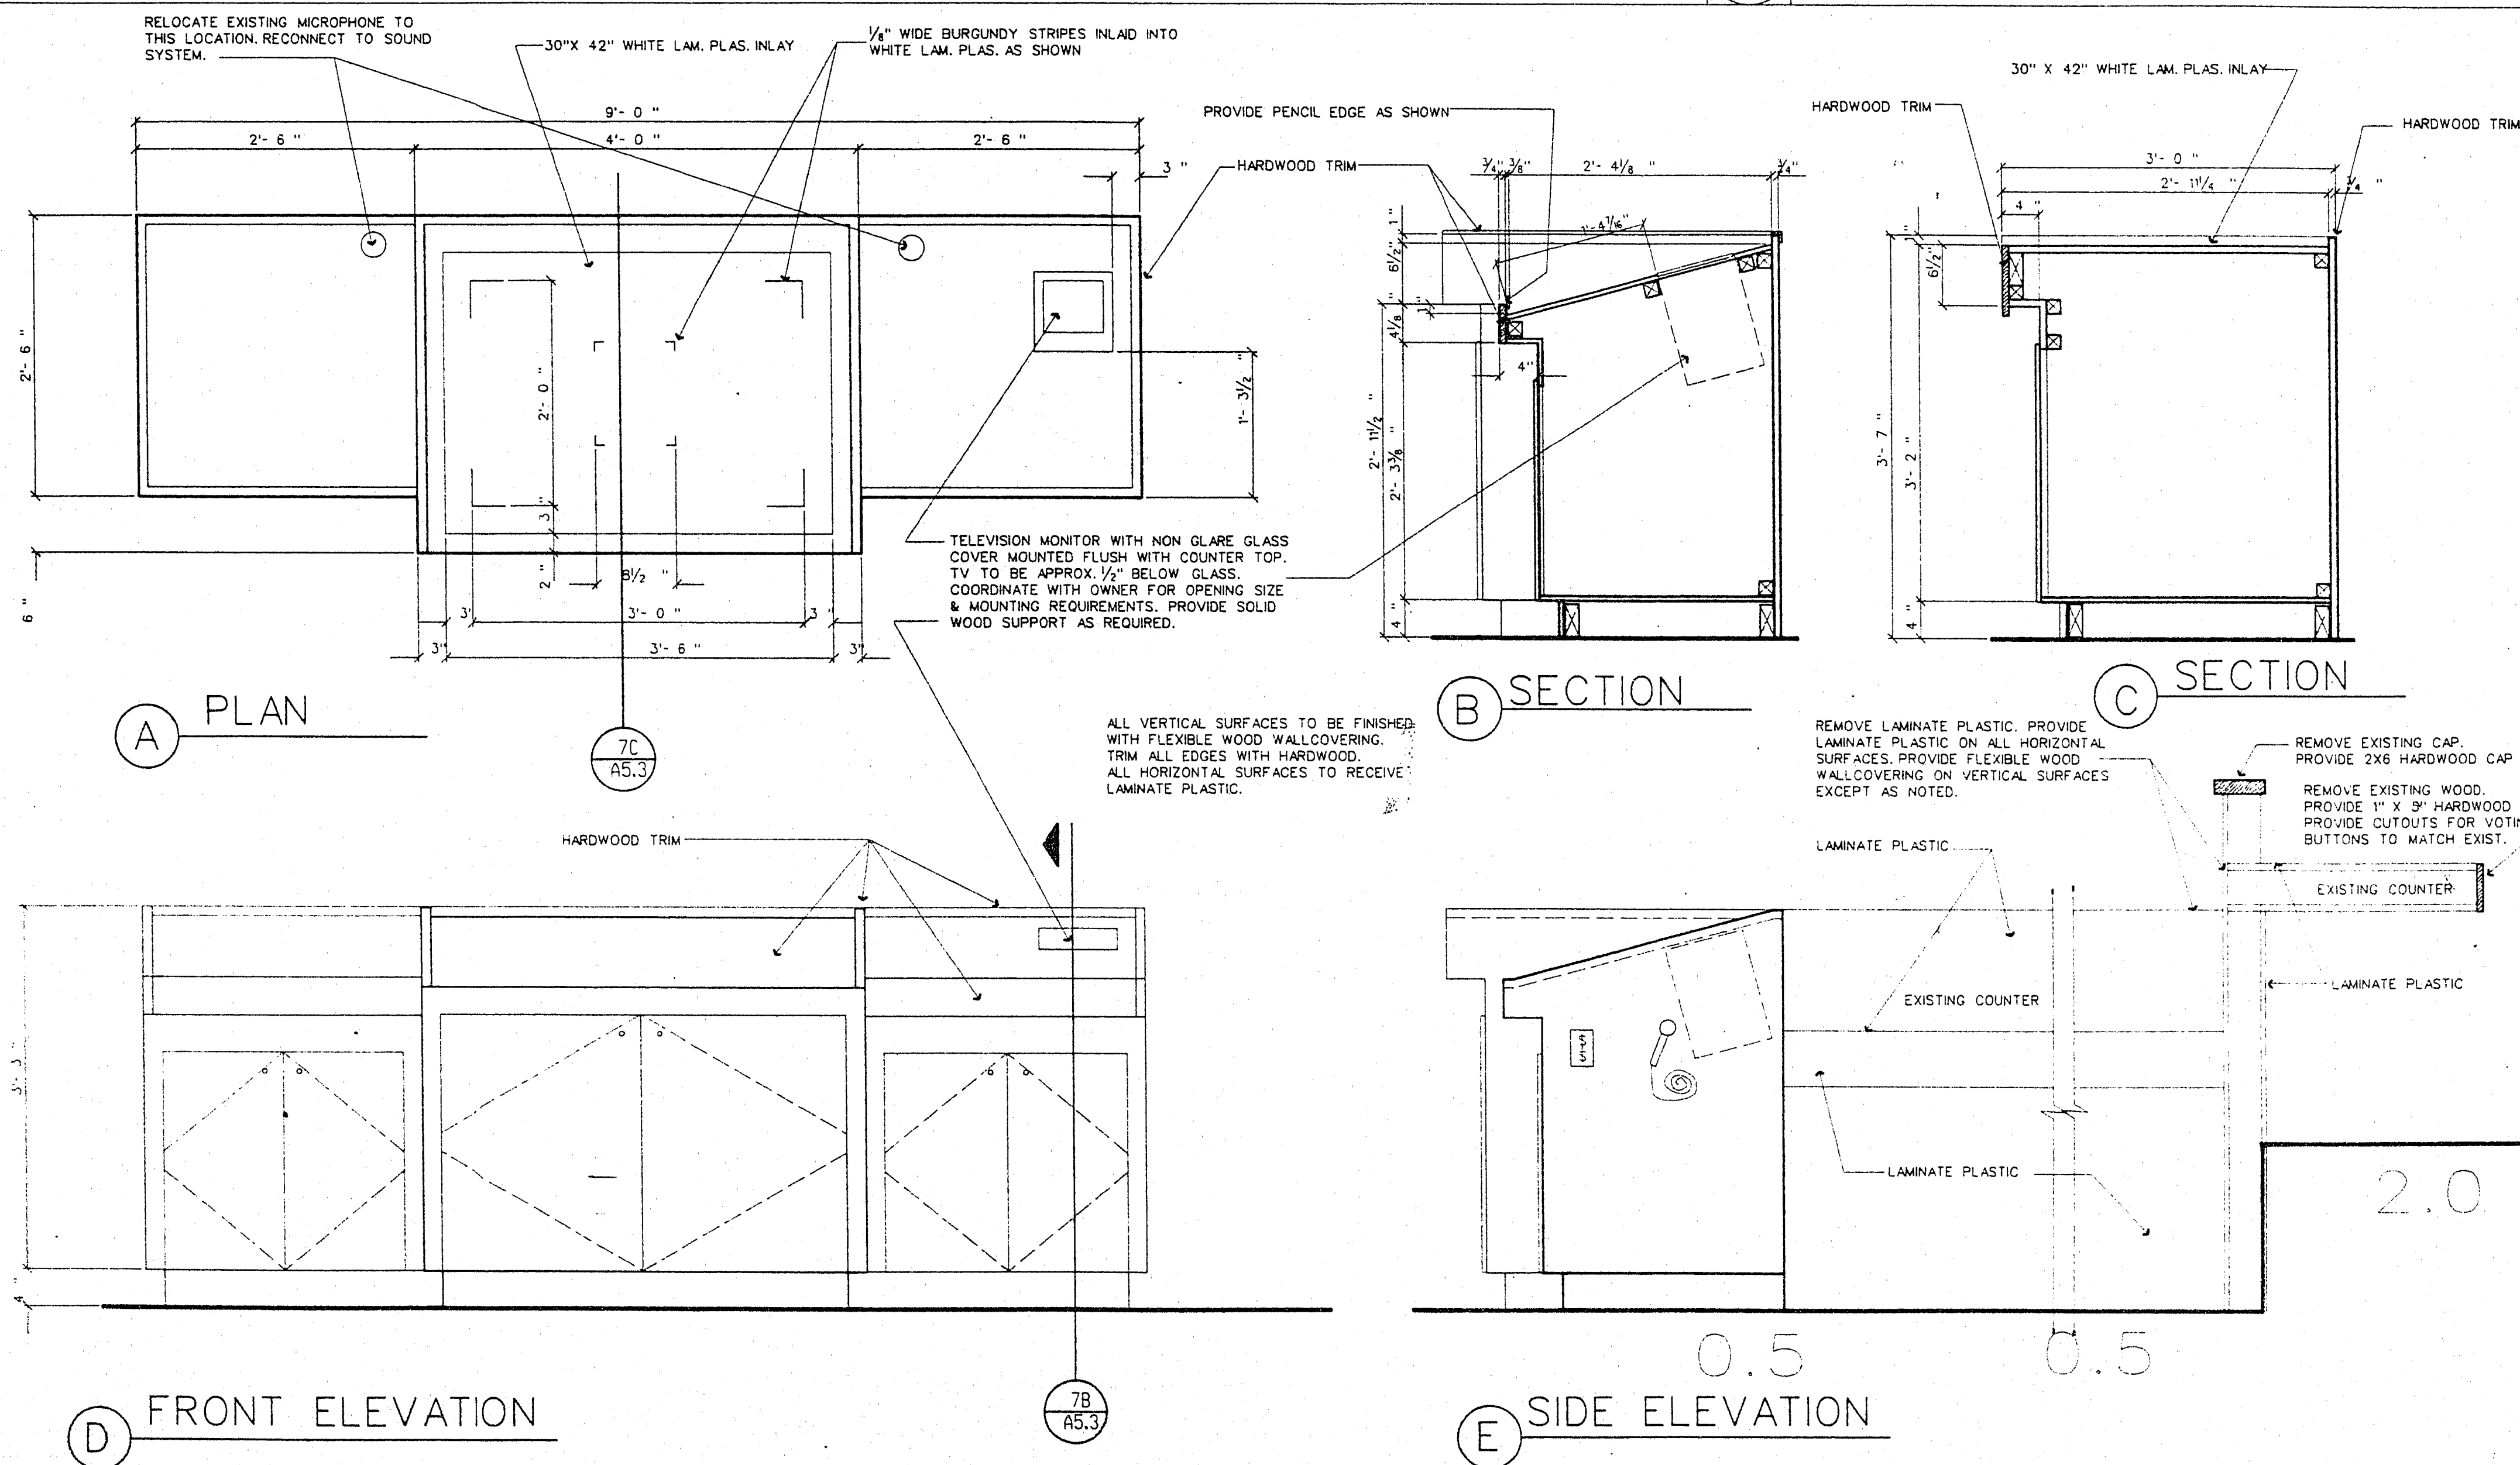

CONGDON ASSOCIATES
 architecture ♦ planning ♦ interiors
 3311 south jones boulevard, suite 212a
 las vegas, nevada, 89102 702-382-3888

REVISIONS: 6 03/29/91

THESE DRAWINGS AND SPECIFICATIONS ARE THE PROPERTY OF THE ARCHITECT AND MAY NOT BE REPRODUCED OR USED FOR ANY OTHER PROJECT WITHOUT THE WRITTEN CONSENT OF THE ARCHITECT. THESE DRAWINGS ARE NOT VALID UNLESS THEY ARE SCHEDULED, AND SEALED BY THE ARCHITECT.

DRAWING TITLE: DETAILS

PROJECT: CITY COUNCIL CHAMBERS renovation

CONGDON ASSOCIATES

PROJECT: 9019
 DATE:
 JAN. 21, 1991

DRAWING NO.:
 A5.3

PROJECT RECORD 8/29/91

521-218