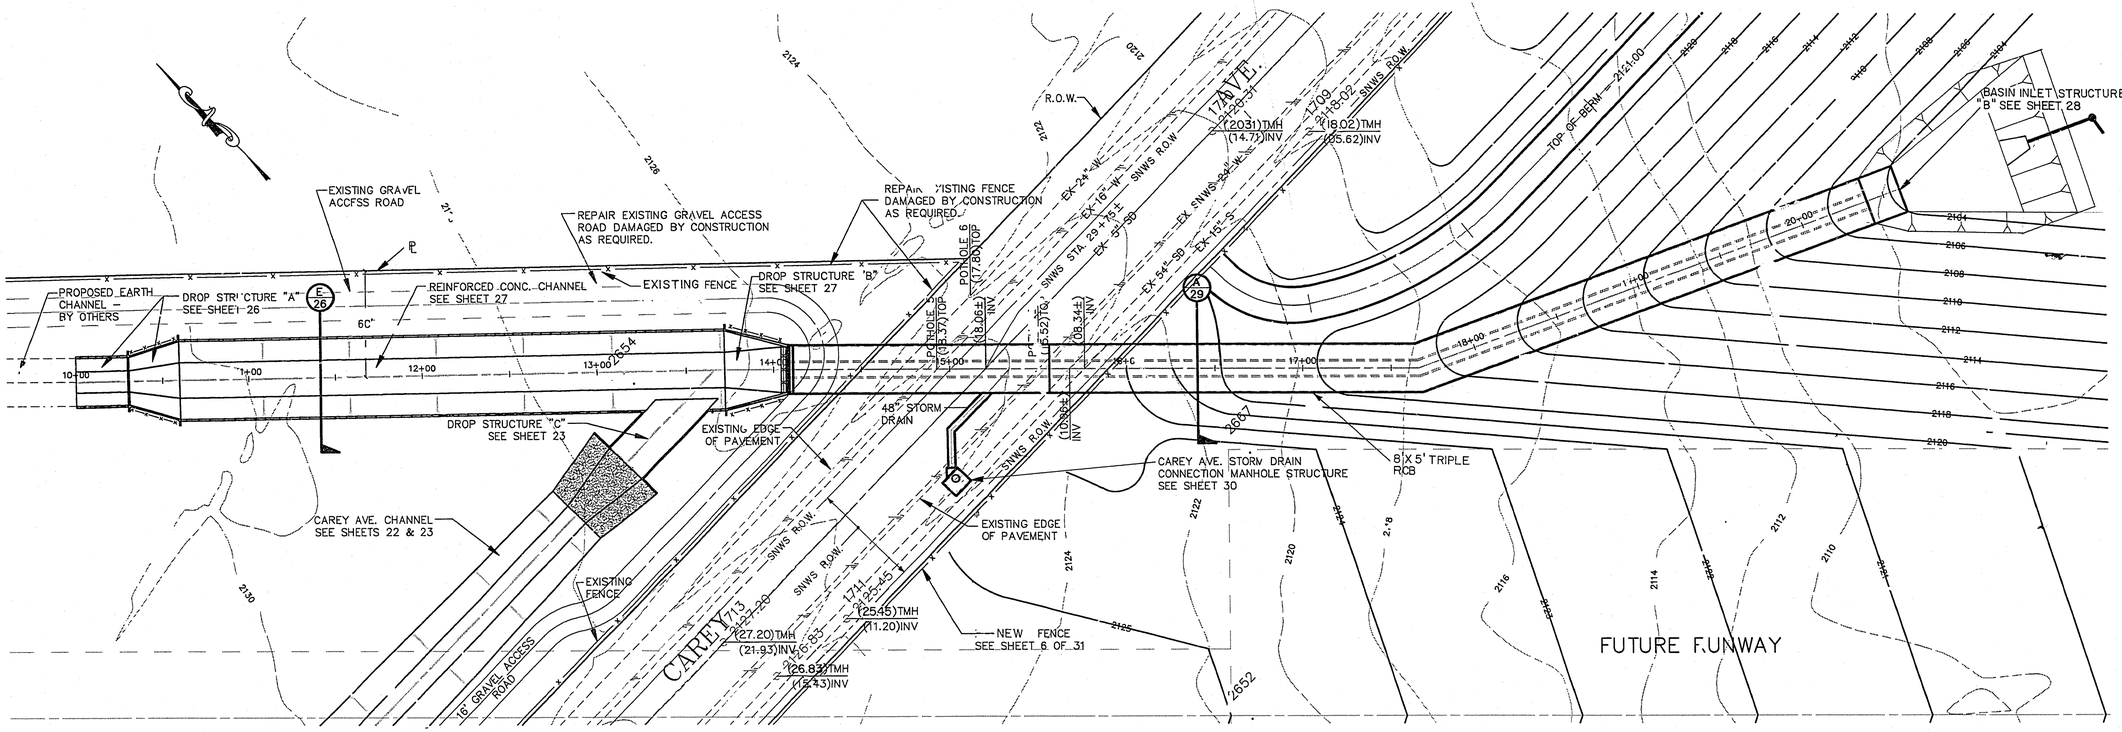

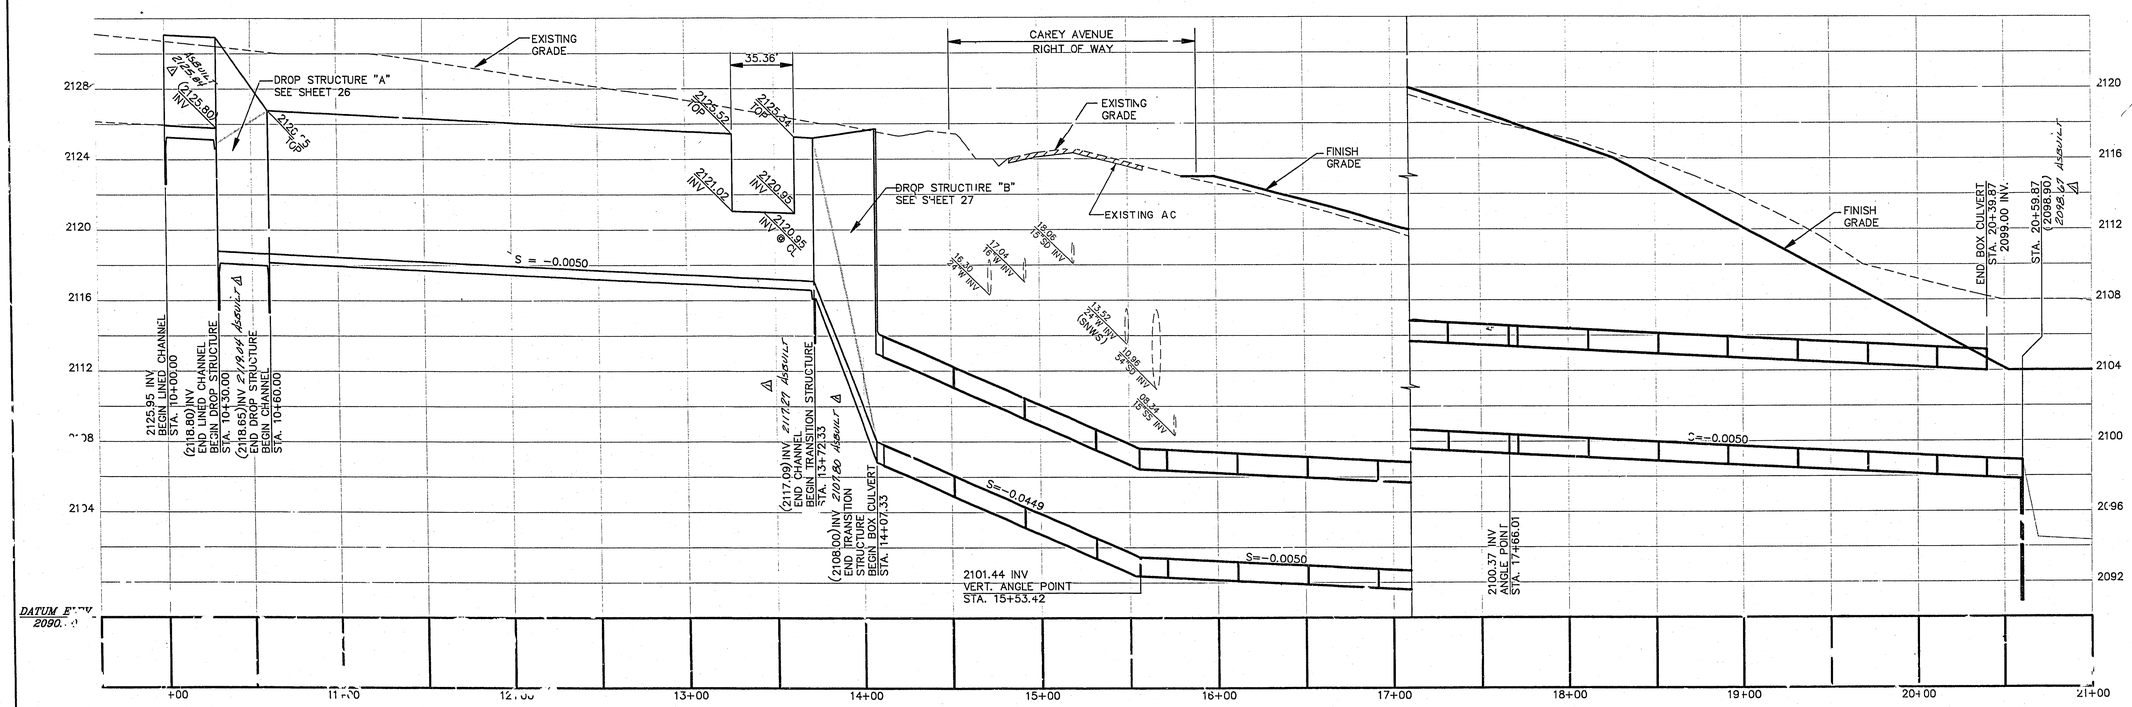

CITY OF LAS VEGAS
CLARK COUNTY, NEVADA

REV	DATE	BY	REVISION
1	10-8-92	DH	ASBUILT

CONSULTING ENGINEERS • PLANNERS • LAND SURVEYORS
2727 SOUTH RAINBOW BOULEVARD
LAS VEGAS, NEVADA 89102-5148 PHONE (702) 873-7550 FAX (702) 362-2597

TITLE: PLAN & PROFILE CAREY AVE. CULVERT & EAST CHANNEL

PROJECT: CAREY / LAKE MEAD DETENTION BASIN

SEAL: REGISTERED PROFESSIONAL ENGINEER DENNIS F. DIAZ CIVIL No. 8759 STATE OF NEVADA

WO NO. 3996
BY PMH/BKP
DATE JUNE 5, 1991
SCALE HORIZ. 1" = VERT. 1" =
SHEET 21 OF 31 SHEETS

731-51