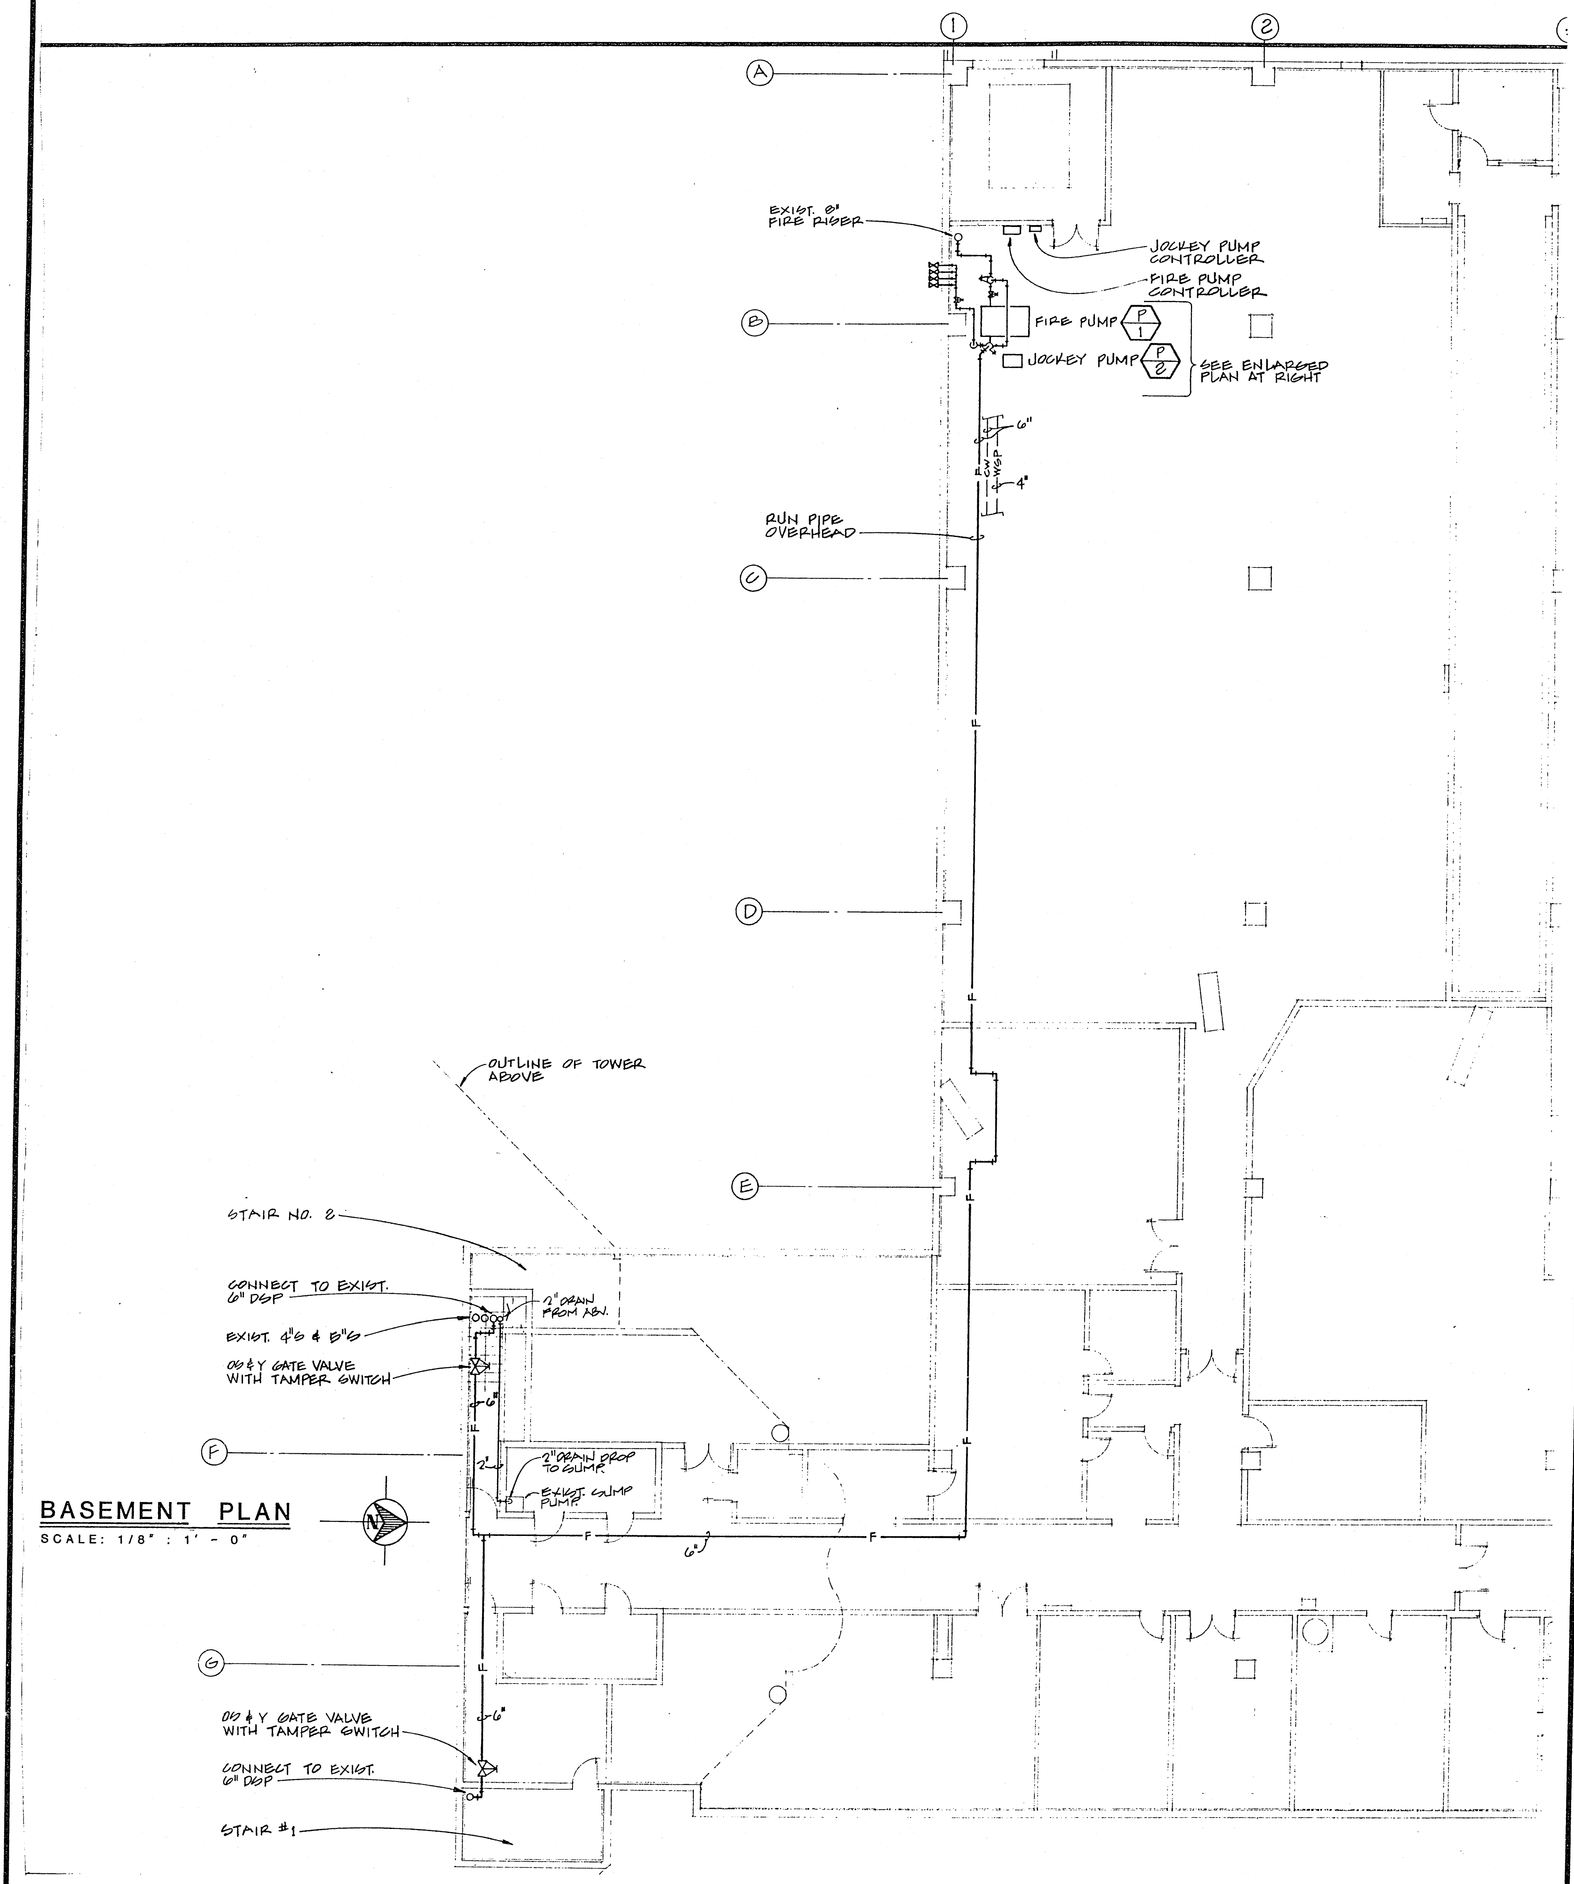

BASEMENT PLAN

SCALE: 1/8" : 1' - 0"

DRAWING NO. 521-237 18/20	SHEET: FIRE SPRINKLER AS-BUILT BASEMENT PLAN	PROJECT: CITY HALL RENOVATION SIXTH FLOOR	CITY OF LAS VEGAS NEVADA	DEPARTMENT OF PUBLIC WORKS ARCHITECTURAL SERVICES	
				DESIGN BY: / DRAWN BY:	
				DATE: 10-95 / SCALE:	REVISIONS / DATE