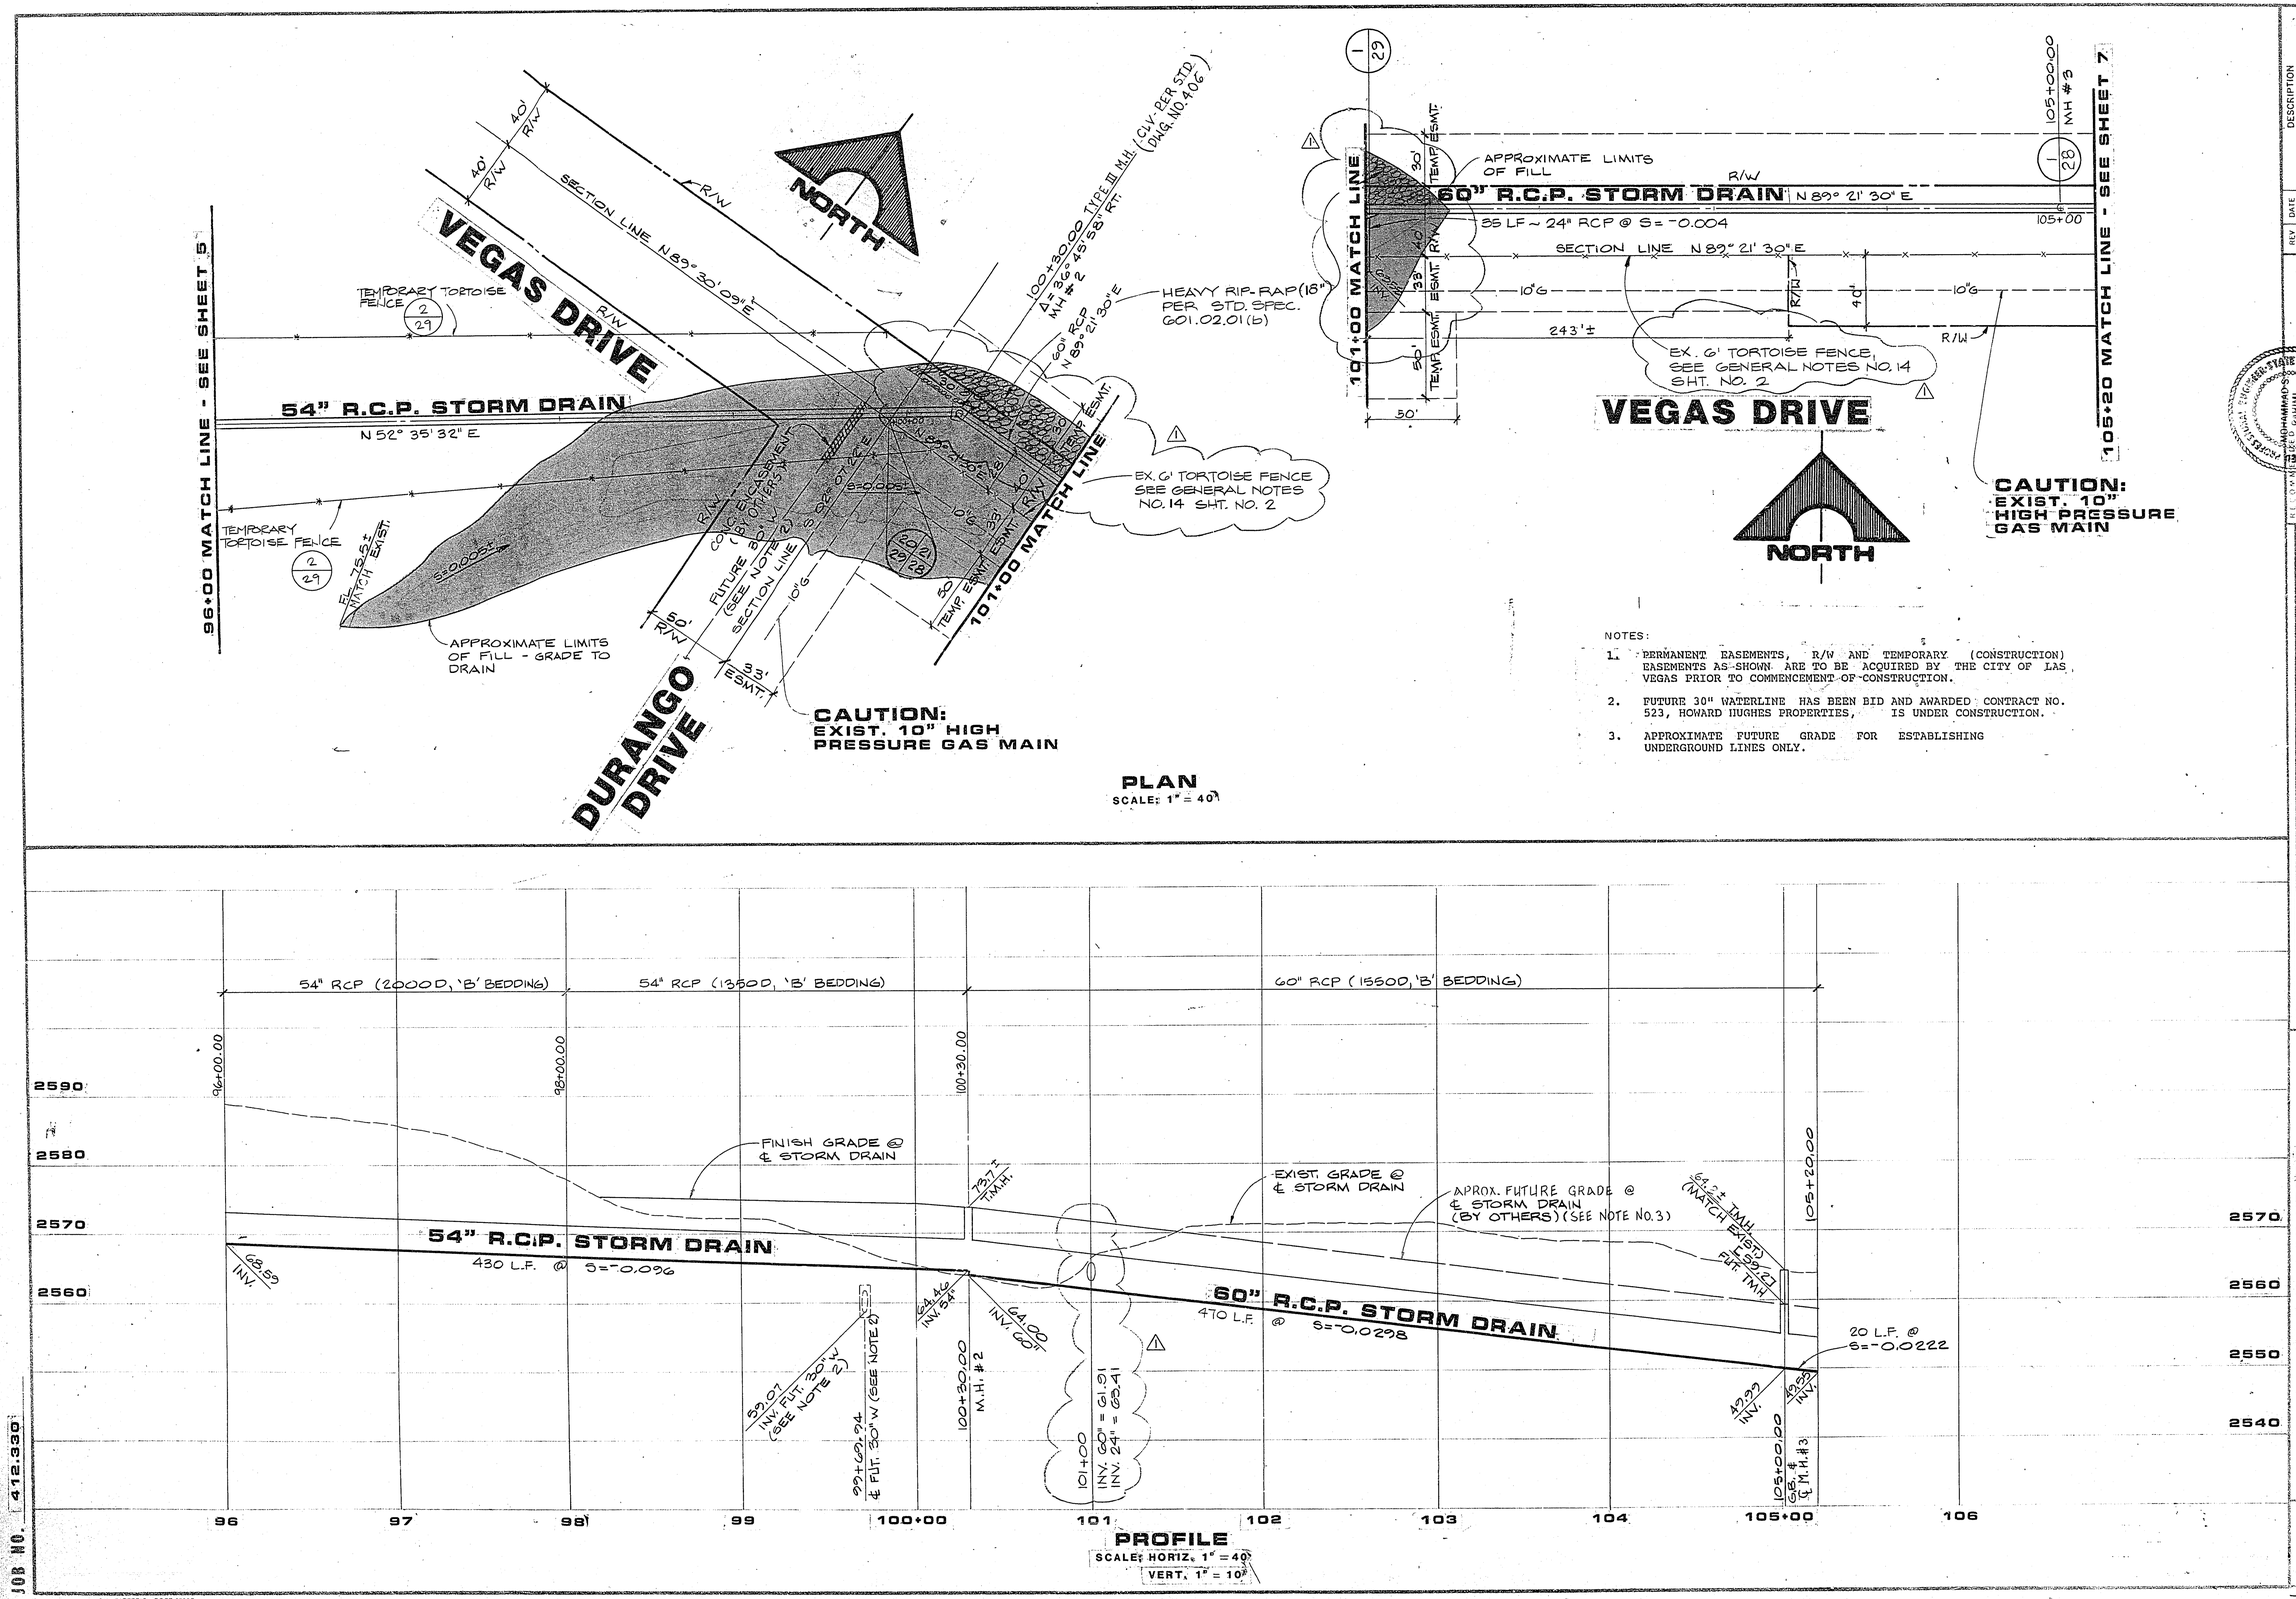

REV	DATE	DESCRIPTION
1	10-11-90	MISCELLANEOUS

REGISTERED PROFESSIONAL ENGINEER STATE OF NEVADA MOHAMMAD-S. RAHIMI REG. NO. 7183 12/1/89

G.C. WALLACE, INC. RECORD DRAWING 13MAY92
Engineering/Architecture
LAS VEGAS, NEVADA

CITY OF LAS VEGAS
ANGEL PARK OUTLET AND OUTFALL
PLAN AND PROFILE
STATION 96+00 TO 105+00

SHEET 6 OF 31 SHEETS

JOB NO. 412.330

6/84 DIETERICH-POST 6532B

CAN 100688

731-49