



JOB NO. 412.330

CAN 100886
BIM DIETERICH-POST 65328

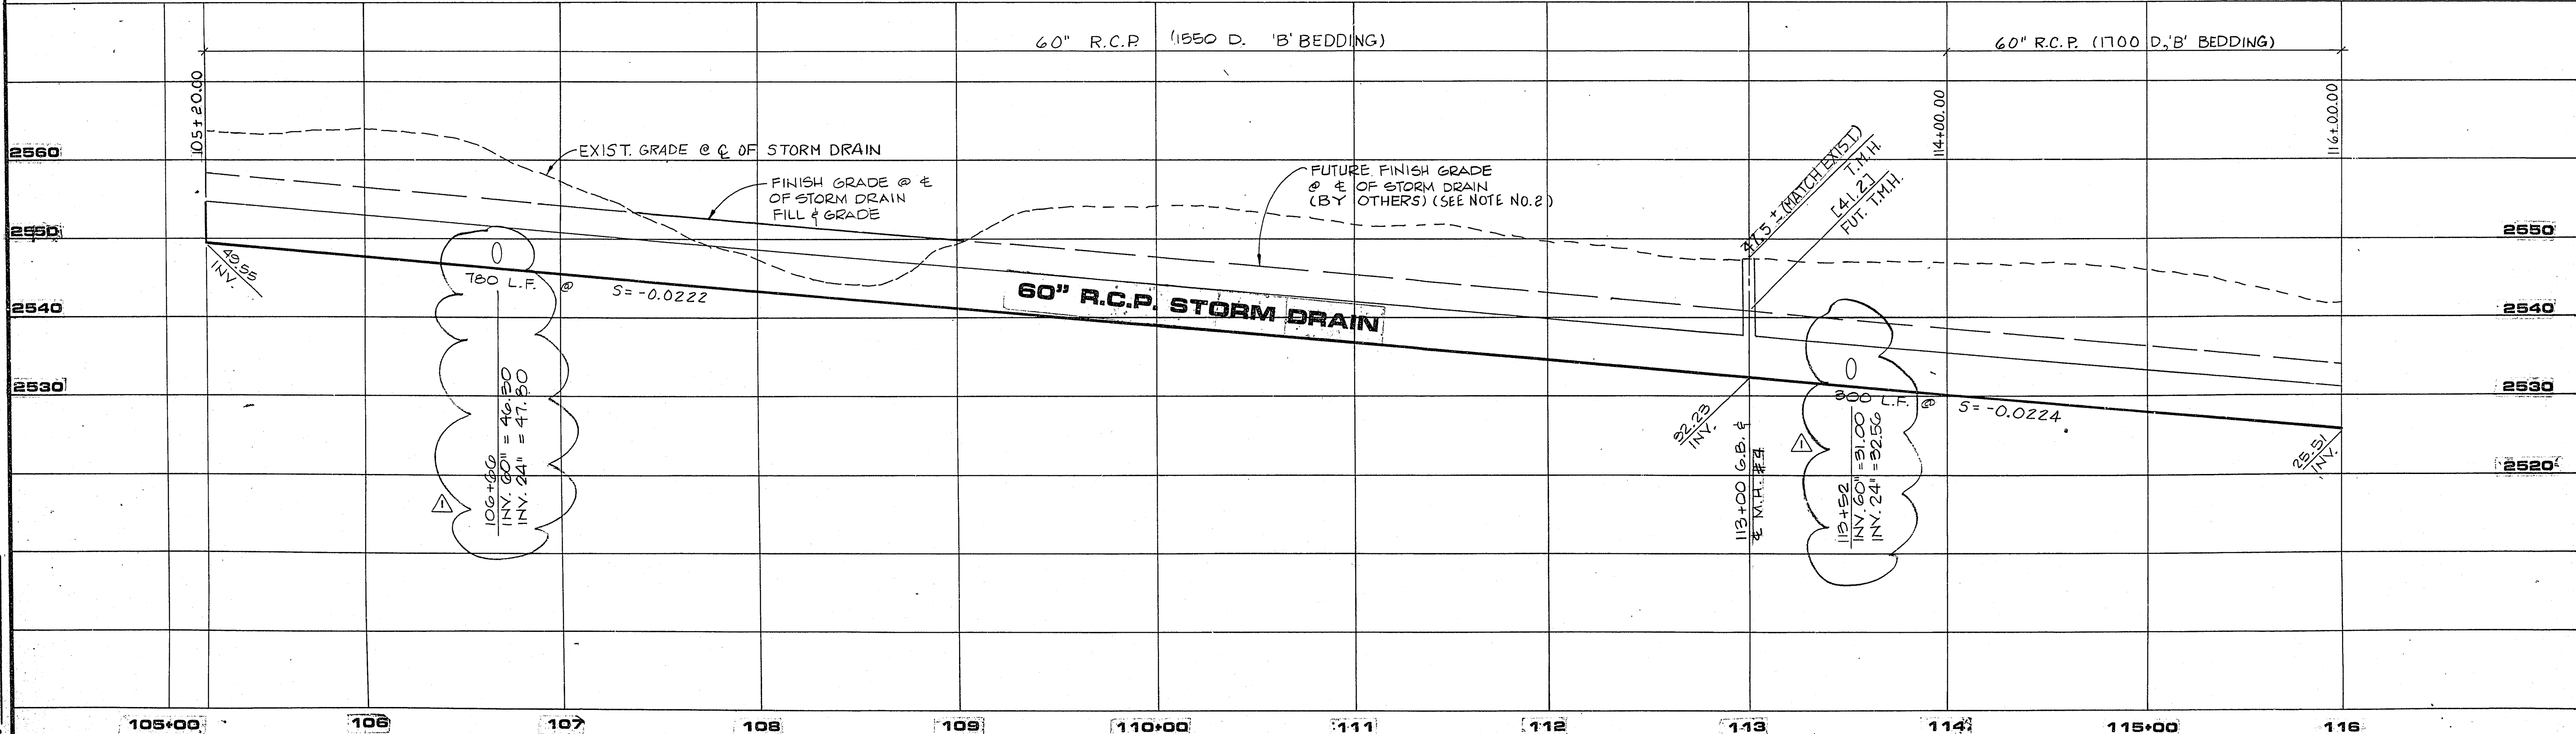


PROFILE
SCALE: HORIZ. 1"=40'
VERT. 1"=10'

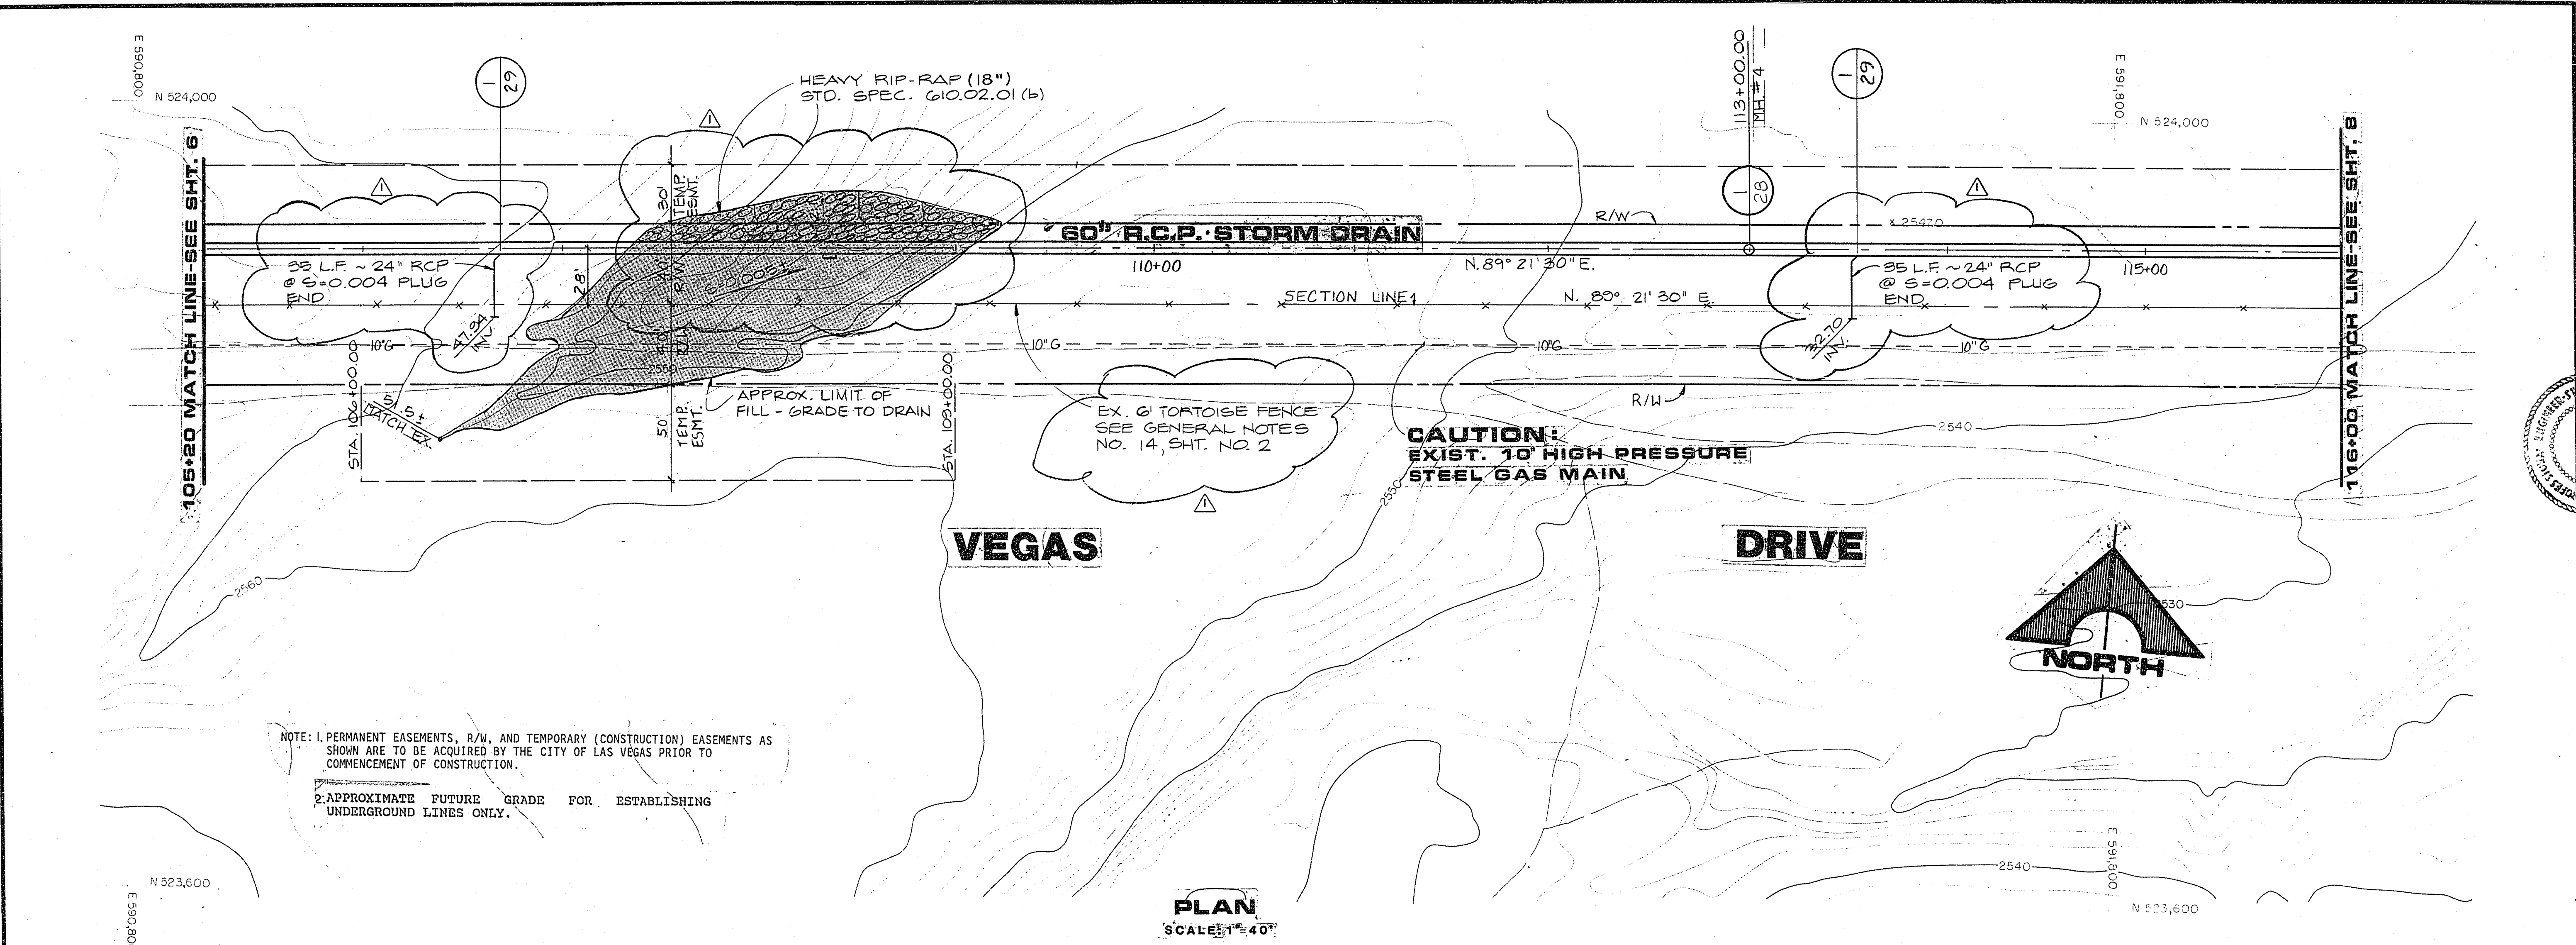

PLAN
SCALE: 1"=40'

NOTE: 1. PERMANENT EASEMENTS, R/W, AND TEMPORARY (CONSTRUCTION) EASEMENTS AS SHOWN ARE TO BE ACQUIRED BY THE CITY OF LAS VEGAS PRIOR TO COMMENCEMENT OF CONSTRUCTION.
2. APPROXIMATE FUTURE GRADE FOR ESTABLISHING UNDERGROUND LINES ONLY.

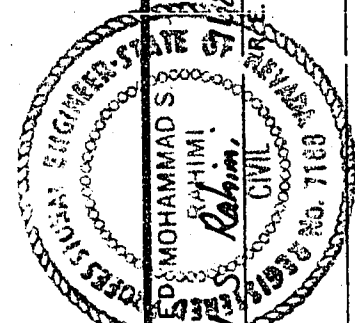

RECORDED DRAWING: 13 MAY 92
1555 SOUTH RAINBOW BLVD., LAS VEGAS, NEVADA 89102

G.C. WALLACE, INC.
Engineering/Architecture

CITY OF LAS VEGAS
ANGEL PARK OUTLET AND OUTFALL
PLAN AND PROFILE
STATION 105+20 TO 116+00

SHEET
7
OF 31 SHEETS

731-49