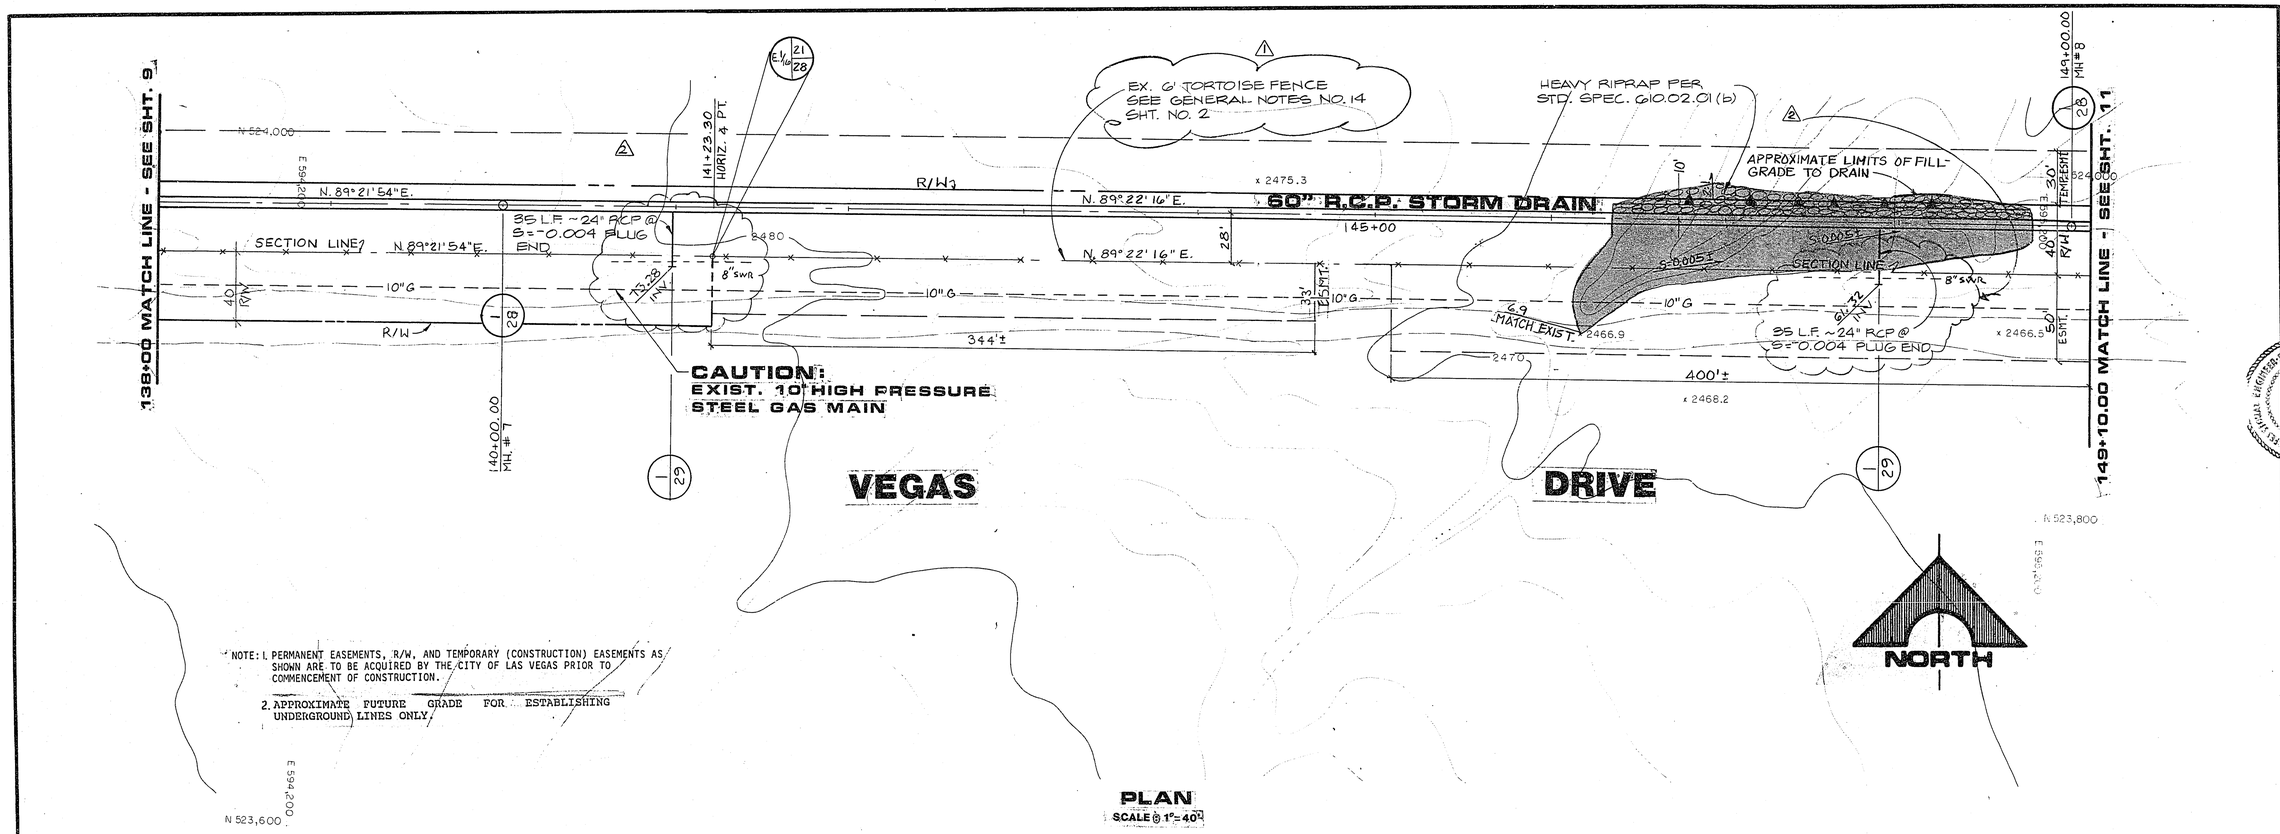

NOTE: 1. PERMANENT EASEMENTS, R/W, AND TEMPORARY (CONSTRUCTION) EASEMENTS AS SHOWN ARE TO BE ACQUIRED BY THE CITY OF LAS VEGAS PRIOR TO COMMENCEMENT OF CONSTRUCTION.

2. APPROXIMATE FUTURE GRADE FOR ESTABLISHING UNDERGROUND LINES ONLY.

PLAN
SCALE @ 1"=40'

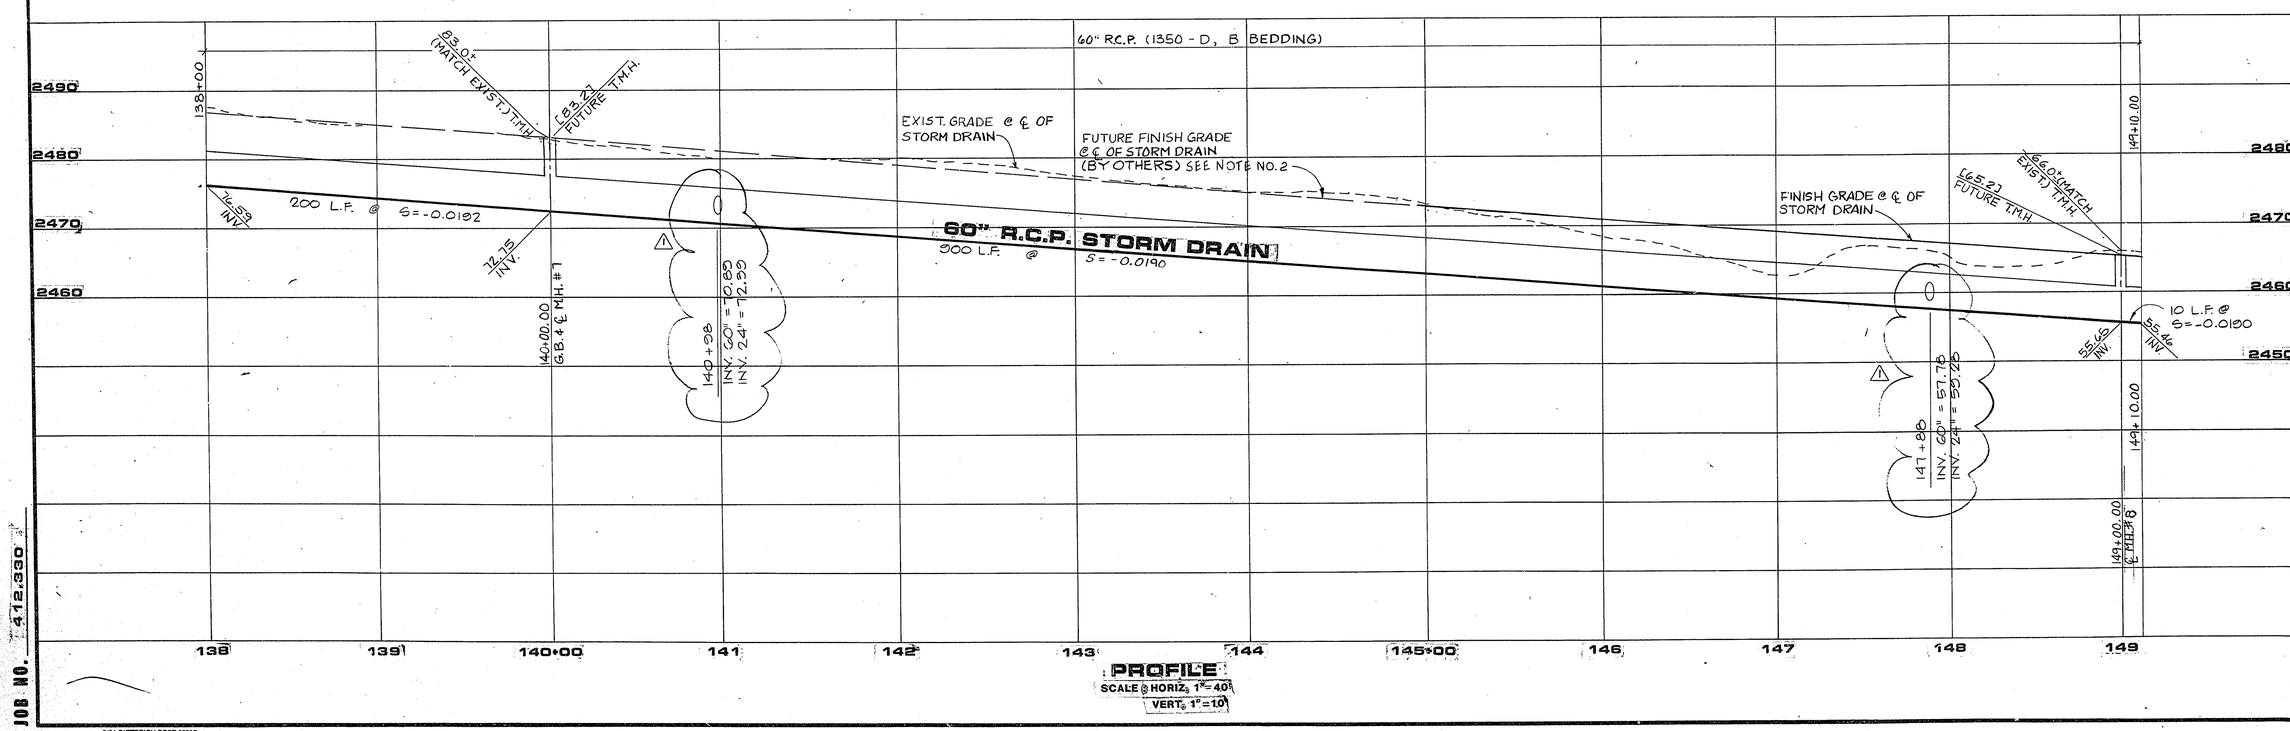

PROFILE
SCALE @ HORIZ. 1"=40'
VERT. 1"=10'

REV	DATE	DESCRIPTION
	10-11-90	MISCELLANEOUS
1	5-6-92	AS-BUILT

RECOMMENDED: Mohammad S. Yahia, CIVIL, NEVADA LICENSE No. 11188 — DATE 12/1/89

G.C. WALLACE, INC.
Engineering/Architecture
1555 SOUTH RAINBOW BLVD. / LAS VEGAS, NEVADA 89102

RECORD DRAWING 13 MAY 92

CITY OF LAS VEGAS
ANGEL PARK OUTLET AND OUTFALL
PLAN AND PROFILE
STATION 138+00 TO 149+00

SHEET 10 OF 31 SHEETS

JOB NO. 412.330

8/84 DIETERICH-POST 6532B

CAN 100888

93-25

731-49