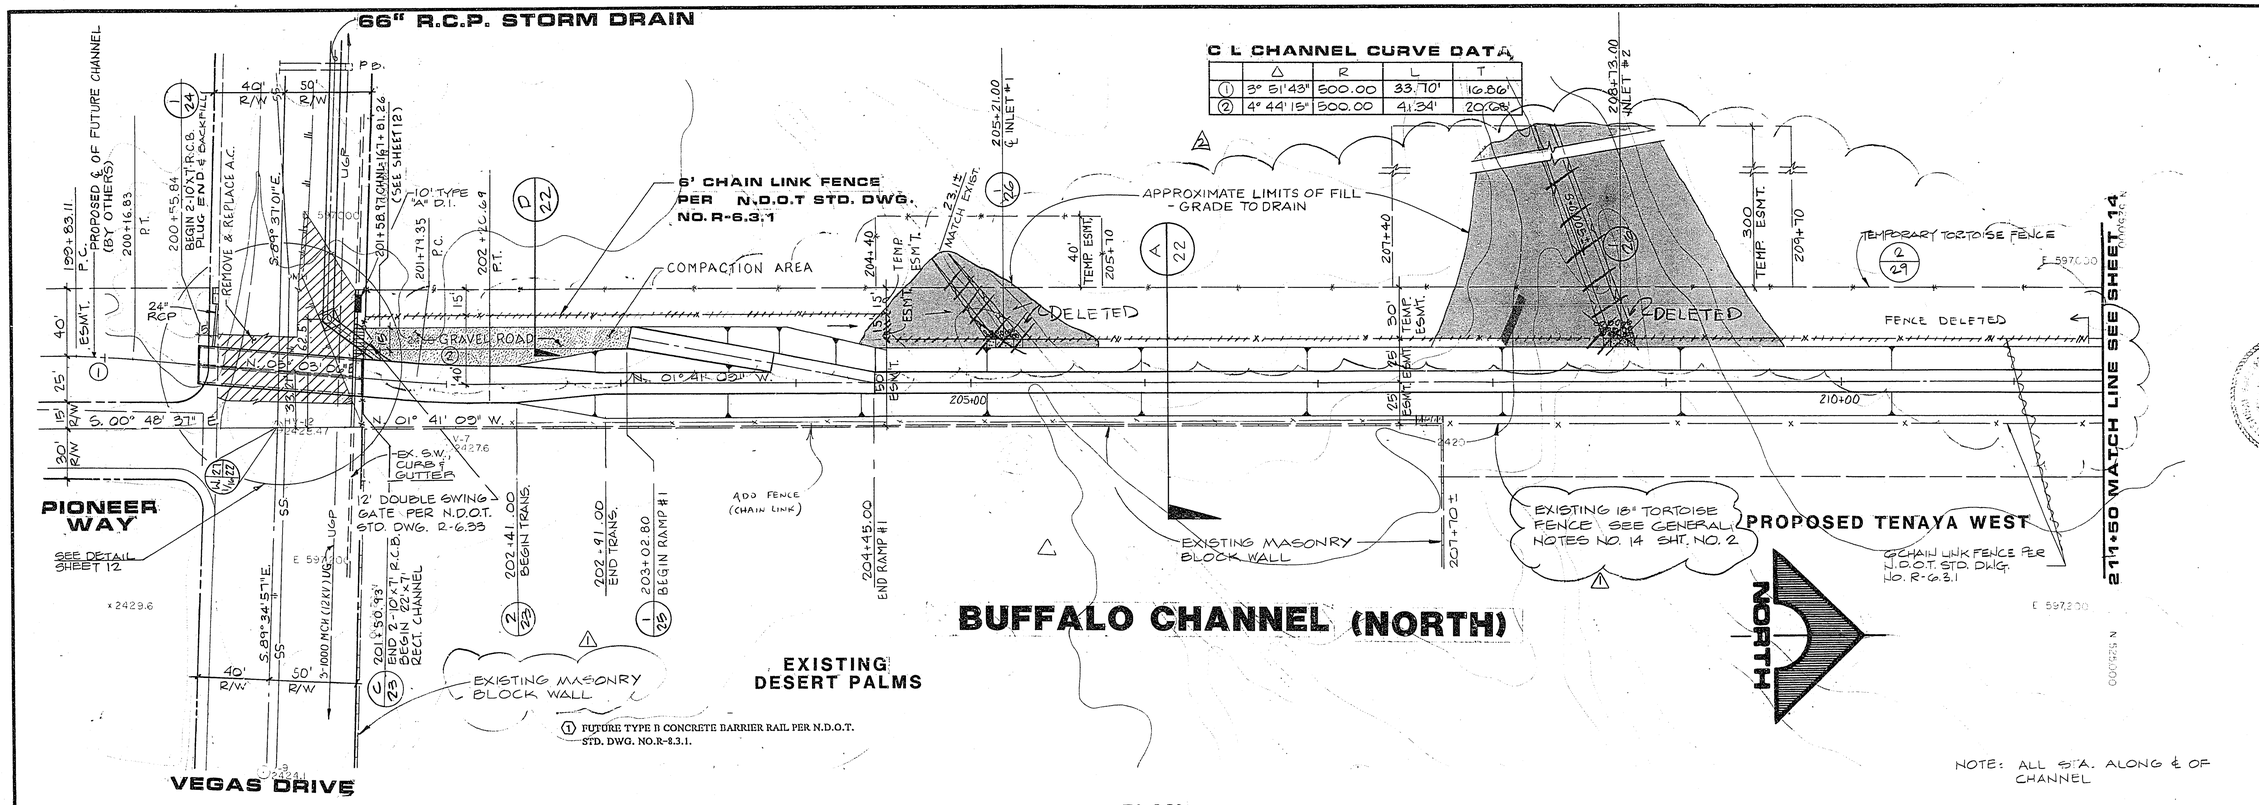

PLAN
SCALE: 1"=40'

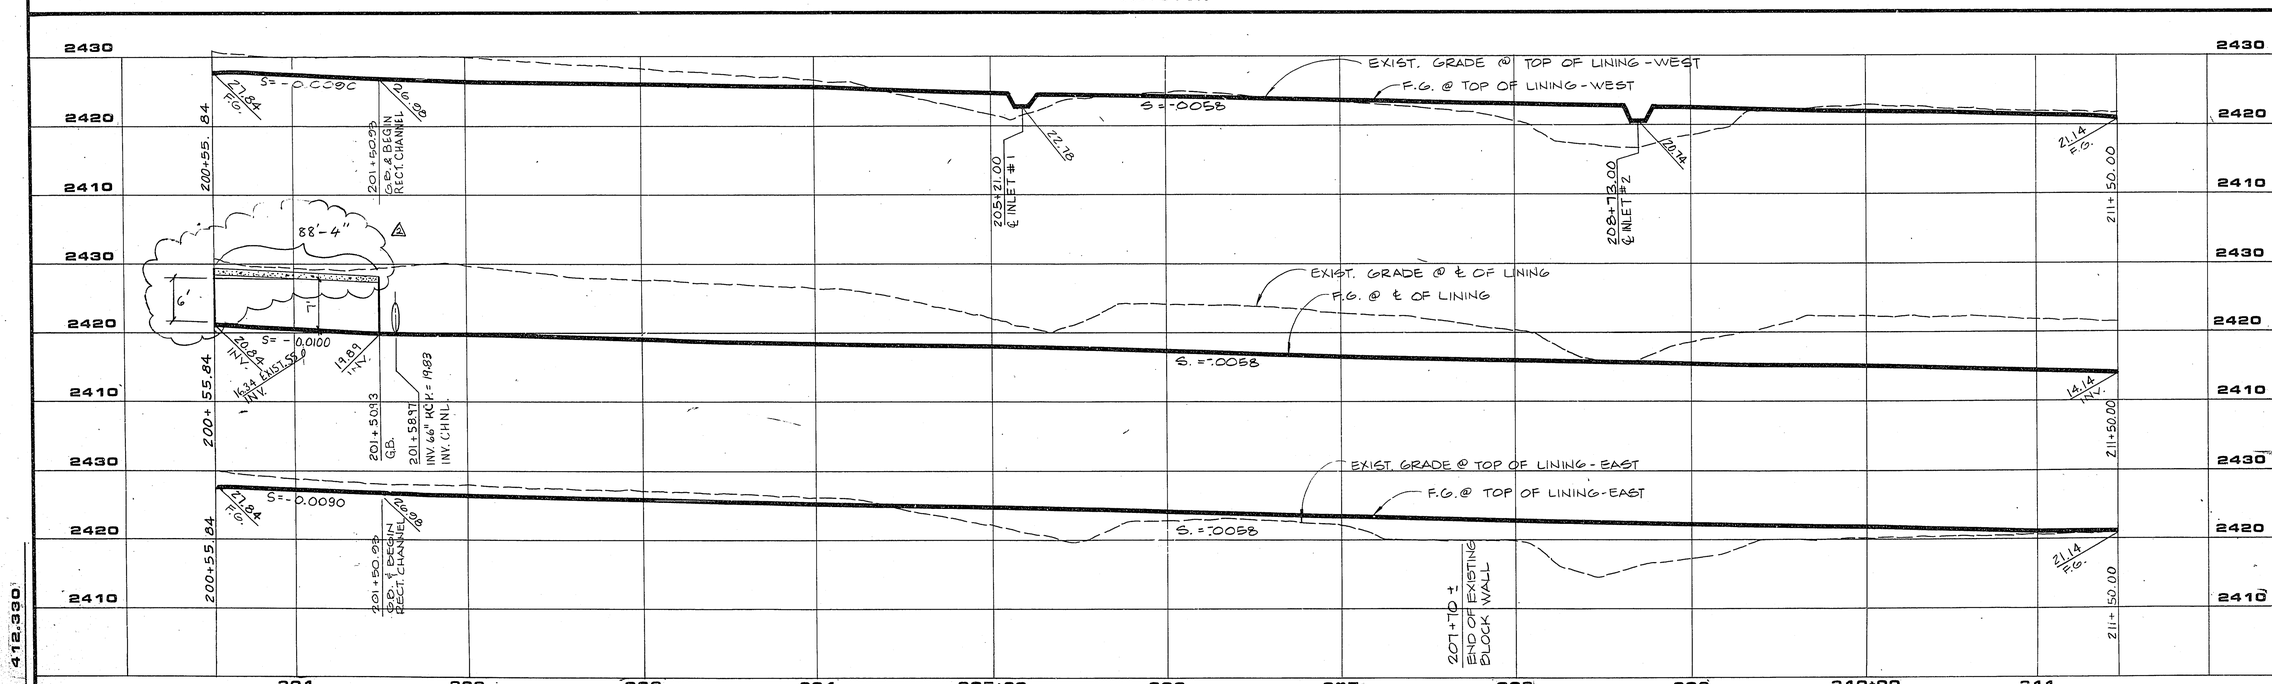

PROFILE
SCALE: HORIZ. 1"=40'
VERT. 1"=10'

REV	DATE	DESCRIPTION
1	10-11-90	MISCELLANEOUS
2	05-01-92	AS-BUILT

RECOMMENDED FOR ACCEPTANCE: Hakamad Rahim 12/1/89
CHIEF ENGINEER
CITY ENGINEER
DATE

G.C. WALLACE, INC. Engineering/Architecture
1555 SOUTH RAINBOW BLVD / LAS VEGAS, NEVADA 89102

RECORD DRAWING 13 MAY 92

CITY OF LAS VEGAS
ANGEL PARK OUTLET AND OUTFALL
PLAN AND PROFILE
STATION 200+54.60 TO 211+50

SHEET 13 OF 51 SHEETS

JOB NO. 412.330

8/84 DIETERICH-POST 6532B
CAN 100888

731-49