
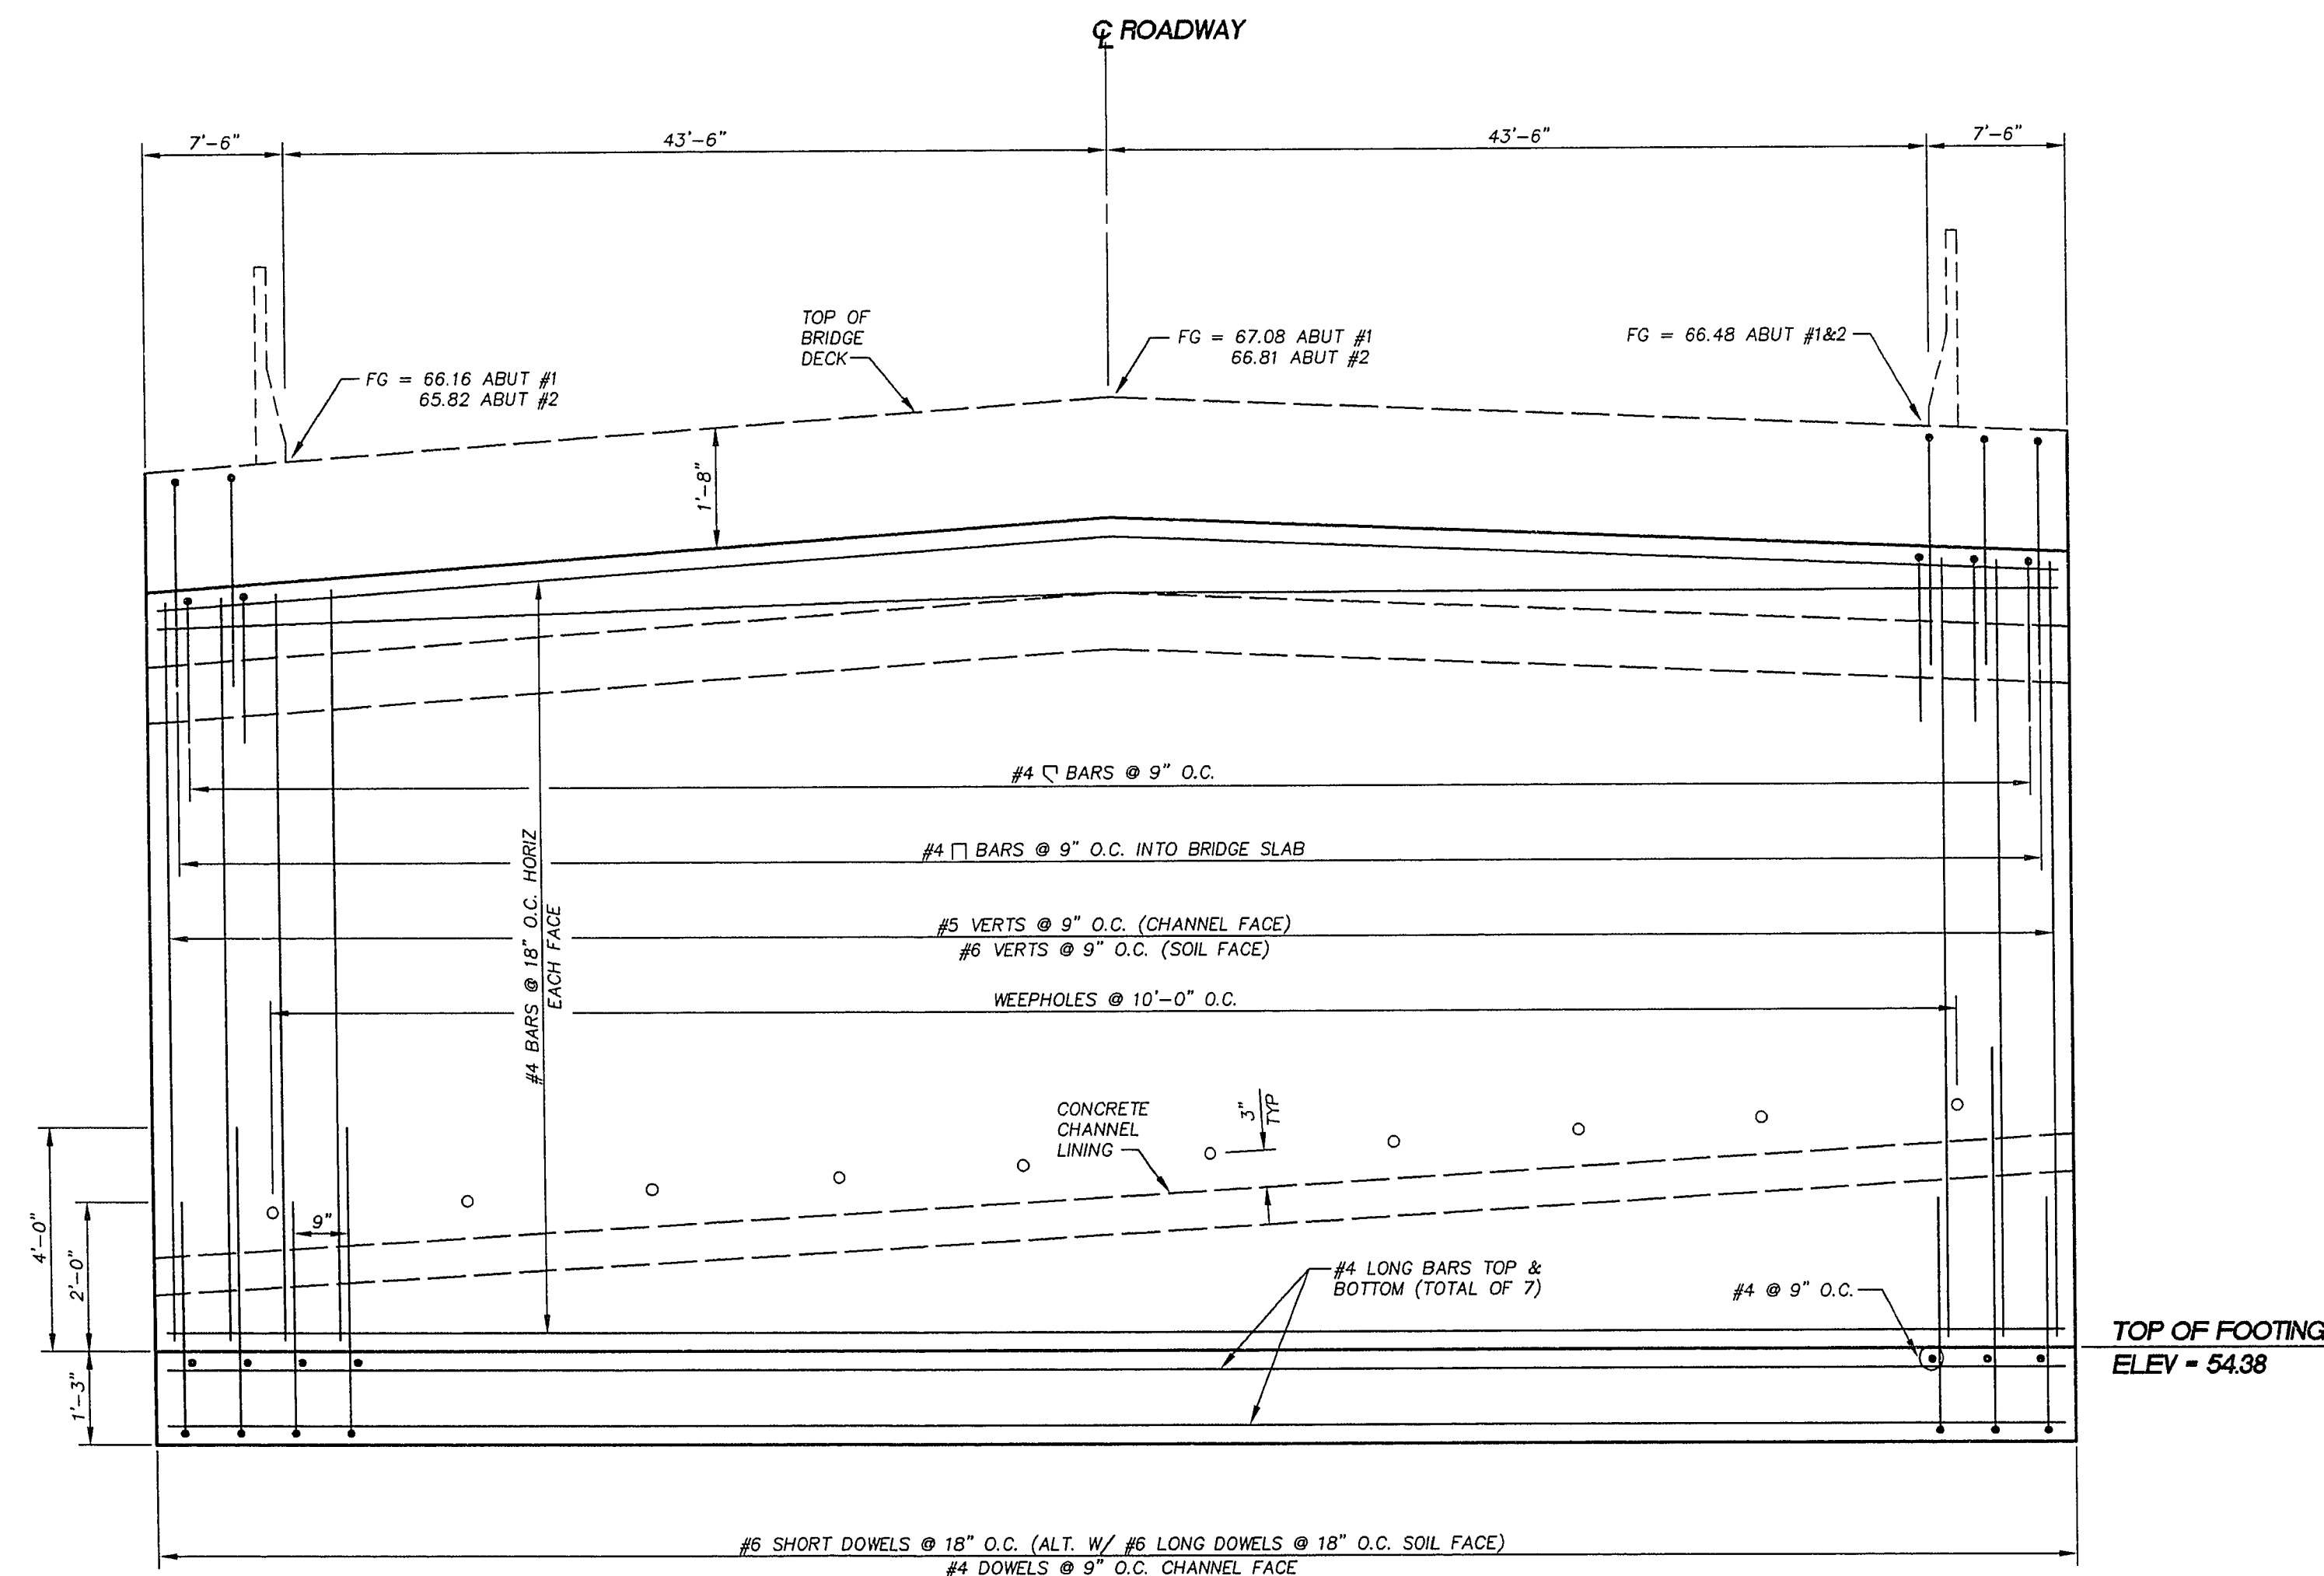



Avoid cutting underground utility lines. It's costly.

Call
before you
Dig
1-800-227-2600

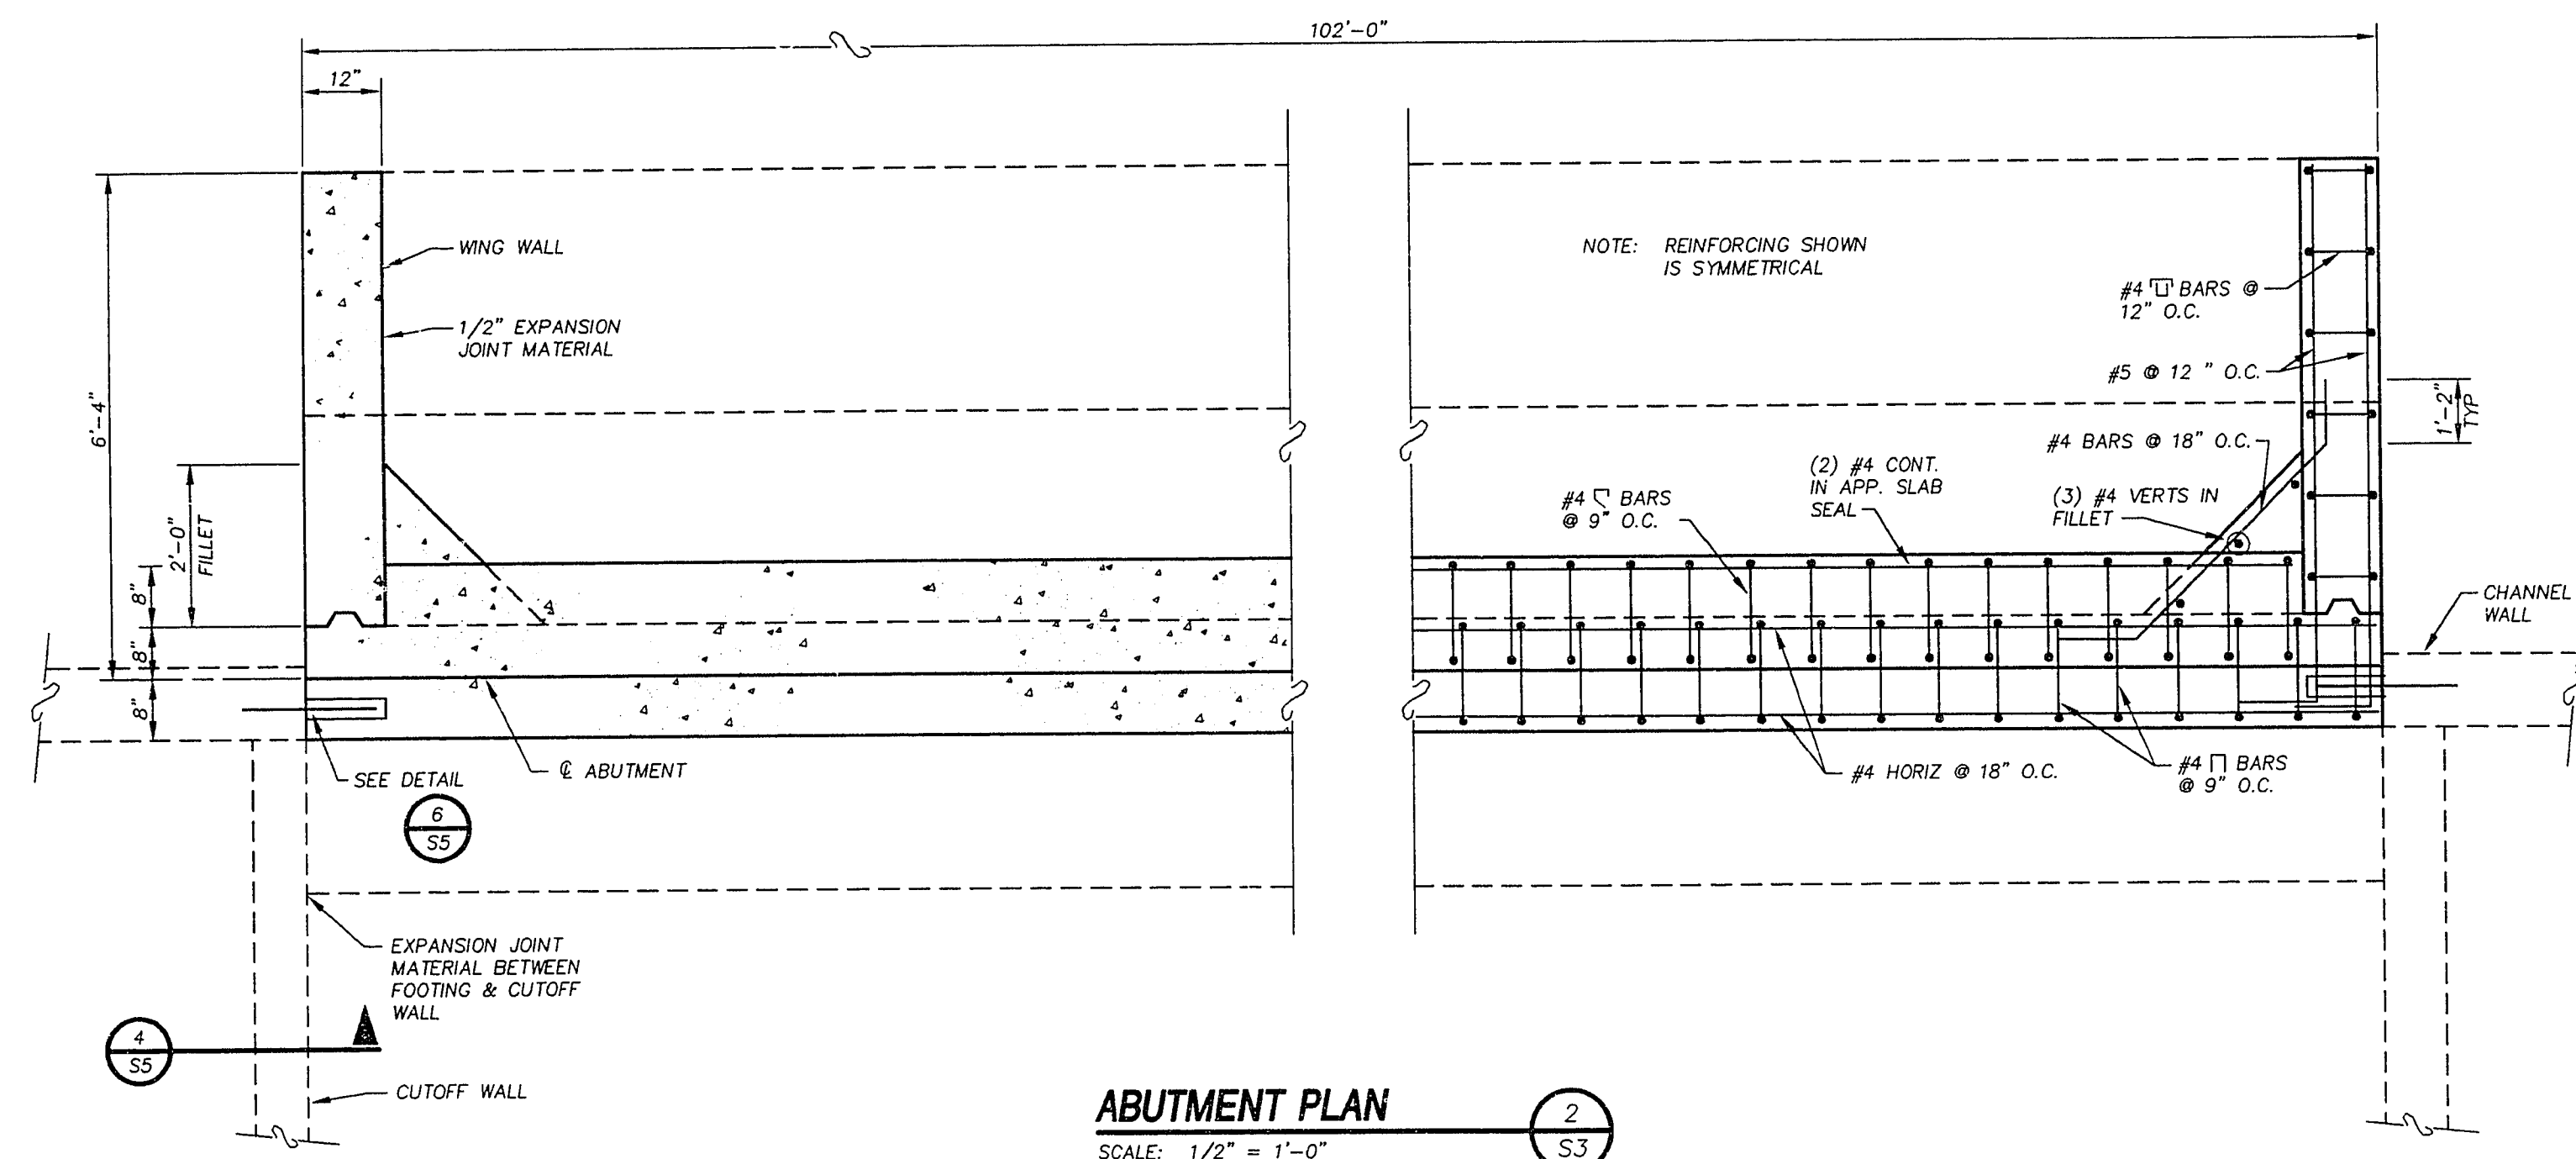


NOTE:
REINFORCING SPACING IS
EXAGGERATED FOR CLARITY

ABUTMENT ELEVATION (SOUTH)
HORIZ. SCALE: 1/8" = 1'-0" ABUT #1 SHOWN
VERT. SCALE: 1/2" = 1'-0" ABUT #2 SIMILAR

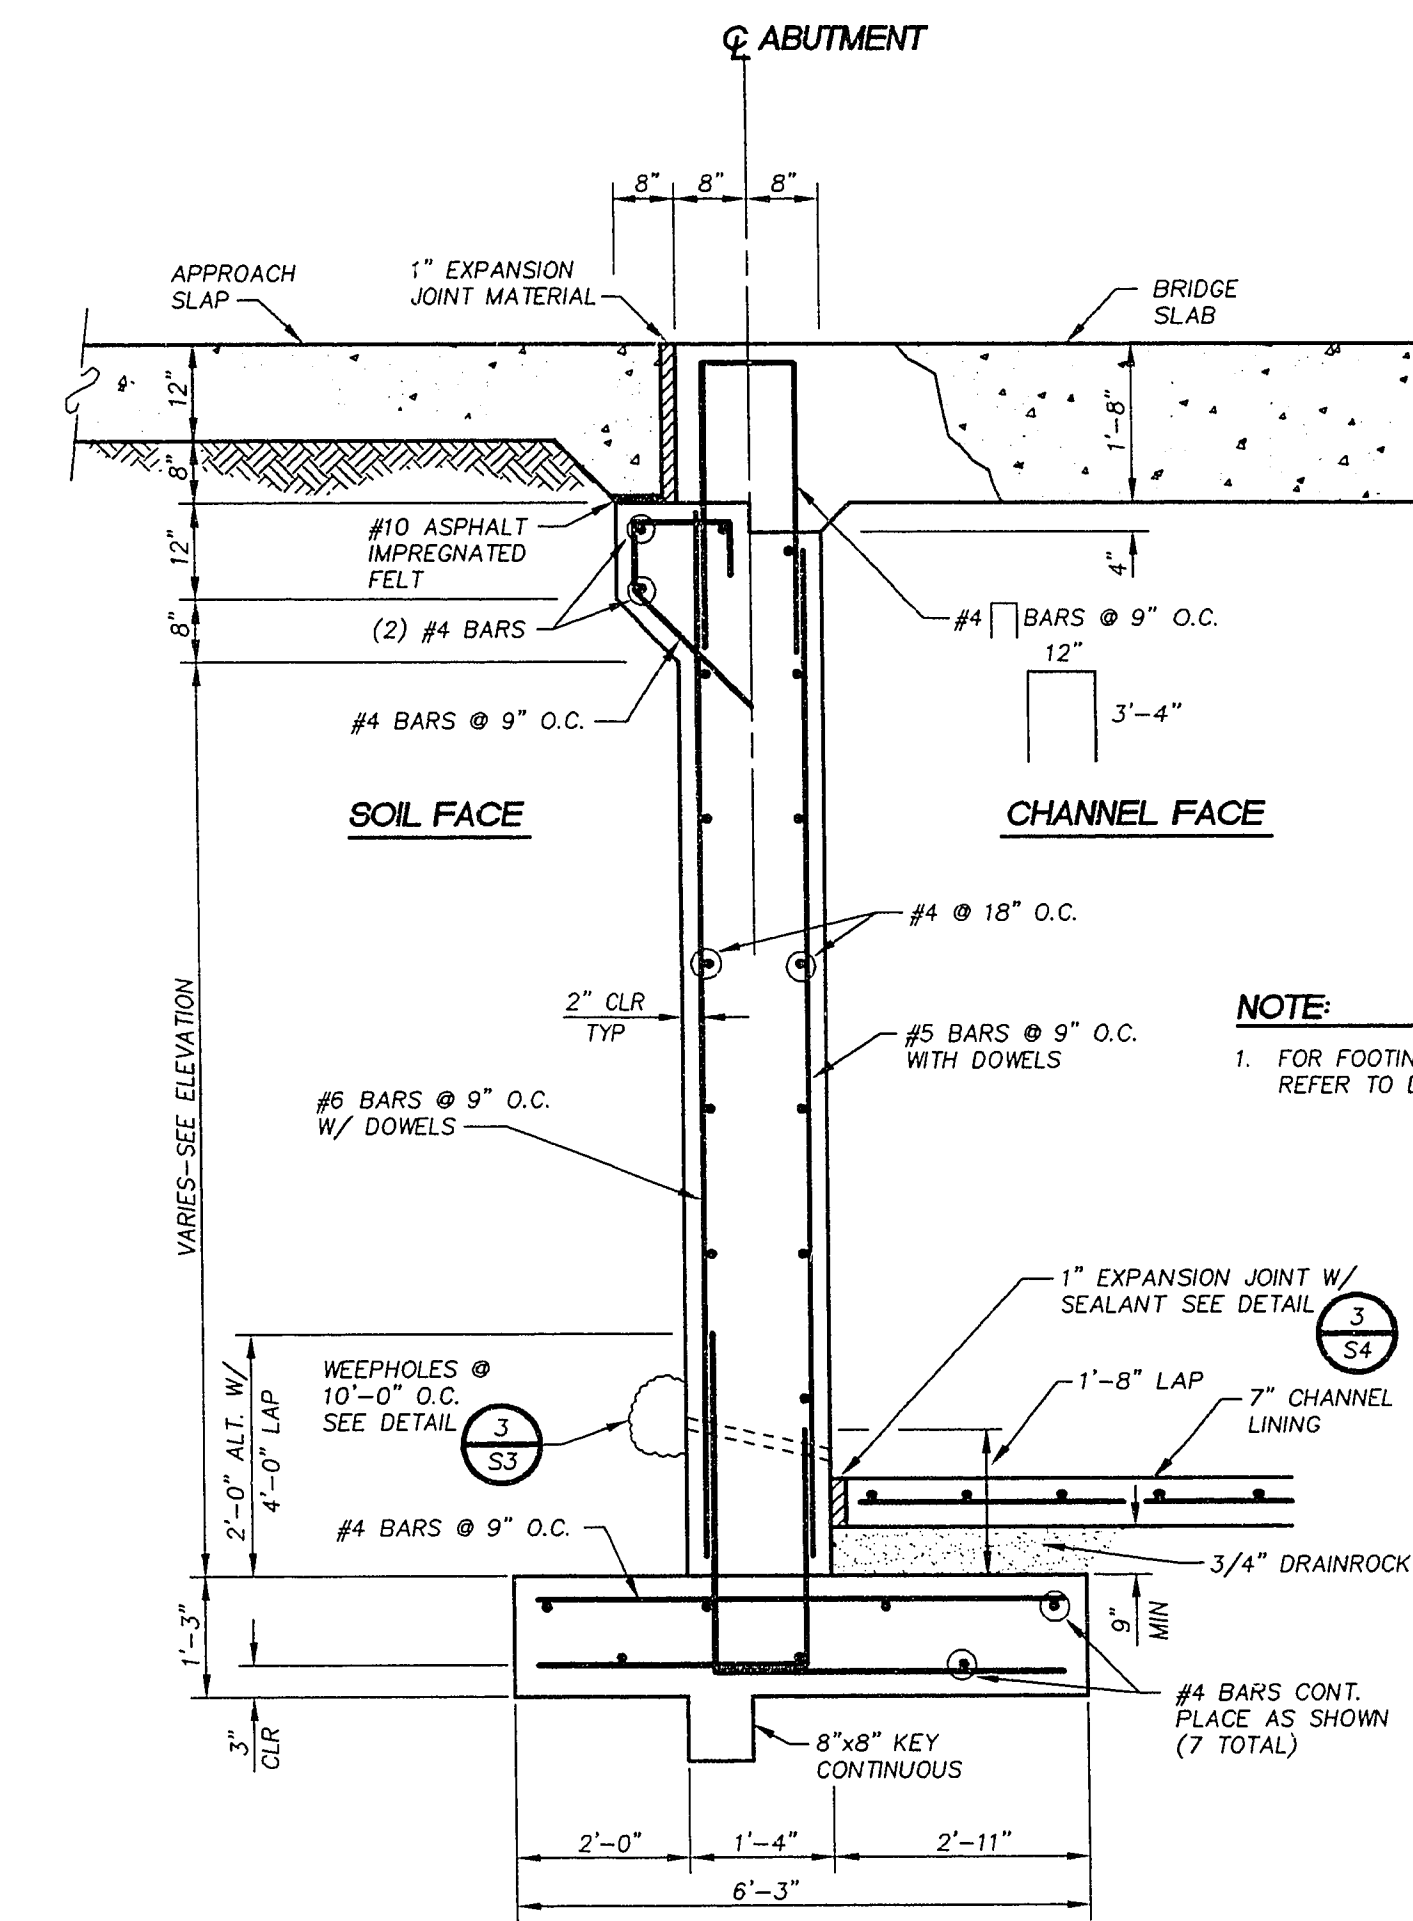

NOTE:
1. FOR FOOTING SPAN OF 36" WATERLINE REFER TO DETAIL 10 S5

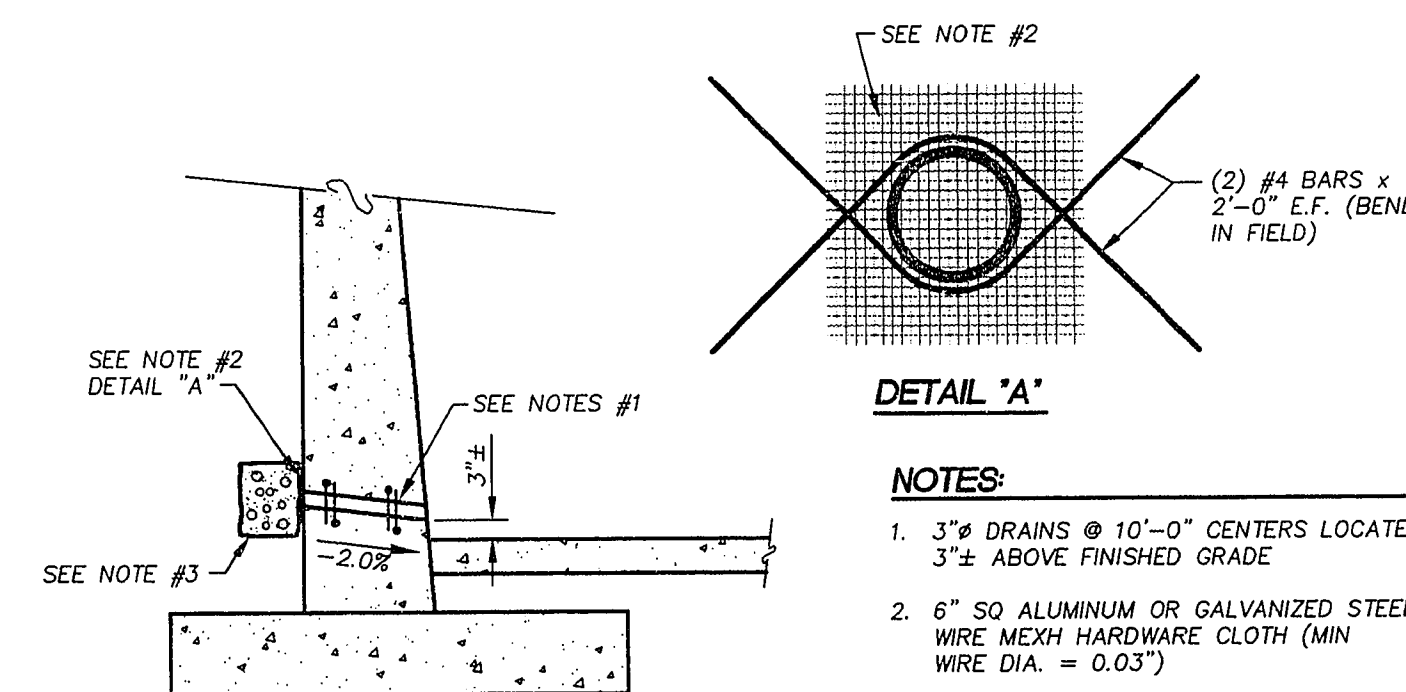

RECORD
DRAWINGS

DRAFTED BY: JMA DATE 2-2-95
CHECKED BY: DTA DATE 2-2-95

REVISIONS				
REV.	DESCRIPTION	BY	DATE	APPROVAL

Scale
HORIZONTAL : AS SHOWN
VERTICAL :
Job No. 7158.514

Church Engineering
A Division of
POST BUCKLEY SCHULH & JERNICAN
ENGINEERING • PLANNING • SURVEYING • CONSTRUCTION SERVICES
6500 West Charleston Blvd.
Suite 140
Las Vegas, Nevada 89102
Telephone: 702/878-6244
Fax: 702/878-7758

Designed by : PLK Date : 11/18/93
Drawn by : AAS Date : 11/18/93
Checked by : PAA Date : 11/18/93
File No. : 514IMP Dwg No. : 514-S3

	City of Las Vegas CHEYENNE CHANNEL IMPROVEMENTS BID No. 94.1730.12	
	STRUCTURAL DETAILS (BUFFALO)	
	CITY OF LAS VEGAS DRAWING No. 731-58	SHEET 83