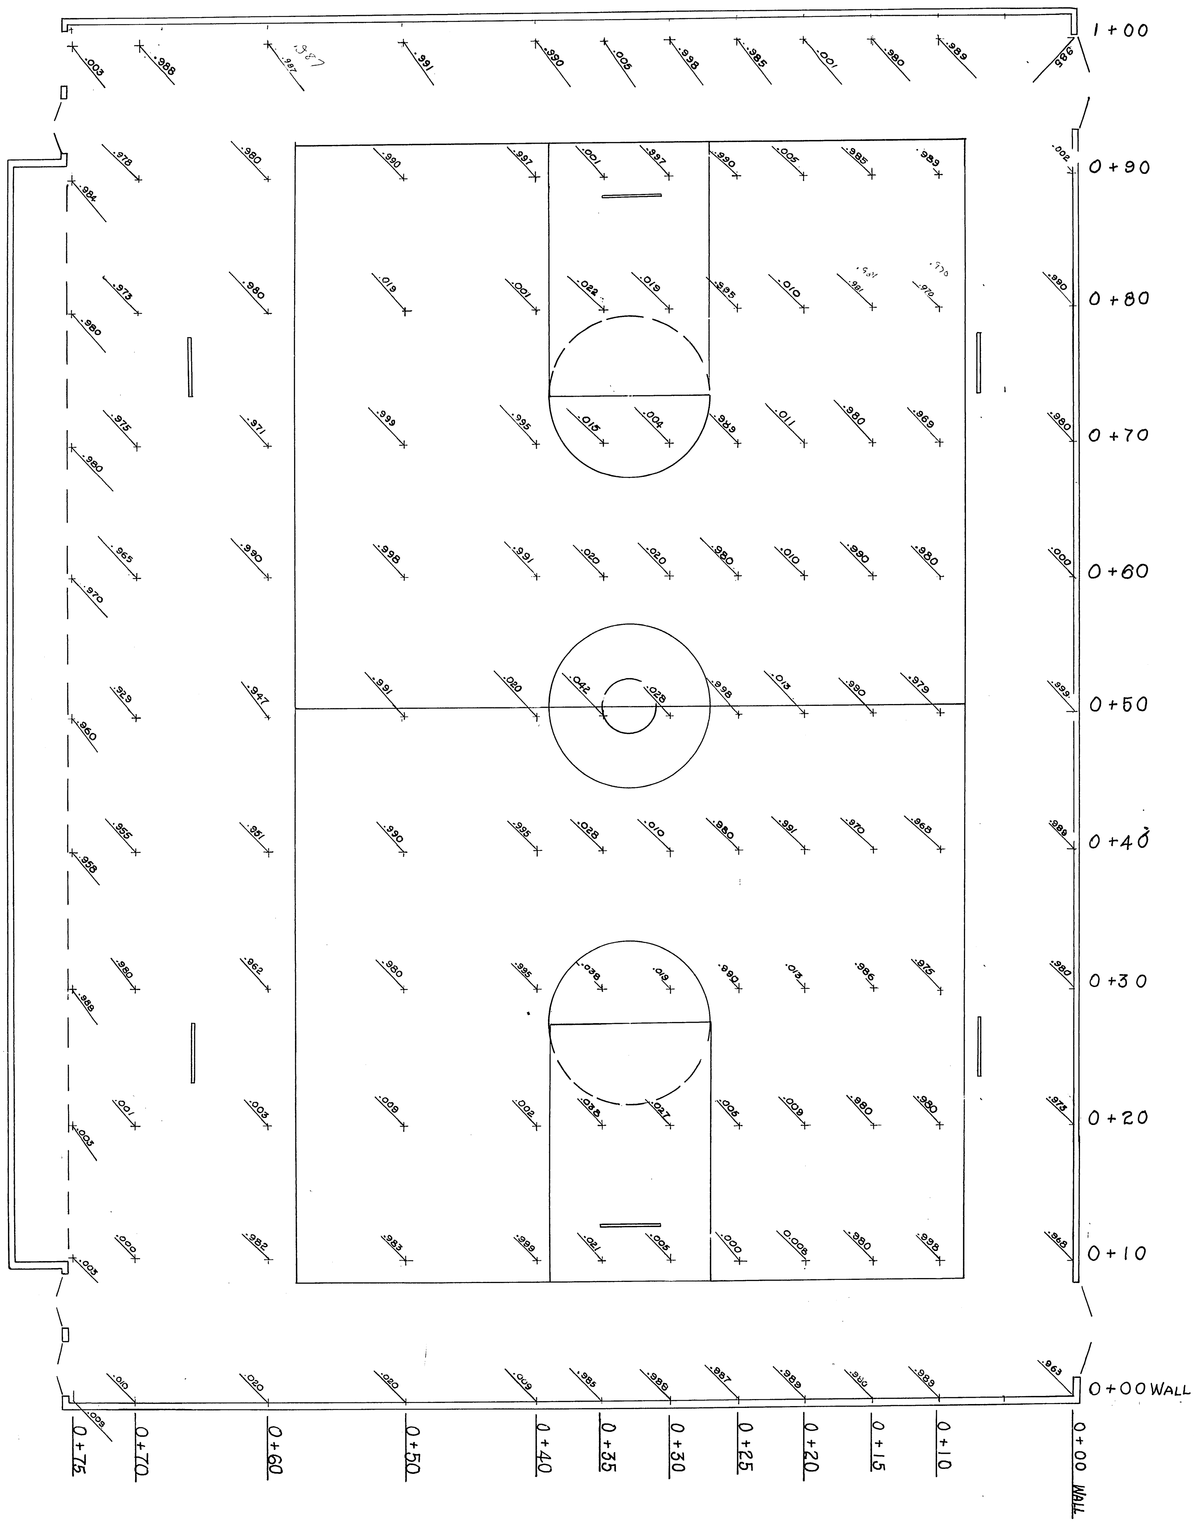

Drawing no. 671-534	**Department of Public Services**	**Engineering Design Division**	Scale (h) 1" = 5'	Scale (v)	W.A. 0010
	STEWART-MOJAVE REC. CENTER	BASKETBALL FLOOR CONTOUR	Fld. bk. no.	Date 12-10-80	
			Design by	Drawn by J. CROMWELL	
					Revisions / Date

93-3-75