

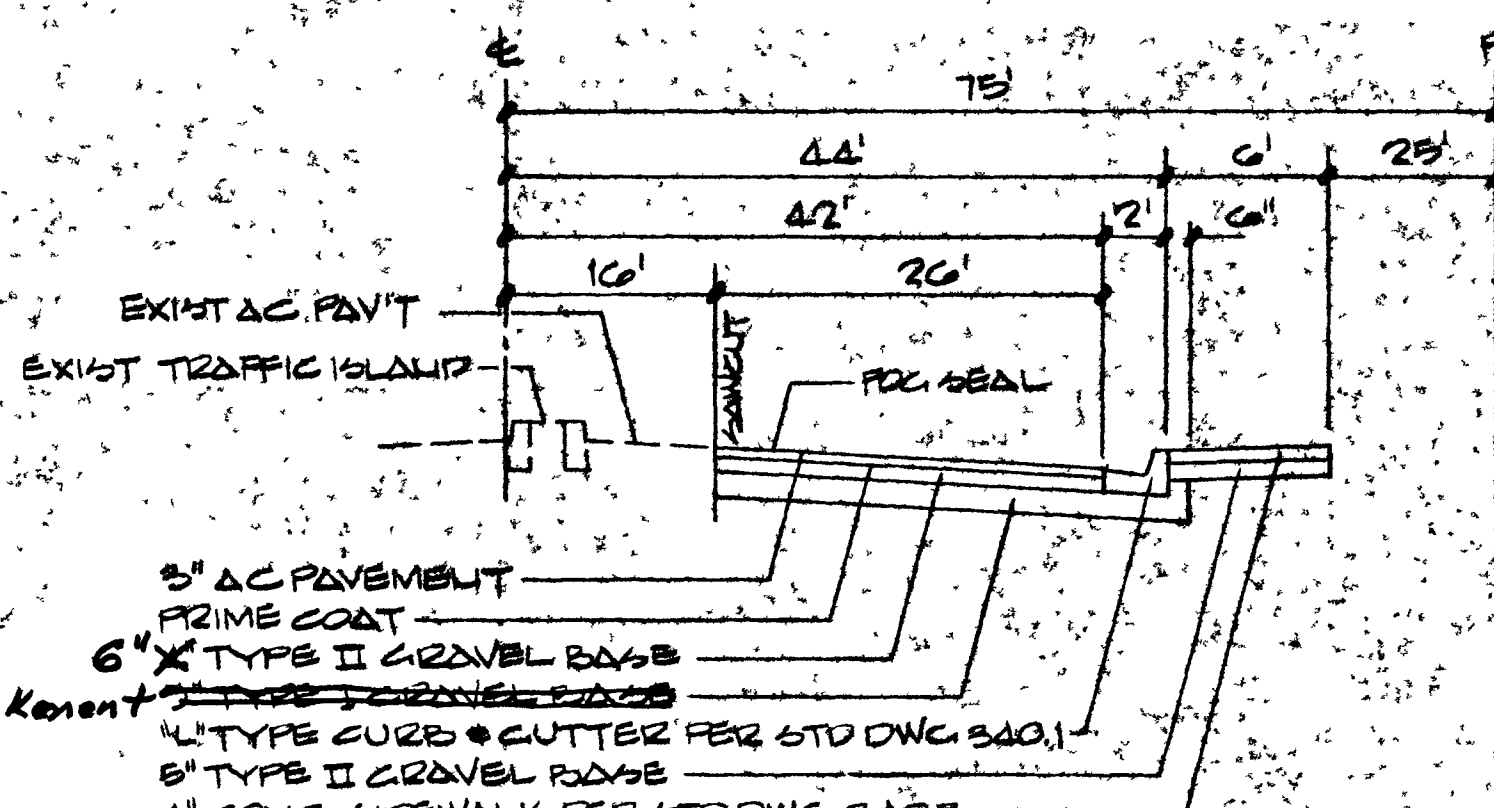


GENERAL NOTES:

- ALL CONSTRUCTION SHALL CONFORM TO THE LATEST REVISED UNIFORM STANDARD SPECIFICATIONS AND DRAWINGS FOR PUBLIC WORKS CONSTRUCTION, CLARK COUNTY AREA, NEVADA.
- COMPLIANCE WITH AIR POLLUTION CONTROL REGULATIONS WILL BE REQUIRED AT ALL TIMES.

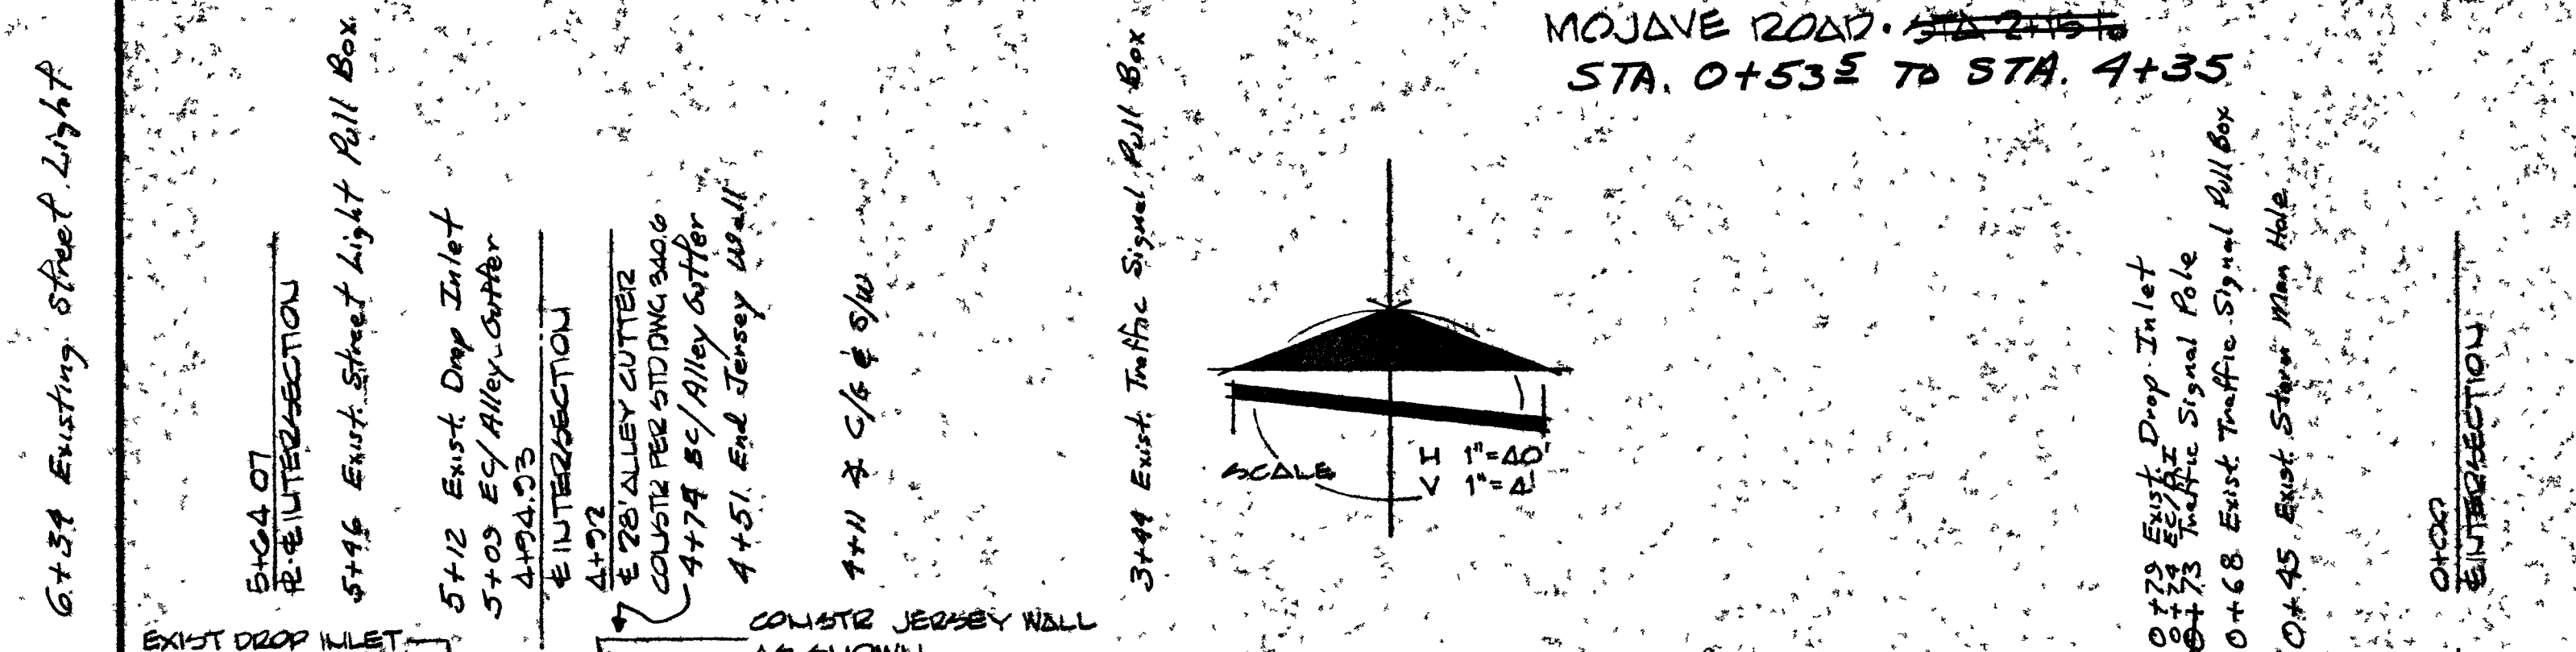

HALF STREET SECTION

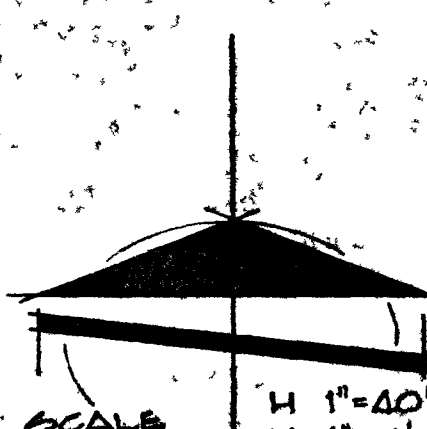

STEWART AVENUE

All Underground on Stewart Ave. Was existing prior to this project.


