



9-13-73

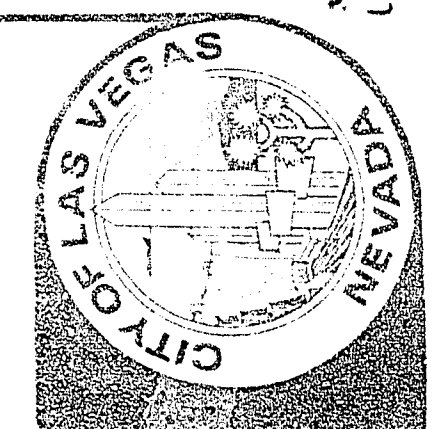

City of Las Vegas, Nevada Department of Design and Development Thomas D. Graham, AICP, R.A., Director	
DESIGN BY: DAI/CML	SCALE: 1/8"=1'-0"
DRAWN BY: CML	DATE: 8-86


REVISIONS	DATE

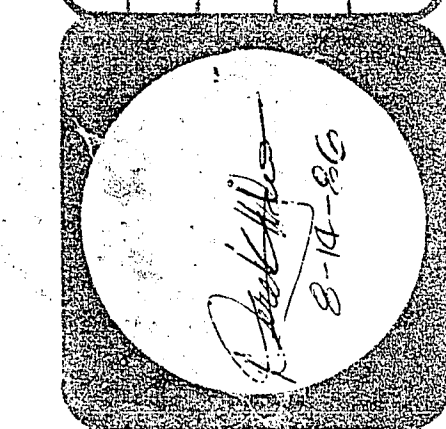

ANGEL PARK PHASE IIB
SITE LANDSCAPE PLAN



PROJECT NO. WU6292
DRAWING NO. 650.14-V10
SHEET F-1
OF 36

DEDUCTIVE ITEMS 3 & 4

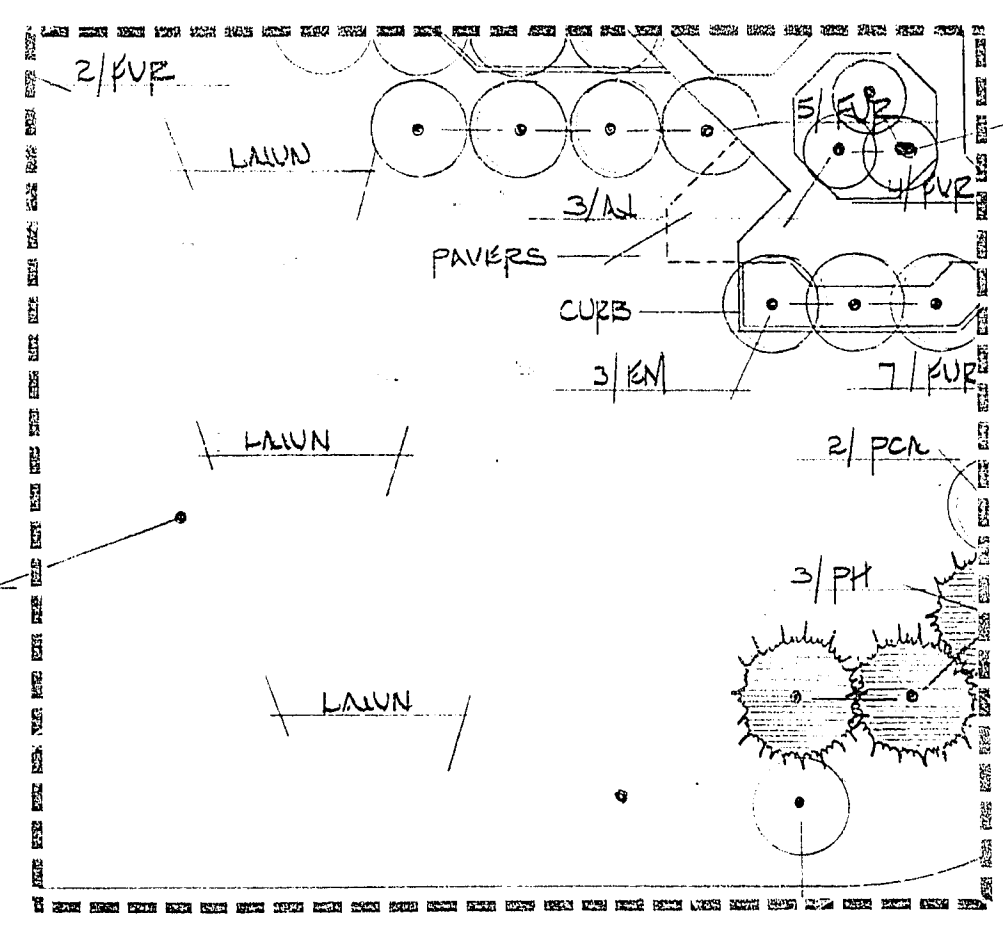

DEDUCTIVE ITEM #4
TENNIS COURT, REPLACE
COURT & REEKS W/
LAWN, ADJUST PAVES
CONFIGURATION & ADD
PLANTER CURB.

DEDUCTIVE ITEM #3
SPRAY FOUNTAIN, REPLACE
W/ TREES & SOIL MIX
LANDSCAPE SOIL MIX.
LAWN PLANTING TO BE
PLANTED BY OTHERS.

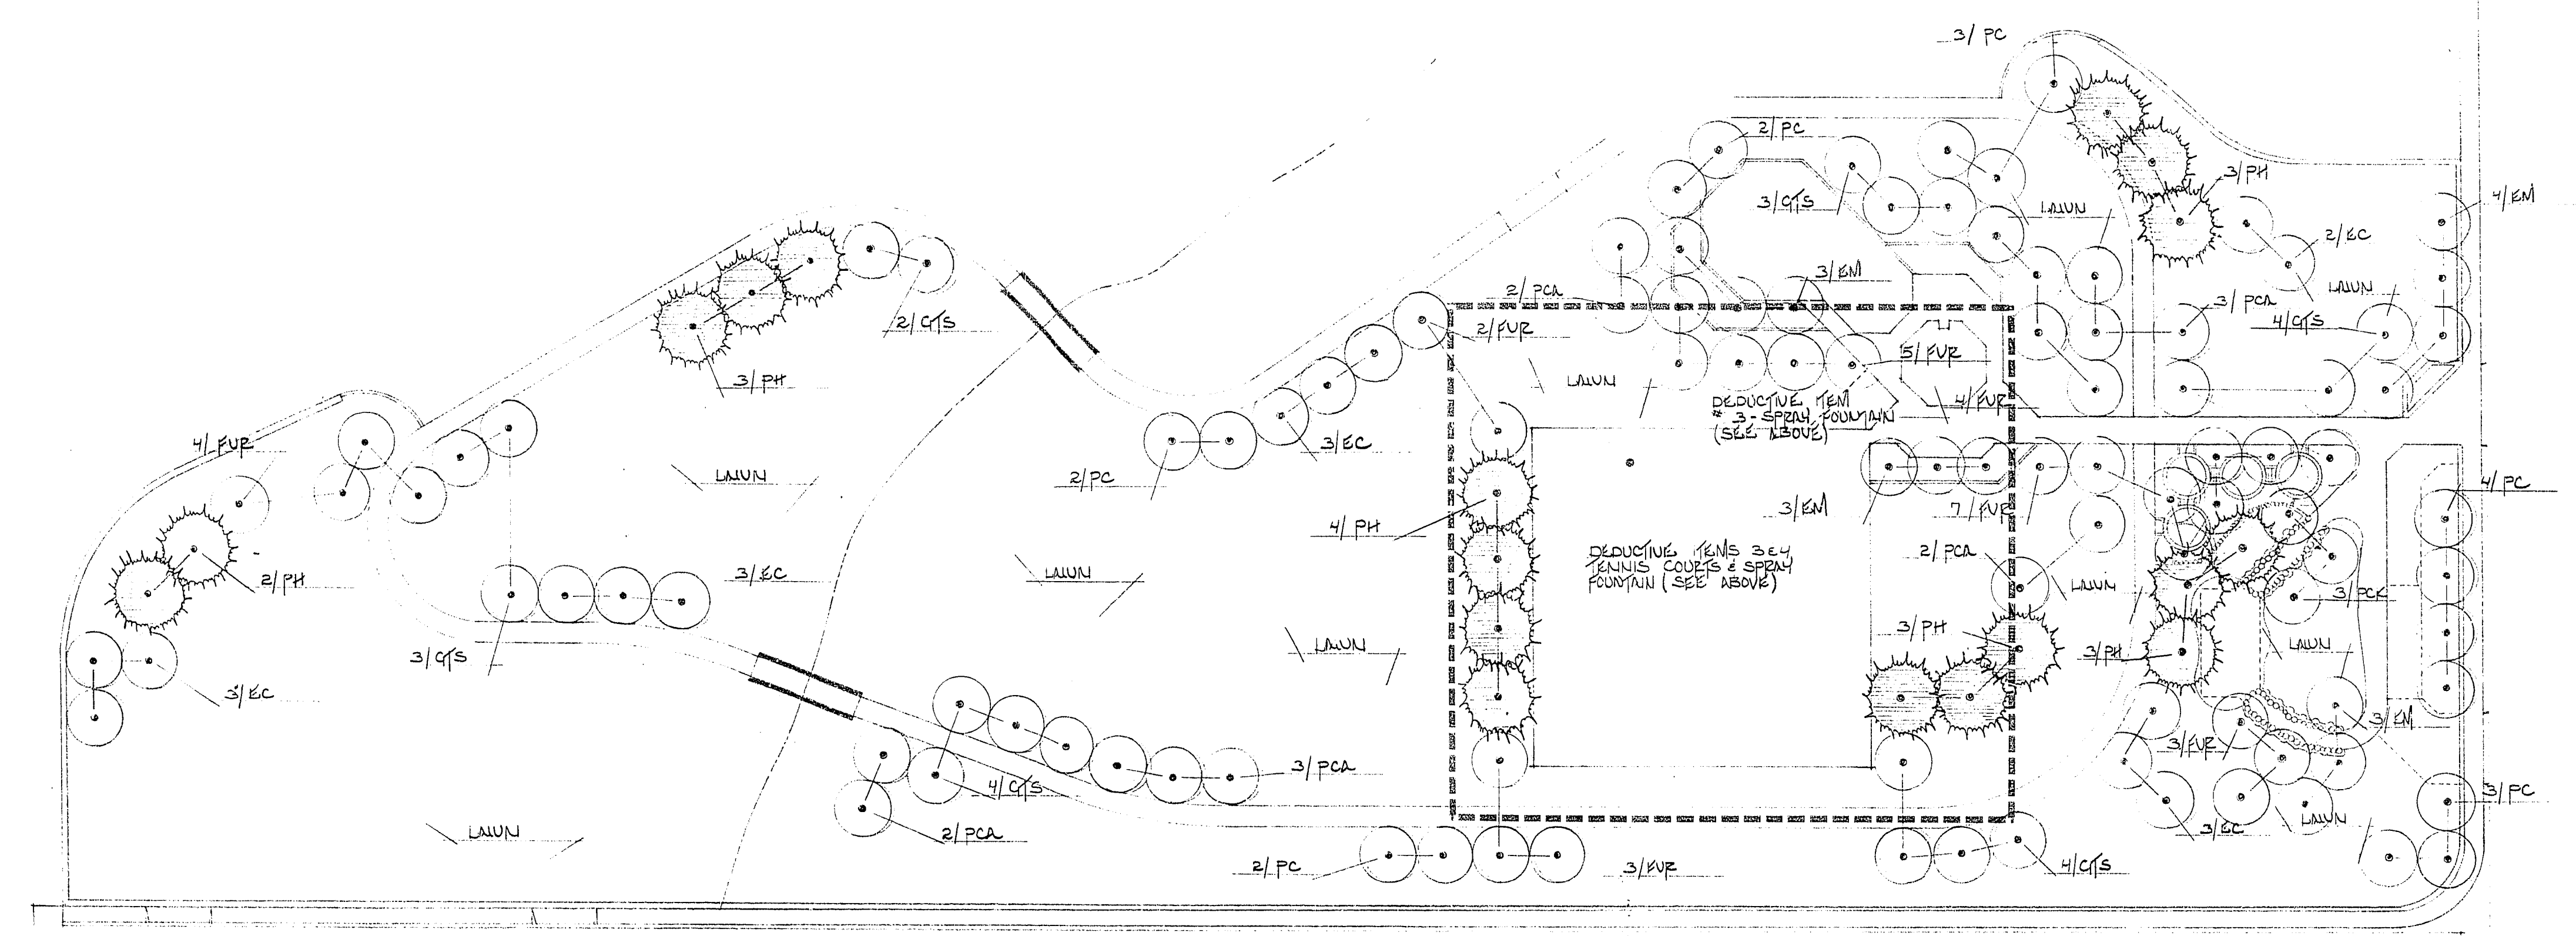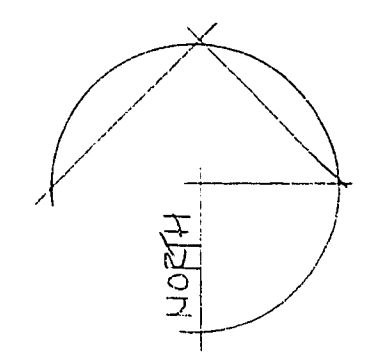

VENETIAN

STRADA

DRAWN