
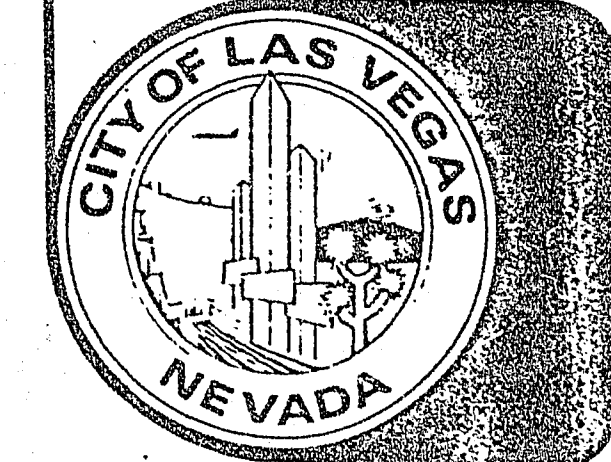


agency	approved	date
Deputy City Manager	<i>[Signature]</i>	5-15-86
Director of Design & Development	<i>[Signature]</i>	5-15-86
Chief of Landscape Design	<i>[Signature]</i>	5-15-86
City Engineer	<i>[Signature]</i>	5-15-86
Chief of Civil Engineering	<i>[Signature]</i>	5-15-86
Chief of Traffic Engineering	<i>[Signature]</i>	5-15-86
City Project Administrator	N A	
Chief of Project Control	<i>[Signature]</i>	5-15-86
Chief of Construction Services	<i>[Signature]</i>	5-15-86
Director of General Services	<i>[Signature]</i>	5-15-86
Chief of Maintenance	<i>[Signature]</i>	5-15-86
Director of Parks, Recreation & Senior Activities	<i>[Signature]</i>	5-15-86
Director of Public Services	<i>[Signature]</i>	5-15-86
Chief of Electrical Services	<i>[Signature]</i>	5-15-86
City of Las Vegas Sanitary Engineer	<i>[Signature]</i>	5-15-86
Director of Community Planning & Development	<i>[Signature]</i>	5-15-86
Director of Building & Safety	<i>[Signature]</i>	5-15-86
Regional Transportation Commission	N A	
Nevada State Department of Transportation	N A	
Central Telephone Company	N A	
Las Vegas Valley Water District	<i>[Signature]</i>	5-15-86
Nevada Power Company	<i>[Signature]</i>	5-15-86
Southwest Gas	<i>[Signature]</i>	5-15-86
Cable Television	N A	

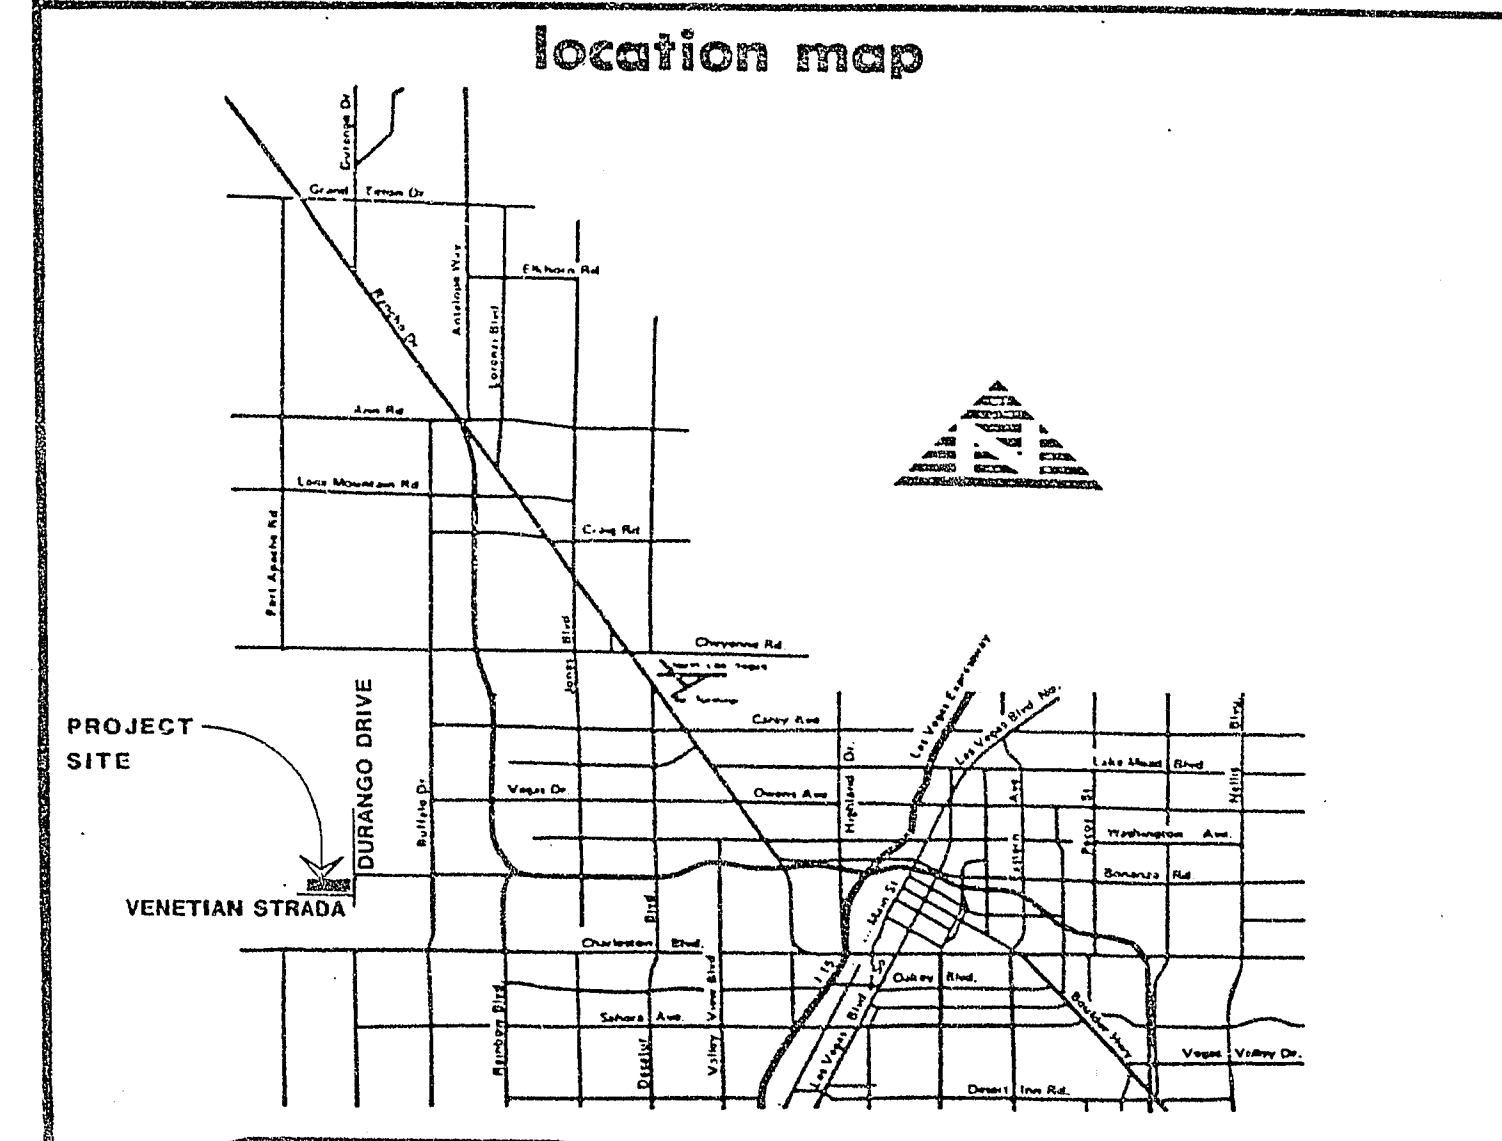

City of Las Vegas

Angel Park Phase II B

BID NO. 86.0830.10

AS - BUILT DRAWINGS

mayor
Bill Briare

councilmen:
Ron Lurie
Al Levy
Bob Nolen
W. Wayne Bunker

city manager:
Ashley Hall

director of design & development:
Thomas B. Graham

4-1-32

Index of sheets				
no.	description			
T-1	TITLE SHEET			
C-1	SITE PLAN			
C-2	JOGGING TRACK&SITE LAYOUT PLAN			
C-3	JOGGING TRACK&SITE GRADING PLAN			
C-3A	EXISTING TOPOGRAPHIC SURVEY			
C-4	ENLARG. LAYOUT.GDING..DTS.-PLAY LOT&SPRAY			
C-5	TENNIS COURTS-PLAN & DETAILS			
C-6	SITE DETAILS			
C-7	SITE DETAILS			
C-8	RESTROOM AREA GEOMETRICS			
C-9	RESTROOM AREA GRADING PLAN			
C-10	RESTROOM AREA UTILITY PLAN			
C-11	RESTROOM AREA SECTIONS & DETAILS			
C-12	RESTROOM AREA SECTIONS & DETAILS			
C-13	IRRIGATION SYS. BOOSTER PUMP INSTALL.			
C-14	STREET & STREETLIGHT DESIGN-DURANGO			
C-15	STR.&STREETLIGHT DESIGN-VENETIAN STRADA			
C-16	STR.&STREETLIGHT DESIGN-VENETIAN STRADA			
C-17	VENETIAN STRADA CULVERT- PLAN & PROFILE			
C-18	VENETIAN STRADA CVT.-DETAILS.NOTES&QUAN			
A-1	RESTROOM PLANS			
A-2	RESTROOM SECTIONS & ROOF PLAN			
A-3	RESTROOM SECTIONS & DETAILS			
A-4	GENERAL NOTES			
A-5	BRIDGES & DETAILS			
A-6	PARK SIGN-PLAN & ELEVATIONS			
A-7	PARK SIGN DETAILS			
L-1	SITE LANDSCAPE PLAN			
L-2	ENLARGED LANDSCAPE-PLANTER AREAS			
L-3	LANDSCAPE SCHEDULE & DETAILS			
I-1	SITE IRRIGATION PLAN			
I-1A	SITE IRRIGATION PLAN- DEDUCTIVE ITEMS 3&4			
I-2	ENLARG. IRRIGATION-PLANTER/SCHEDULE			
I-3	IRRIGATION DETAILS			
E-1	SITE ELECTRICAL PLAN & DETAILS			
E-2	ELEC. FL. PLAN,DIAGRAMS,ELEVATIONS			
revisions				
no.	description	by	date	app.

