9-13-74

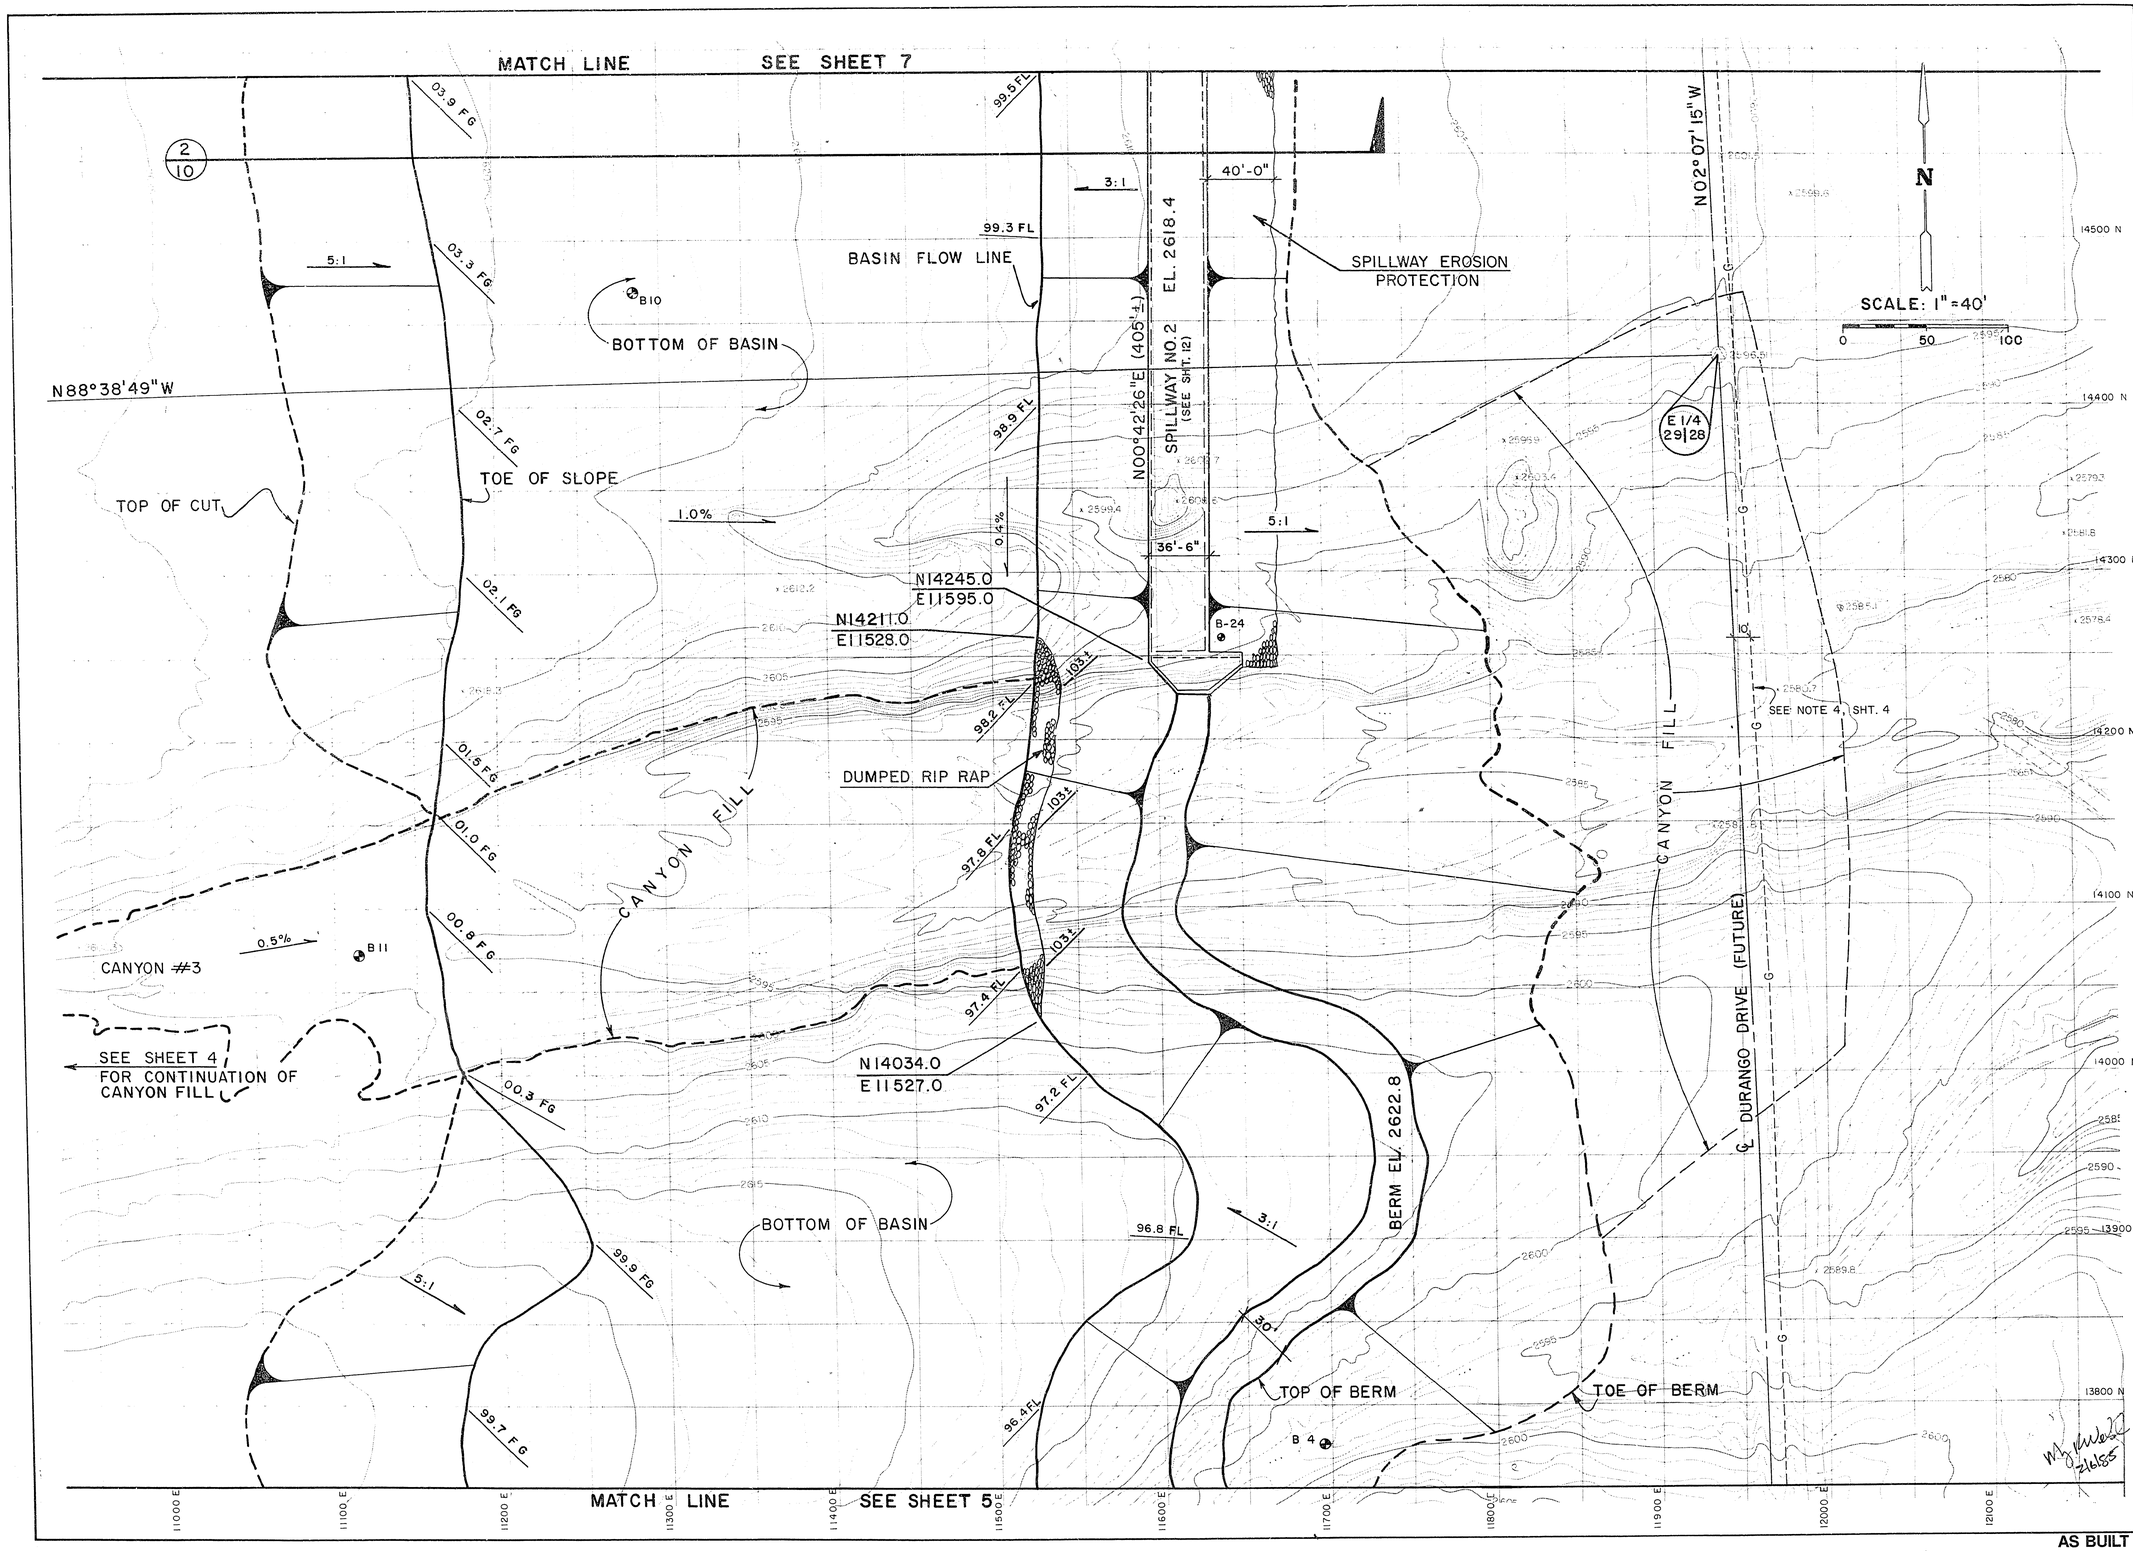

REV	DATE	BY	REVISION

CONSULTING ENGINEERS • PLANNERS
2300 PASEO DEL PRADO BUILDING A SUITE 100
LAS VEGAS, NEVADA 89102 PHONE (702) 873-7550

CITY OF LAS VEGAS, NEVADA

vtn nevada

TITLE: GRADING PLAN 2

PROJECT: ANGEL PARK DETENTION BASIN PHASE IIB

WO NO.	3061/B
BY	VJS/RLG
DATE	2/6/85
SCALE	1" = 40'

SHEET 6 OF 16 SHEETS

AS BUILT

650.14-V9