


9-13-93

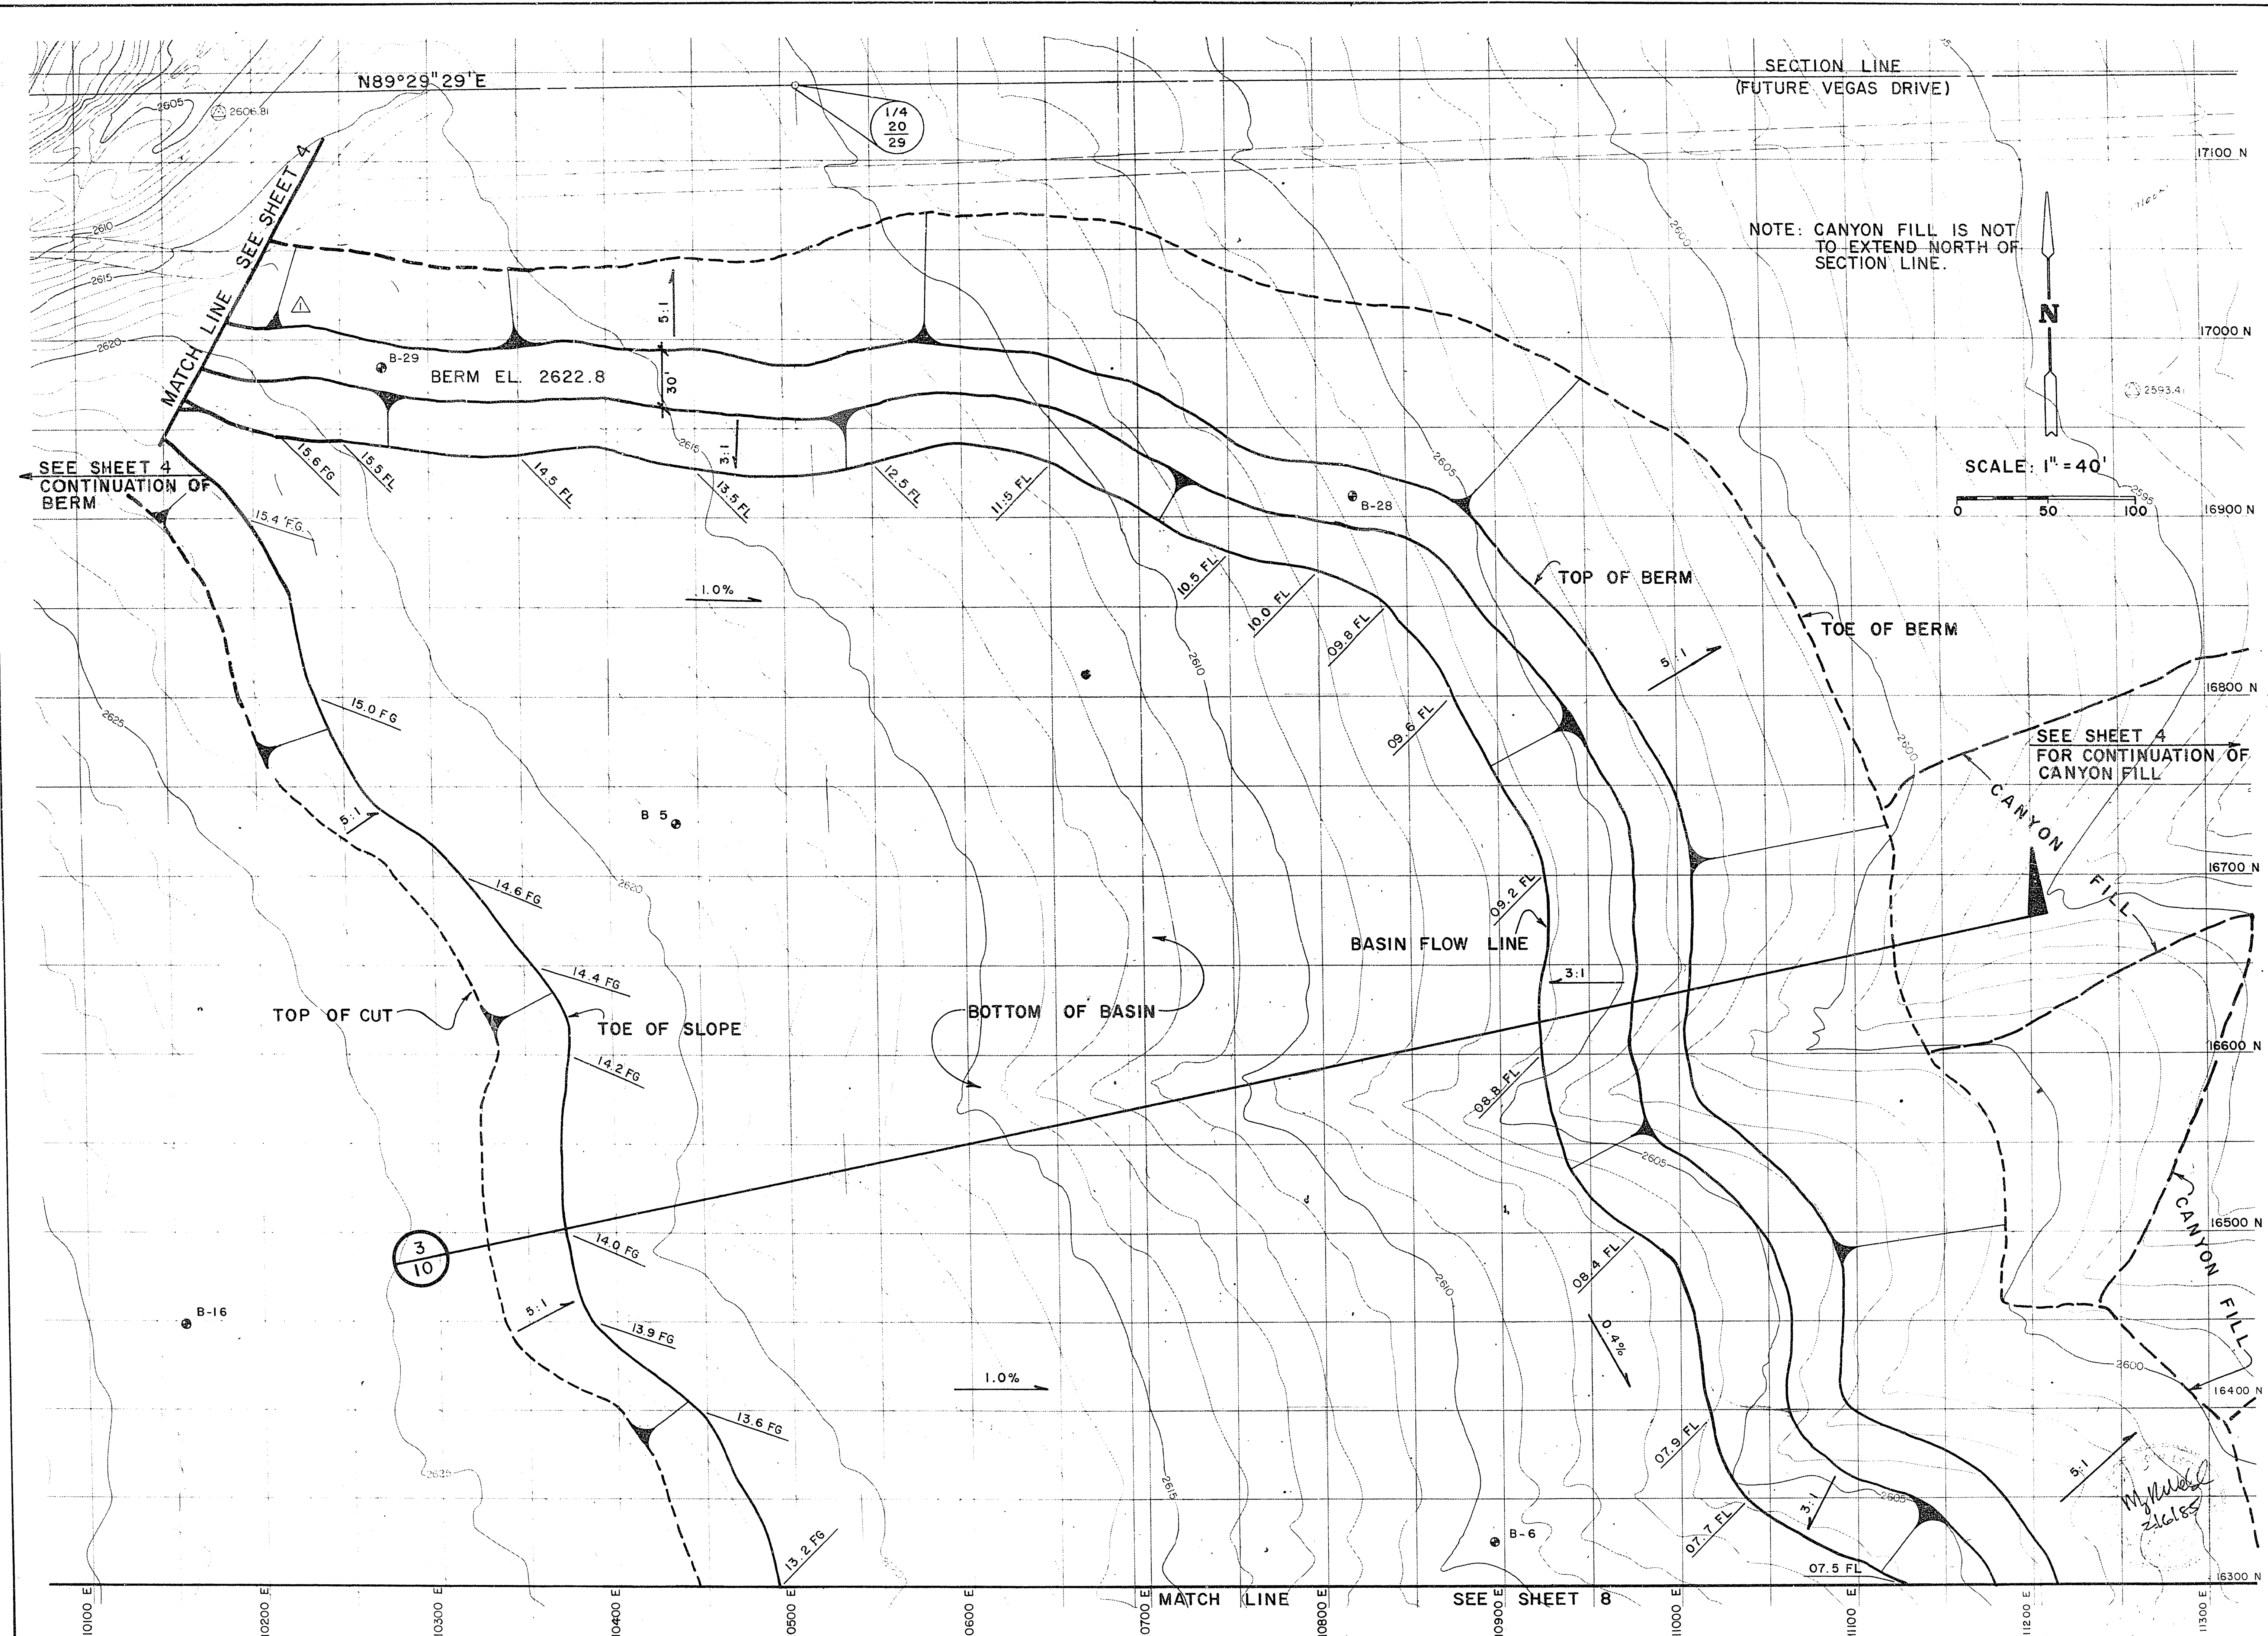

REV	DATE	BY	REVISION
1	7-29-93	MRW	GRADING

CITY OF LAS VEGAS, NEVADA

GRADING PLAN 5

ANGEL PARK DETENTION BASIN PHASE II B

PLANNERS
CONSULTING ENGINEERS • BUILDING A SUITE 100
2300 PASEO DEL PRADO, LAS VEGAS, NEVADA 89102 PHONE (702) 873-7550

PROJECT

WO NO. 3061/B
BY VJS/RLG
DATE 2/6/85
SCALE 1" = 40'

SHEET 9 OF 16 SHEETS

650.14-V8