9-13-126

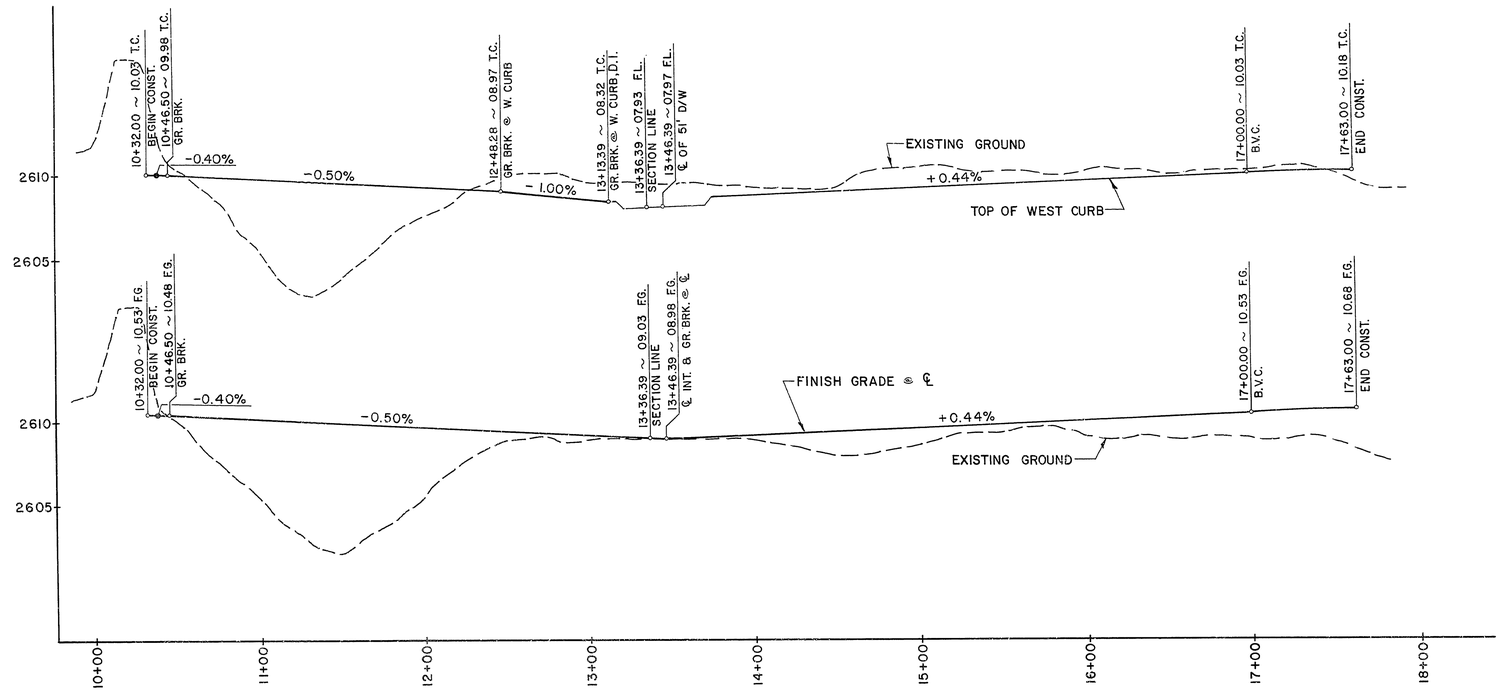

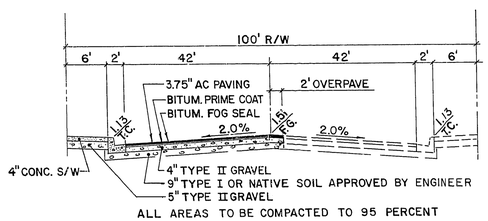

TYPICAL STREET SECTION

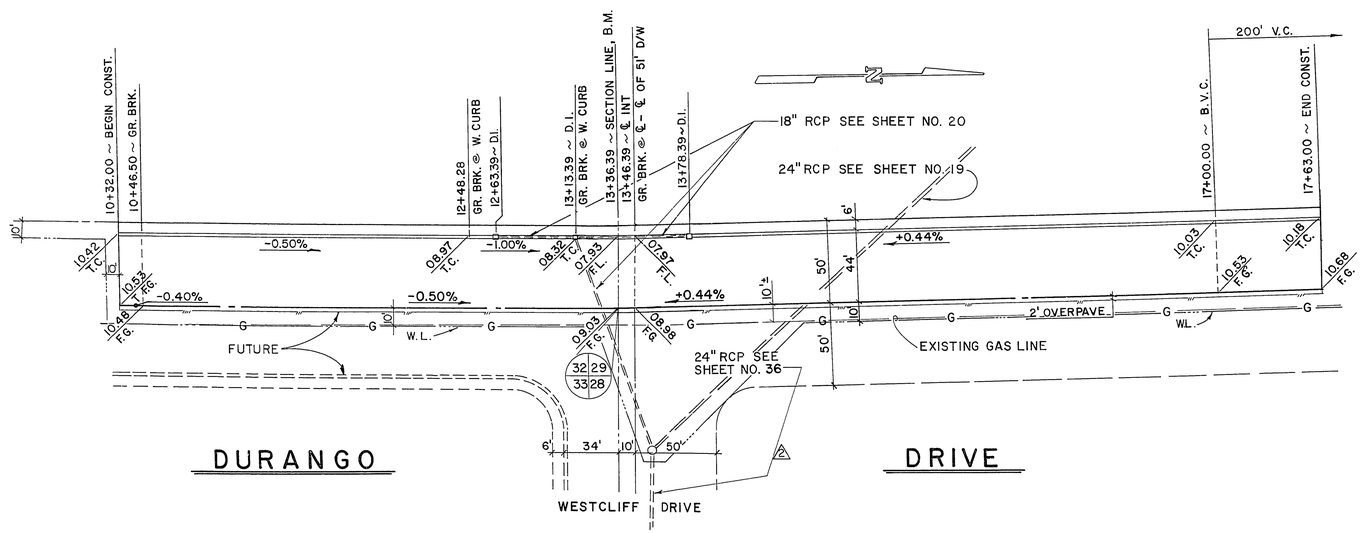

AS BUILT
11/15/84

REV.	DATE	BY	REVISION
1	11/1/83	E D Y	LOC. MH #32
2	1/24/84	MW	REV. PER ADDENDUM #1

CONSULTING ENGINEERS • PLANNERS
2800 WEST SAHARA AVENUE BUILDING 4 SUITE B
LAS VEGAS, NEVADA 89102 PHONE (702) 873-7550

VTN nevada

TITLE: STREET PLAN & PROFILE
DURANGO DRIVE

PROJECT: ANGEL PARK DETENTION BASIN
PHASE IIA

WO NO.	3061
BY	RPF/MJB/ED
DATE	10/2/83
SCALE HOR.	1" = 40'
VERT.	1" = 4'

SHEET 23 OF 36 SHEETS

650.14-7