
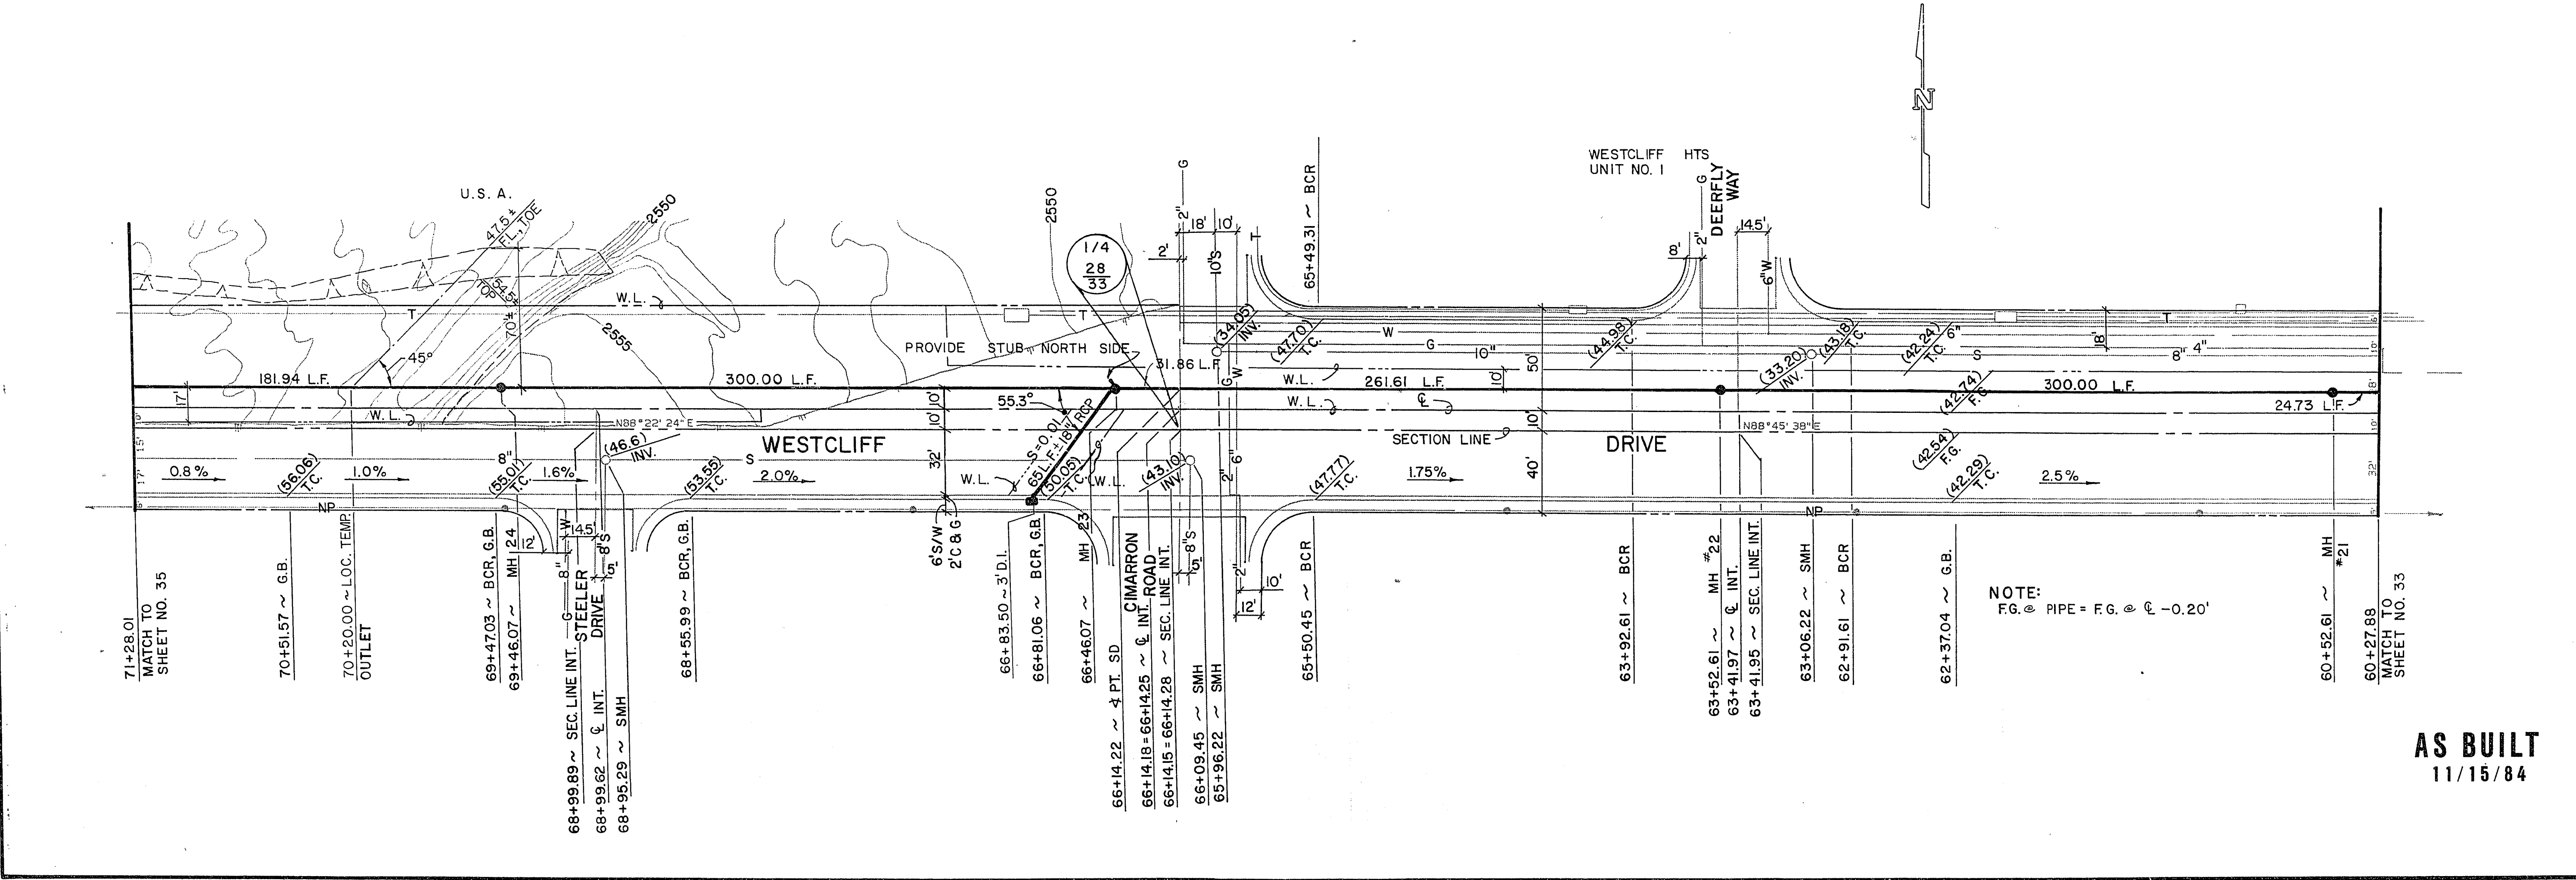


9-13-136

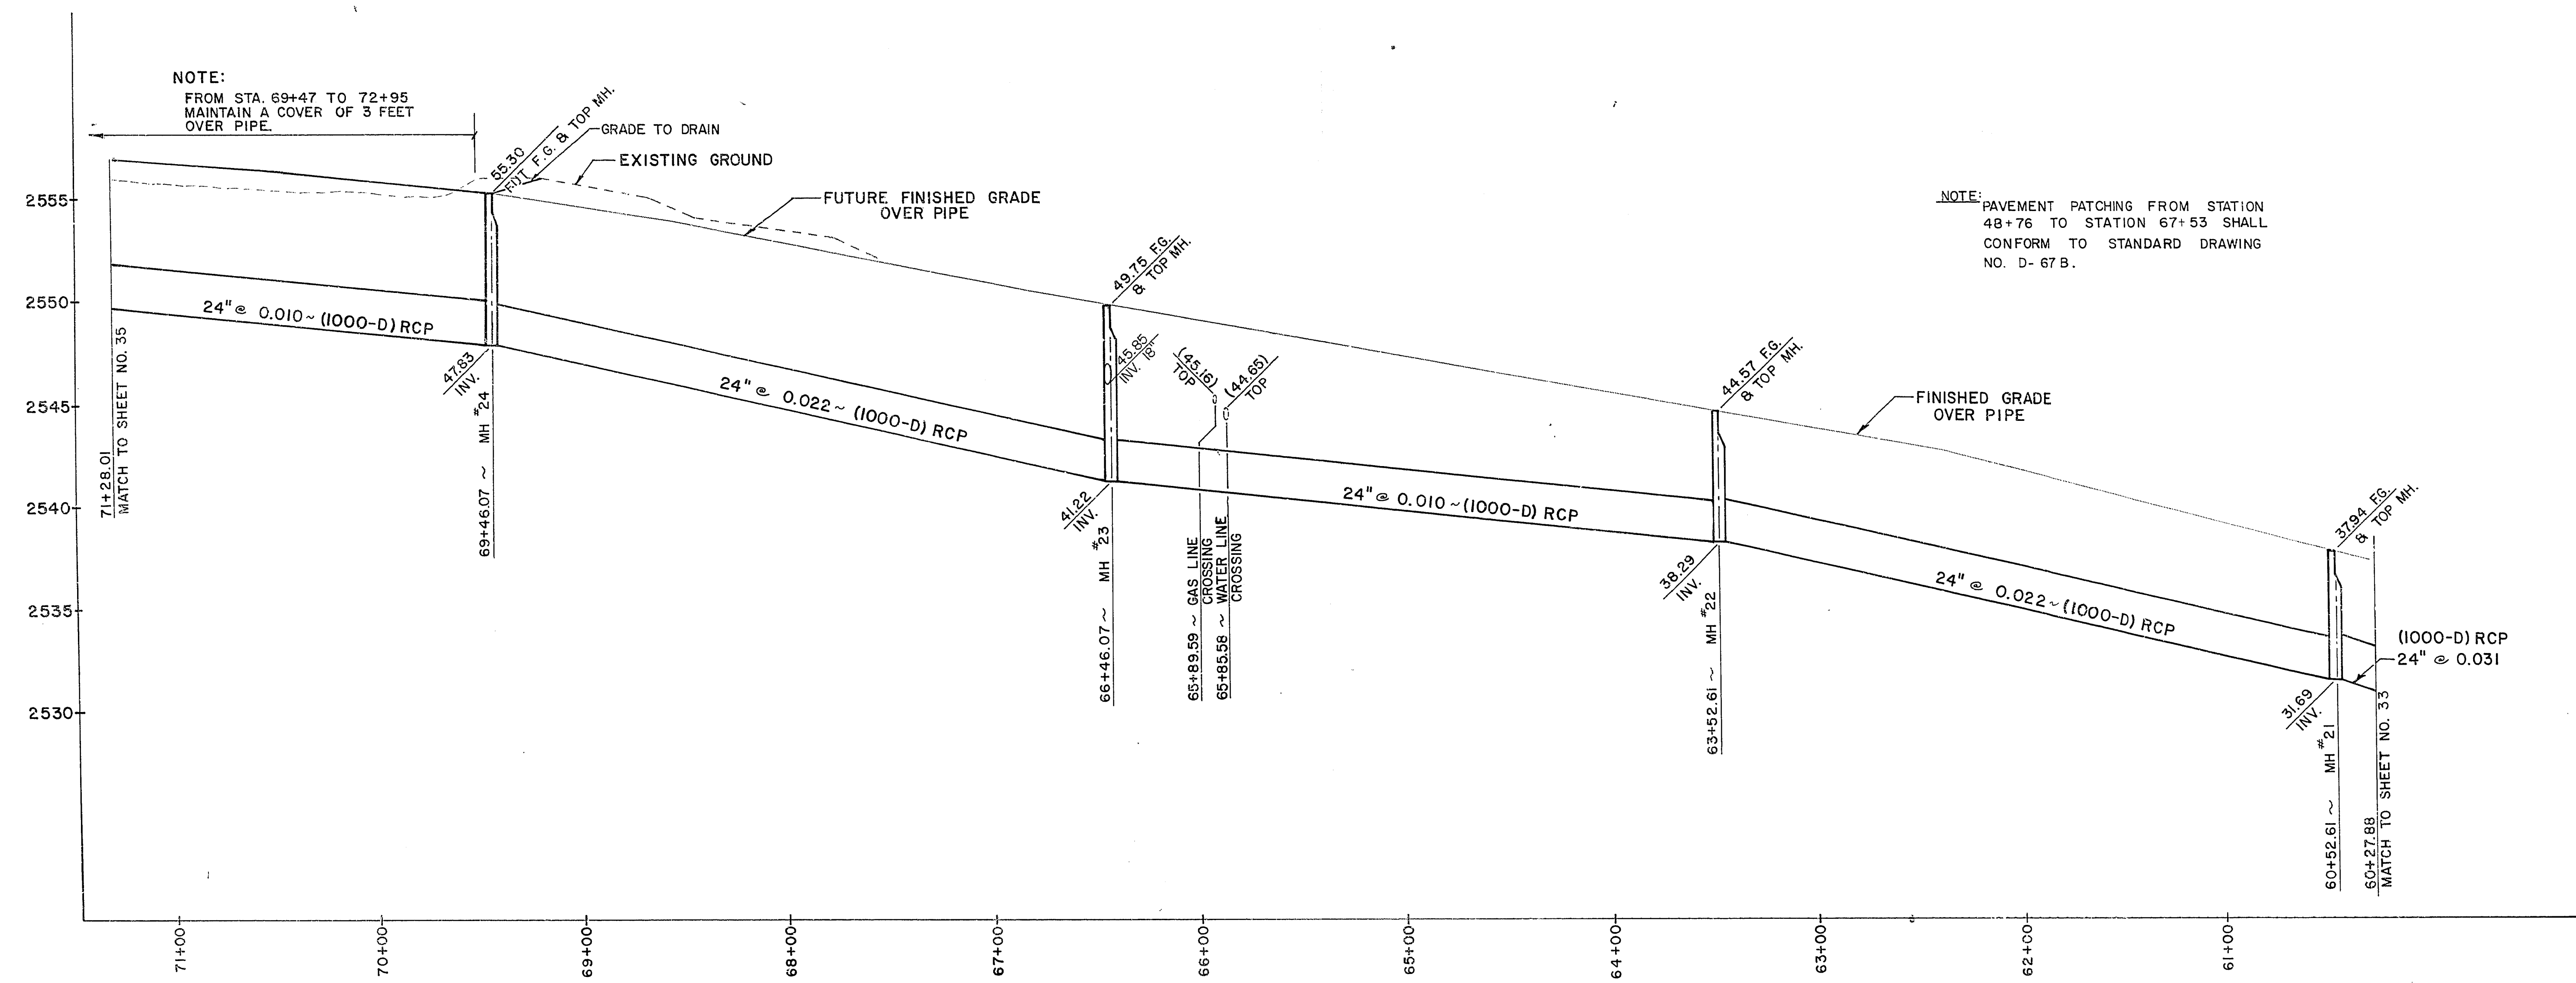

REVISION	
REV.	DATE
1	10/26/83 RPF
2	10/28/83 EBY

PLANNERS
ENGINEERS
CONSULTING

2800 WEST SAHARA AVENUE
LAS VEGAS, NEVADA 89102

PHONE (702) 873-7550

neveda

PLAN AND PROFILE

ANGEL PARK OUTLET DRAIN

CITY OF LAS VEGAS

ANGEL PARK DETENTION BASIN

WO NO. 3061

BY MJB/RPF/ED

DATE 10/2/83

SCALE HOR: 1" = 40'

VERT: 1" = 4'

SHEET 34

OF 36 SHEETS

650.14-7