
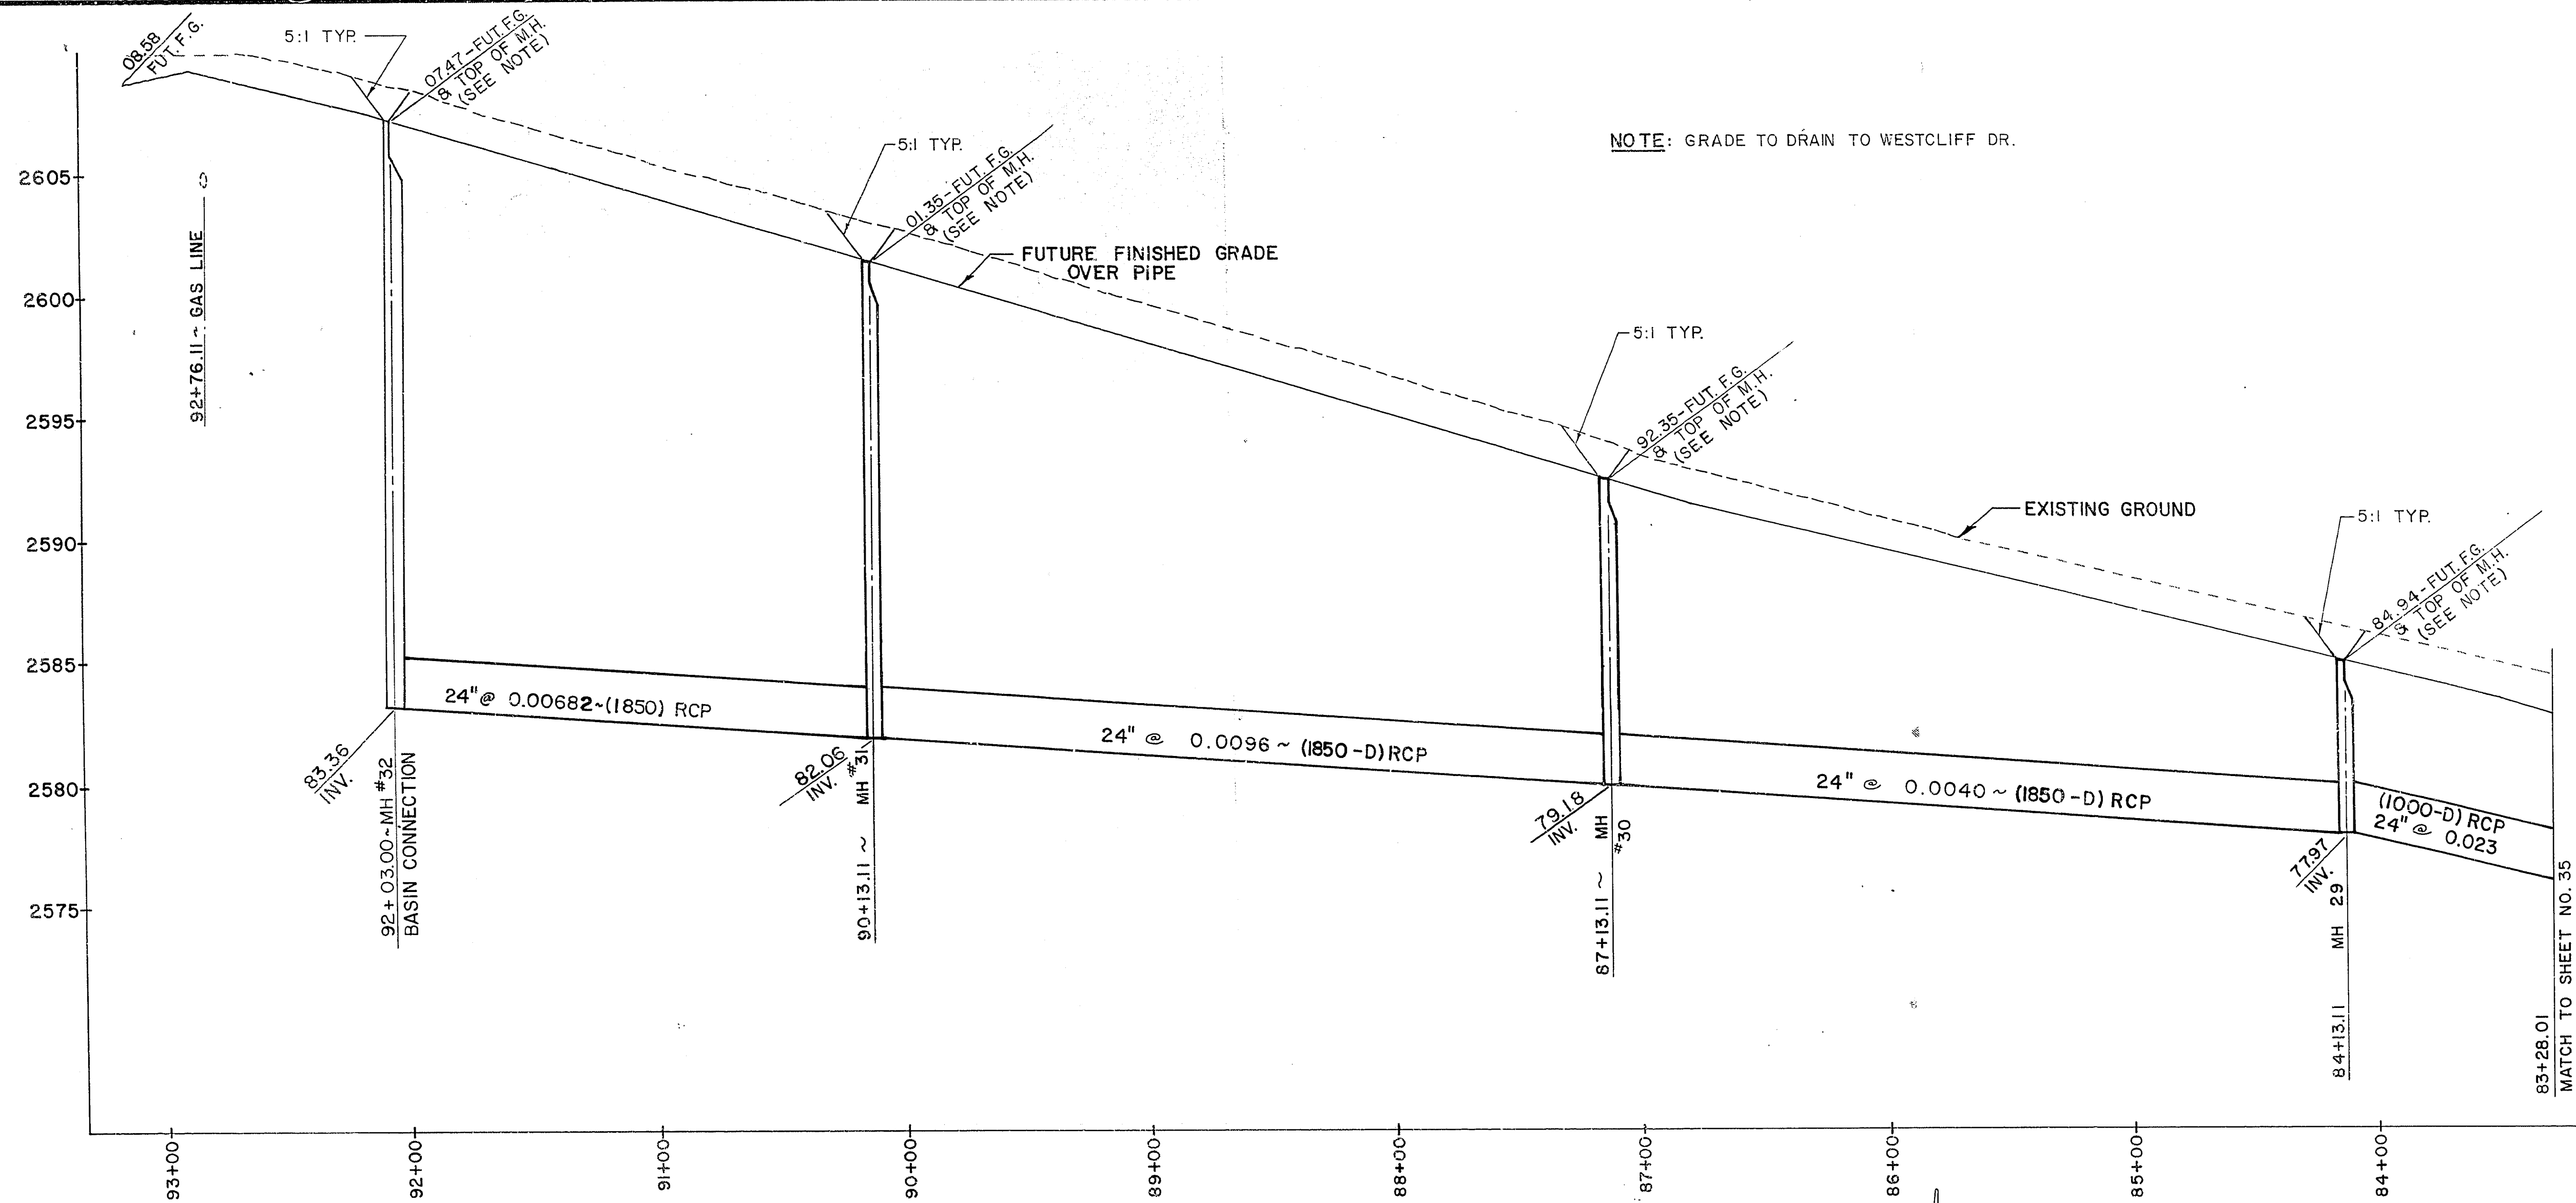


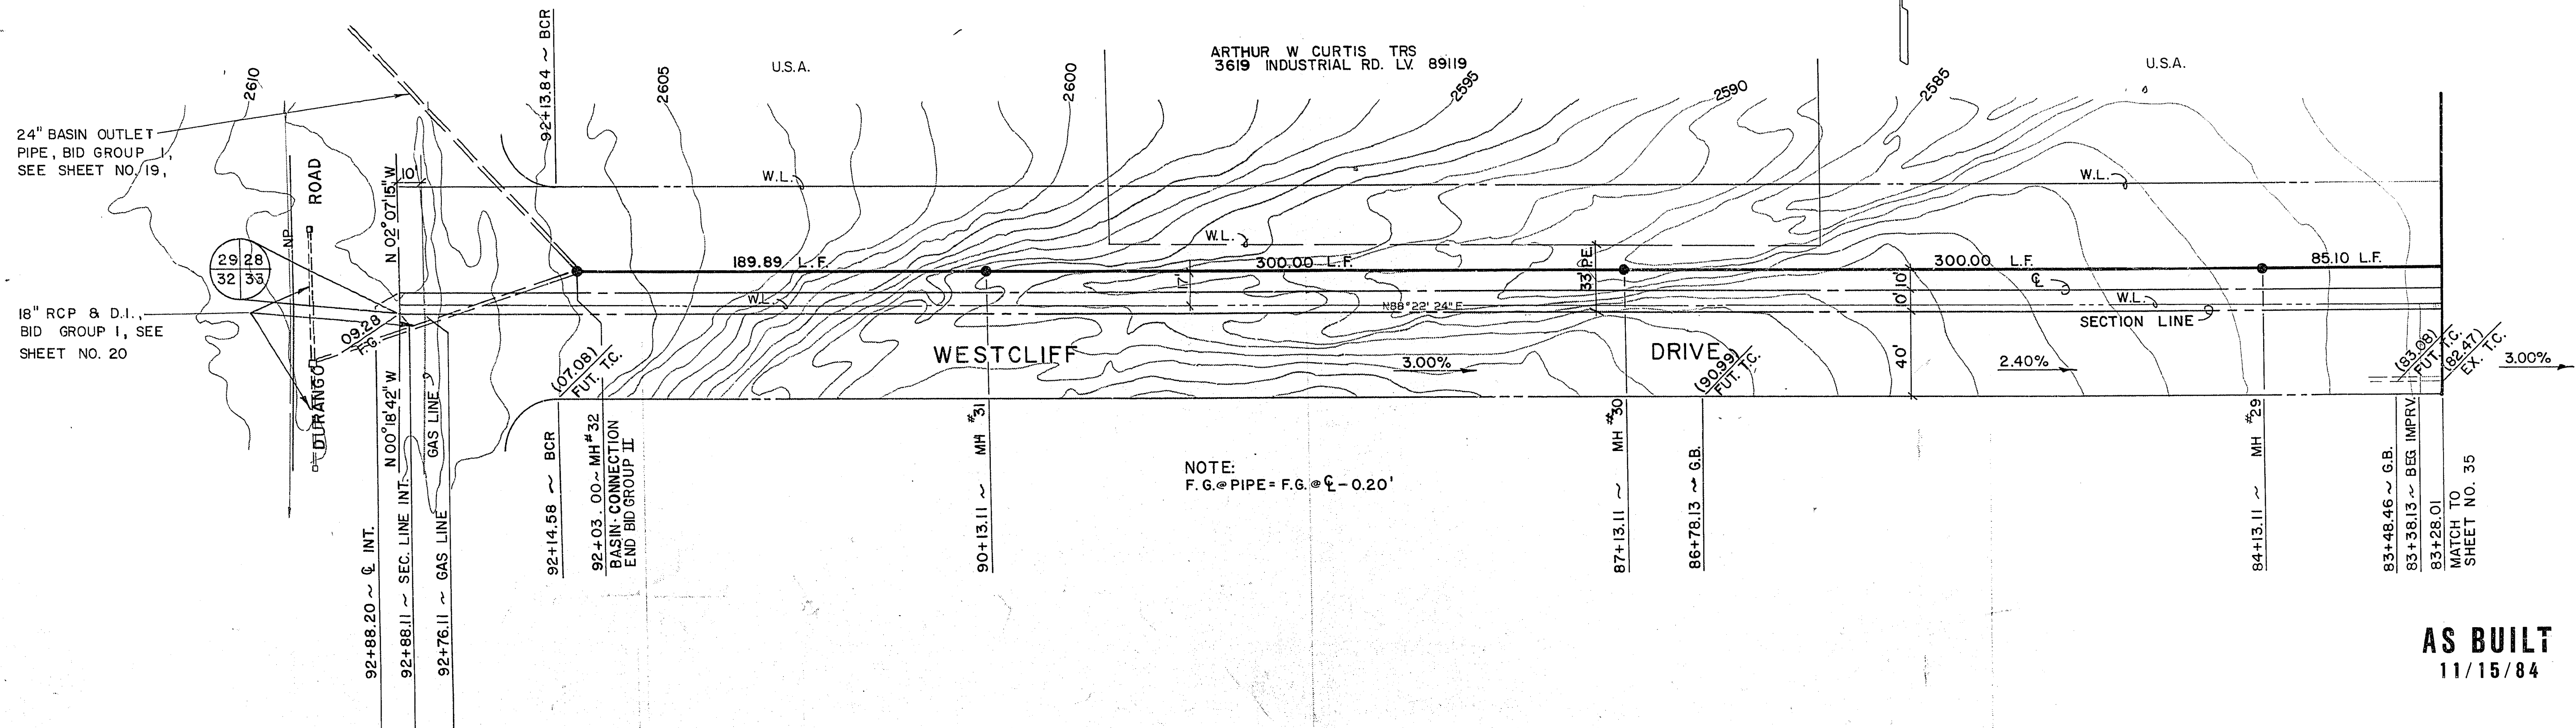

PLAN AND PROFILE

ANGEL PARK OUTLET DRAIN
CITY OF LAS VEGAS
ANGEL PARK DETENTION BASIN

WO NO. 3061
BY MJB/RPF/ED
DATE 10/2/83
SCALE: HOR: 1" = 40'
VERT: 1" = 4'

SHEET 36
OF 36 SHEETS

James H. McNamee

11-2-13

nevada

CONSULTING ENGINEERS
2800 WEST SAHARA AVENUE
LAS VEGAS, NEVADA 89102
PHONE (702) 873-7550

PLANNERS
BUILDING 4 SUITE B

REVISION
1 10/6/83 RPF D-LOADS ADDED
2 11/2/83 RPF ADDED TOP MH. ELEV.
3 10/28/83 EDY ADDED W.L.
4 11/5/83 EDY LOC. MH #32

9-12-18

650.14-7