


- LEGEND**
- TOP OF SLOPE SCARP
 - TOE OF SLOPE EXIST. CONTOUR
 - CHAIN LINK FENCE
 - FINISH GRADE
 - FLOW LINE
 - GAS LINE
 - CENTERLINE STATIONING
 - TOP OF PIPE
 - RIP-RAP AREA
 - PAVING AREA
 - ALTERNATE SPILLWAY APPROACH SLAB
 - EROSION PROTECTION SLAB

BENCH MARK

U.S.G.S. B.L.M. BRASS CAP, NORTHEAST CORNER
SECTION 32, T. 20S, R. 60E, M.D.M., CITY OF
LAS VEGAS, CLARK COUNTY, NEVADA
ELEV. = 2609.31

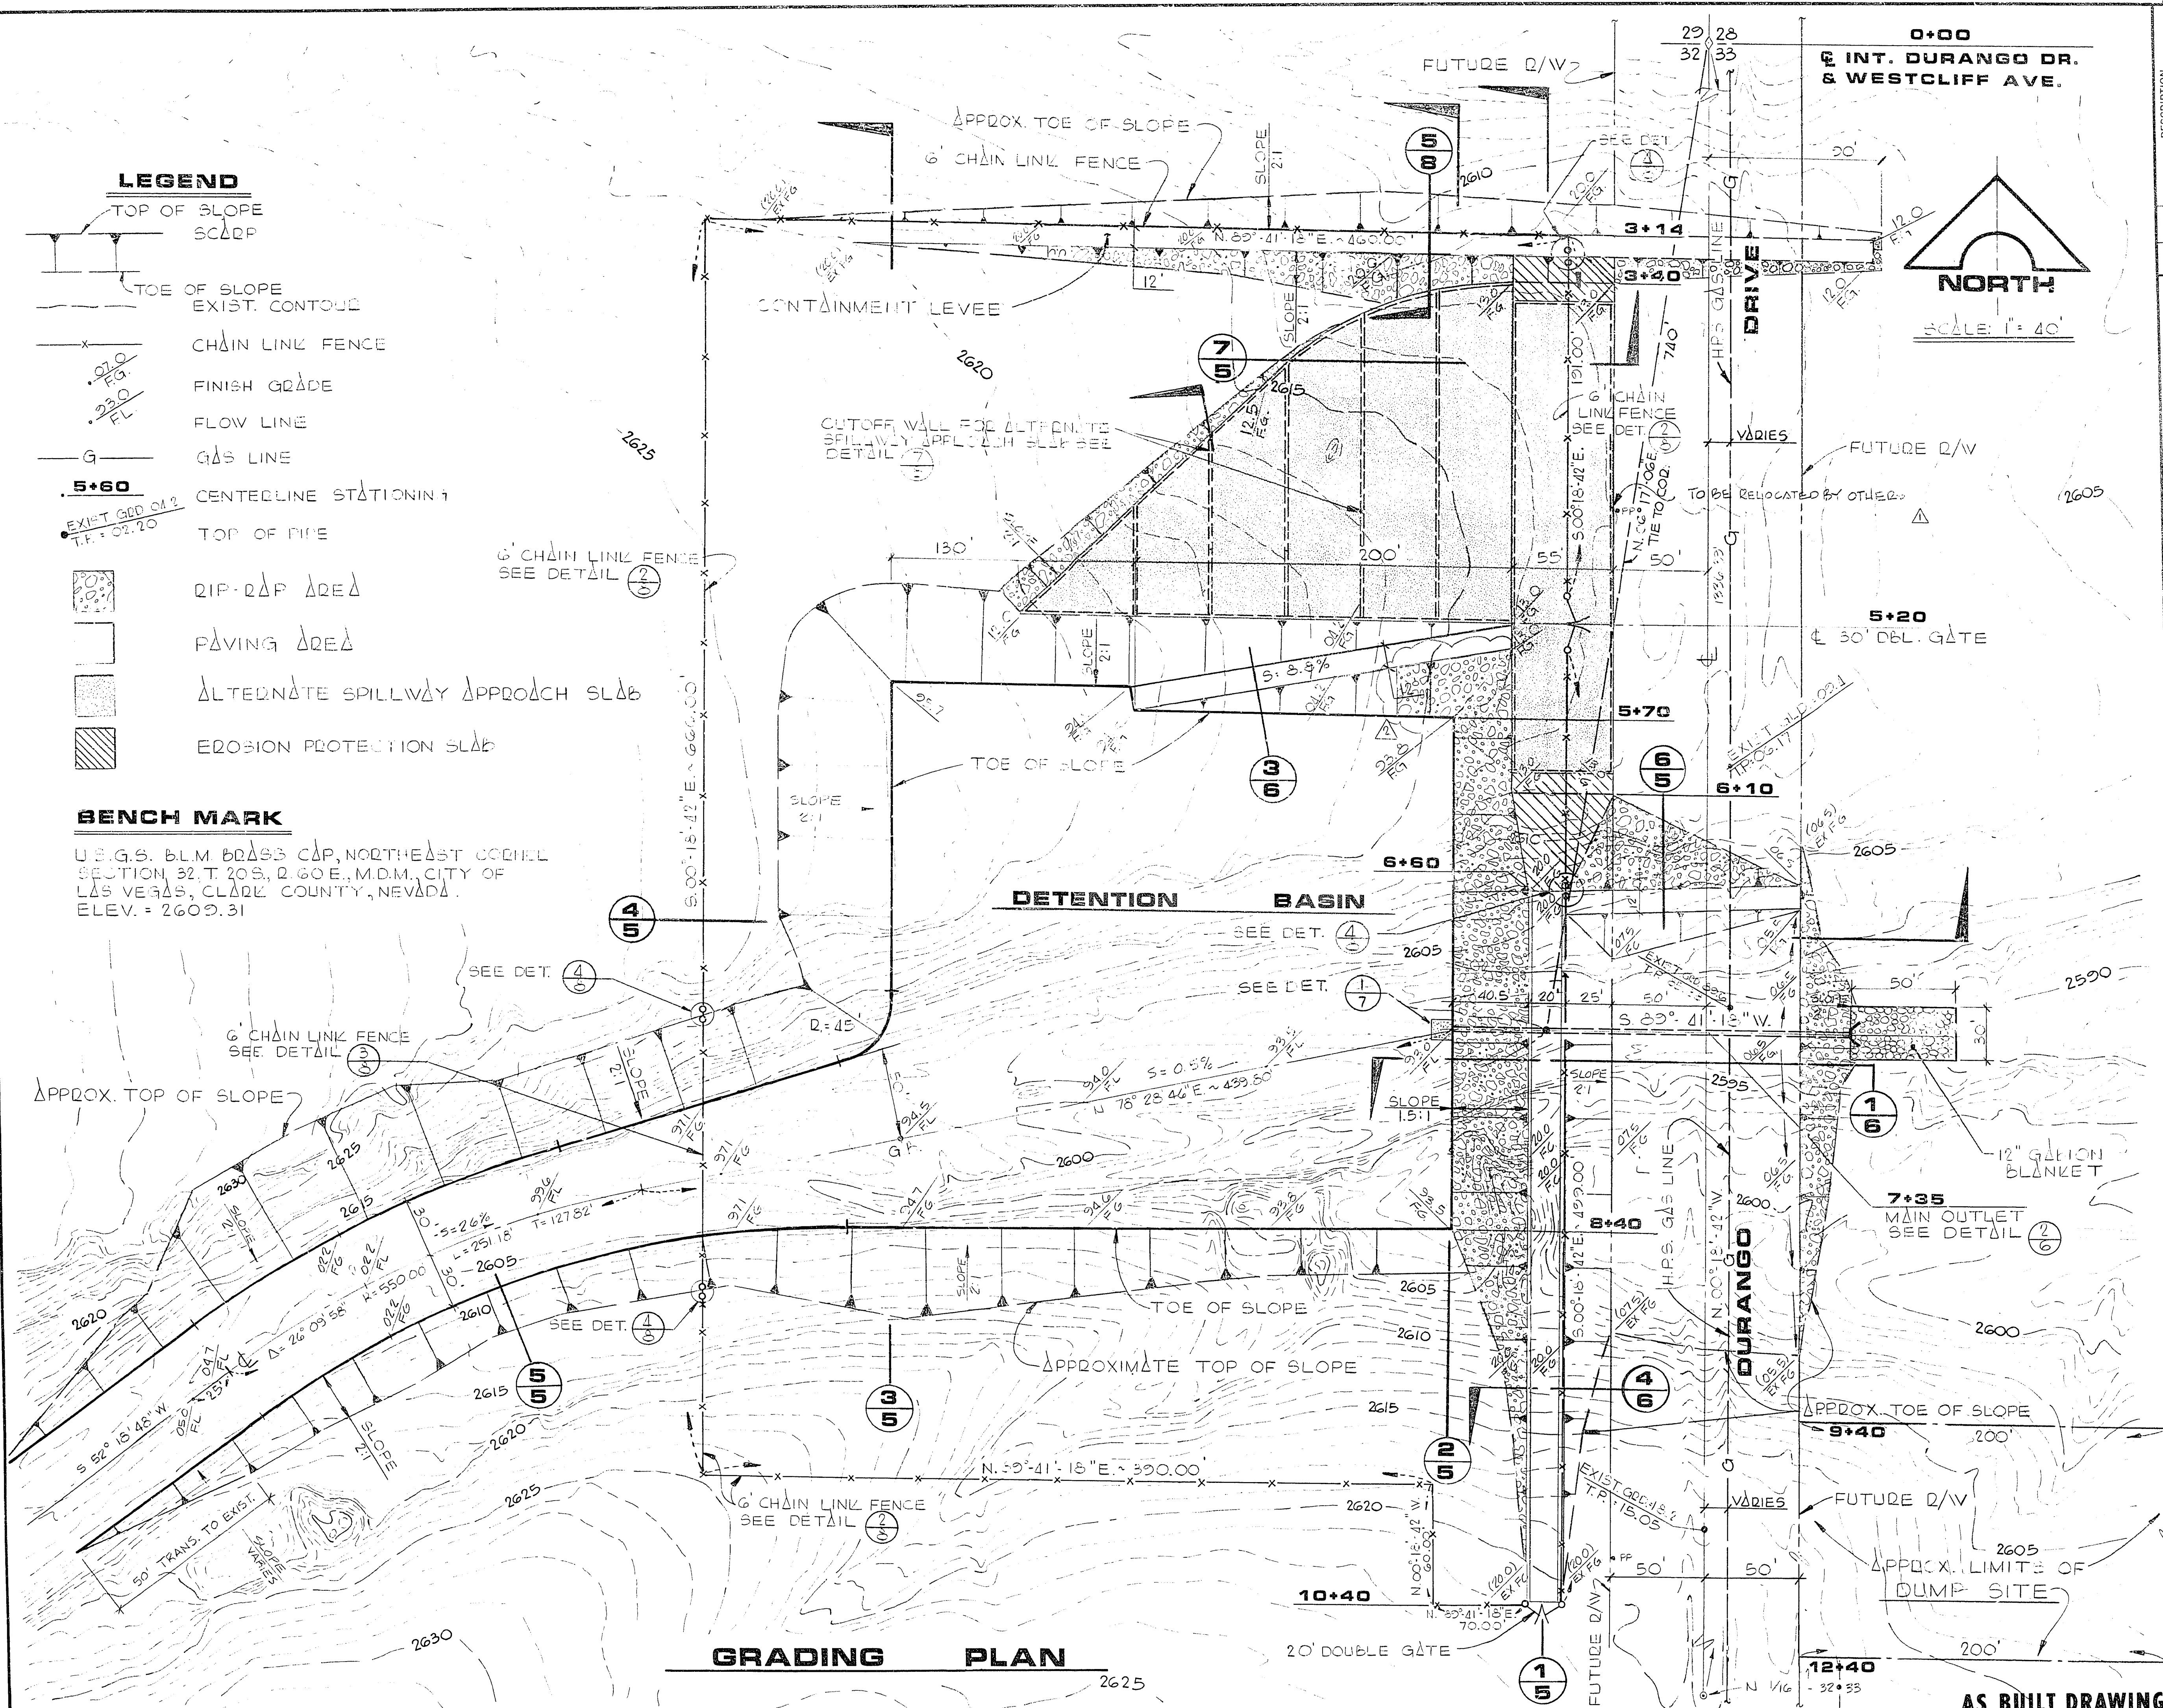

DESCRIPTION	DATE	REV.	ADDENDUM #	DATE	REV.
