
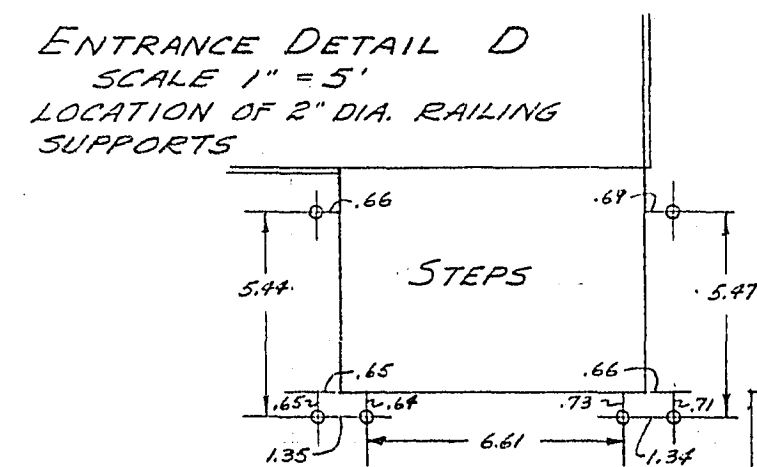
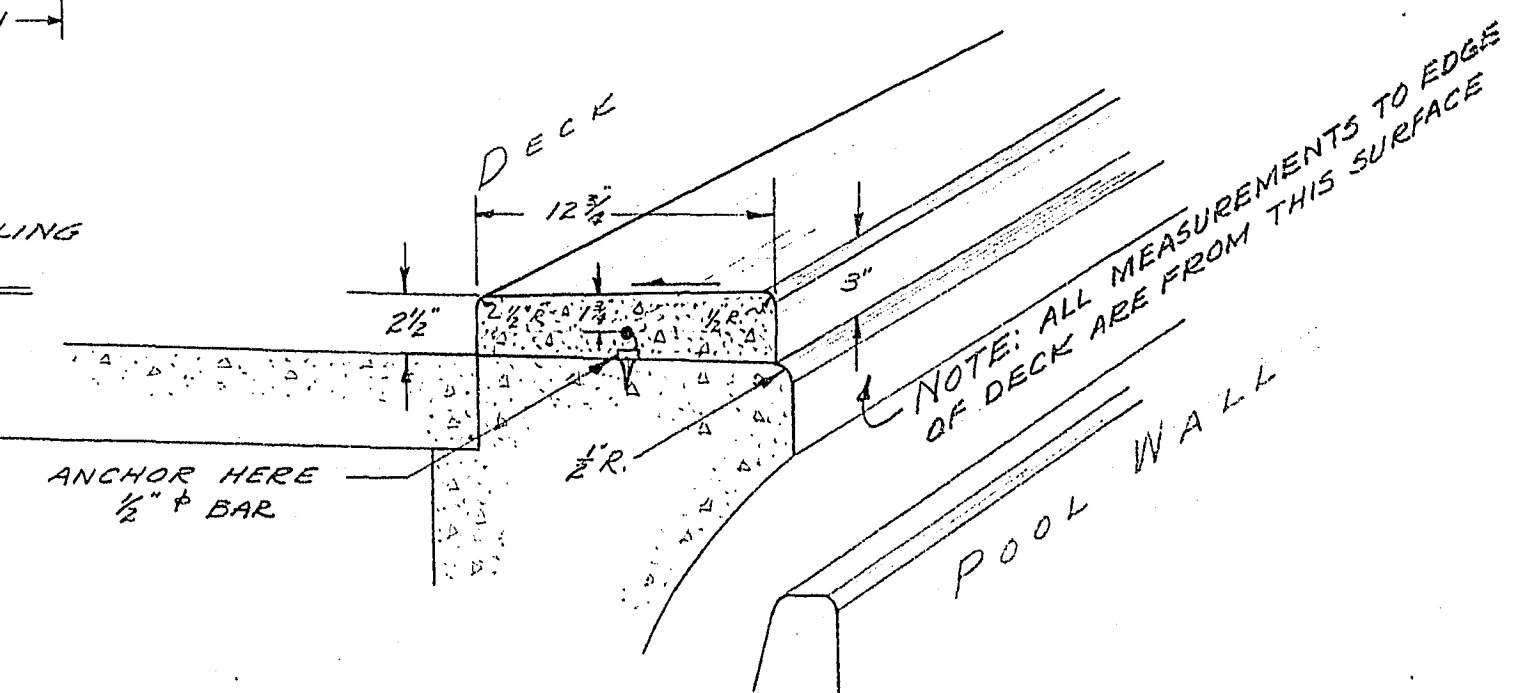
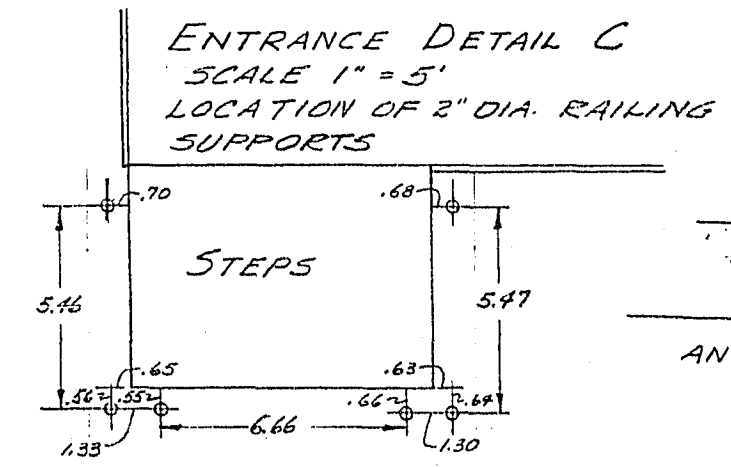


24-13-b1

NOTE:
 1. MITRE ALL CORNERS OR PROVIDE CORNER TILE.
 2. RAILING SUPPORTS IN DETAIL VIEWS ARE PERMANENTLY INSTALLED, COPING MUST BE PRE-CUT TO FIT.
 3. RECEPTACLES ARE 6" DIA.

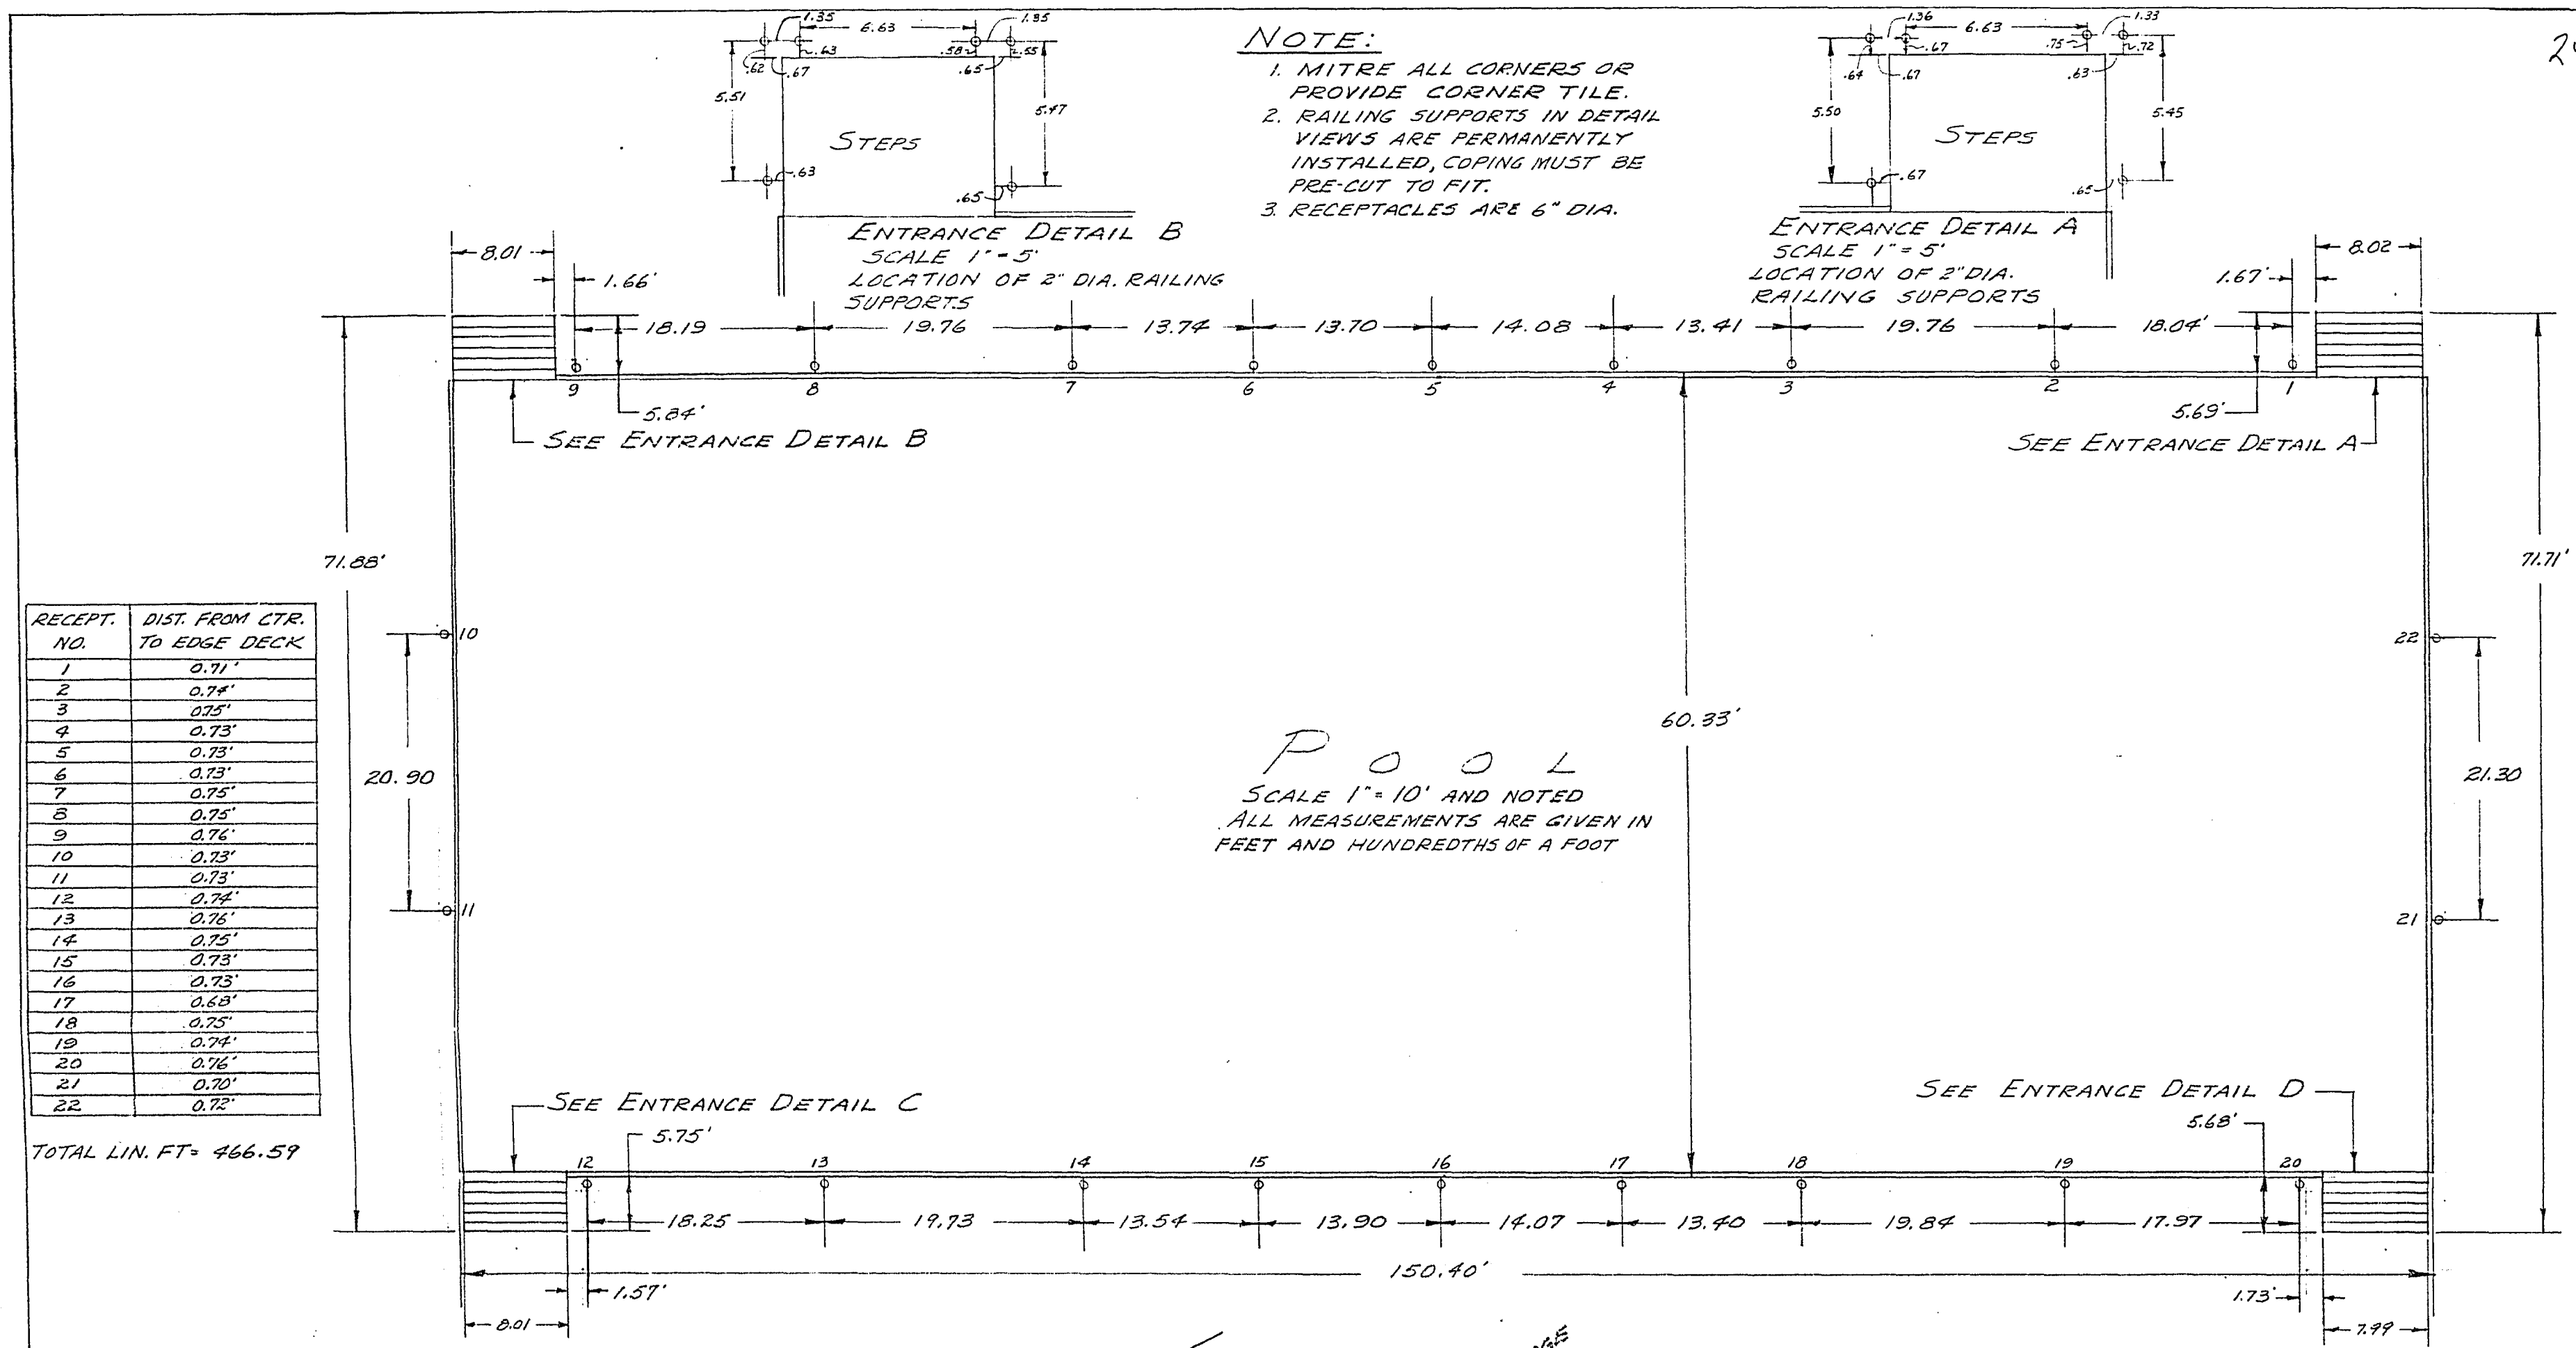

LAS VEGAS, NEVADA.

CENTRAL SWIMMING POOL
 OFFICE OF CITY ENGINEER
 MARCH 1948.

674-V4