
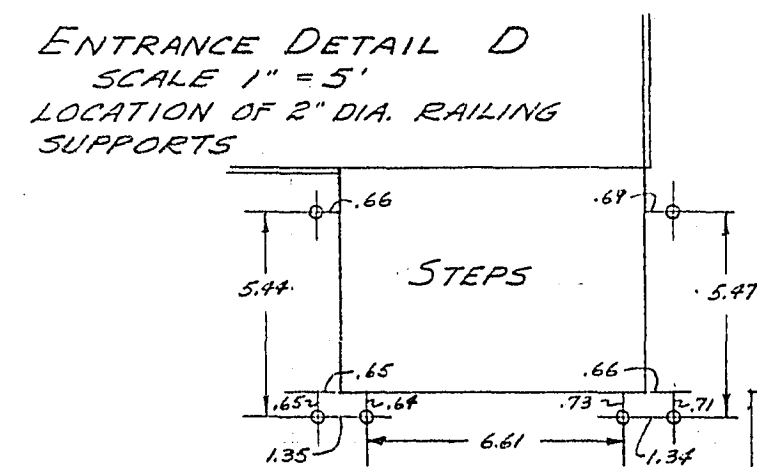
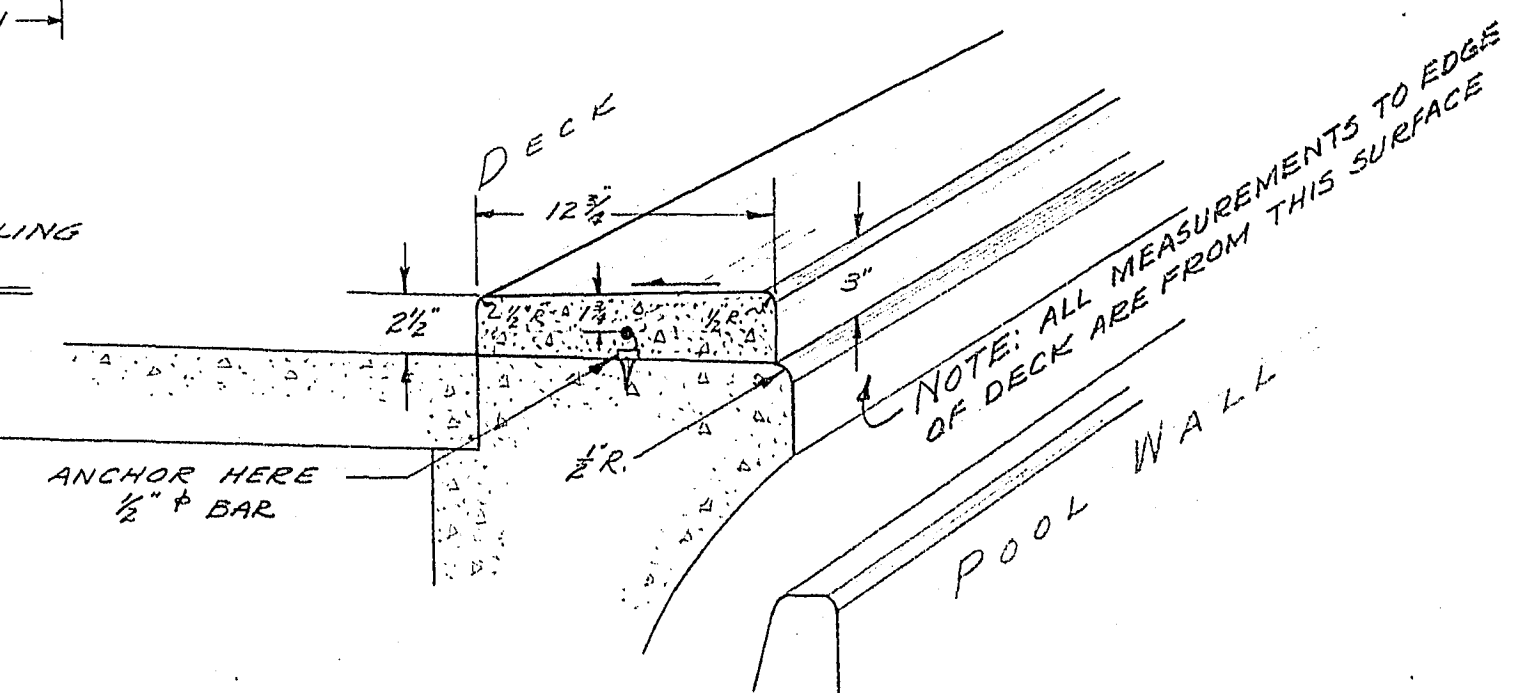
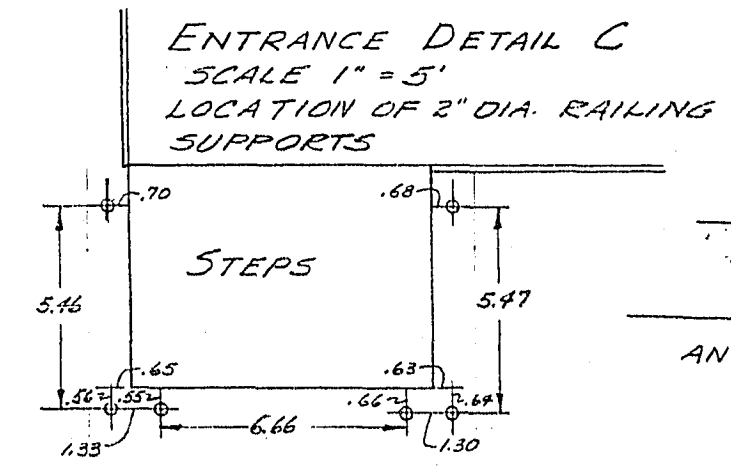


24-13-b1

NOTE:
 1. MITRE ALL CORNERS OR PROVIDE CORNER TILE.
 2. RAILING SUPPORTS IN DETAIL VIEWS ARE PERMANENTLY INSTALLED, COPING MUST BE PRE-CUT TO FIT.
 3. RECEPTACLES ARE 6" DIA.

RECEPT. NO.	DIST. FROM CTR. TO EDGE DECK
1	0.71'
2	0.74'
3	0.75'
4	0.73'
5	0.73'
6	0.73'
7	0.75'
8	0.75'
9	0.76'
10	0.73'
11	0.73'
12	0.74'
13	0.76'
14	0.75'
15	0.73'
16	0.73'
17	0.68'
18	0.75'
19	0.74'
20	0.76'
21	0.70'
22	0.72'

TOTAL LIN. FT= 466.59

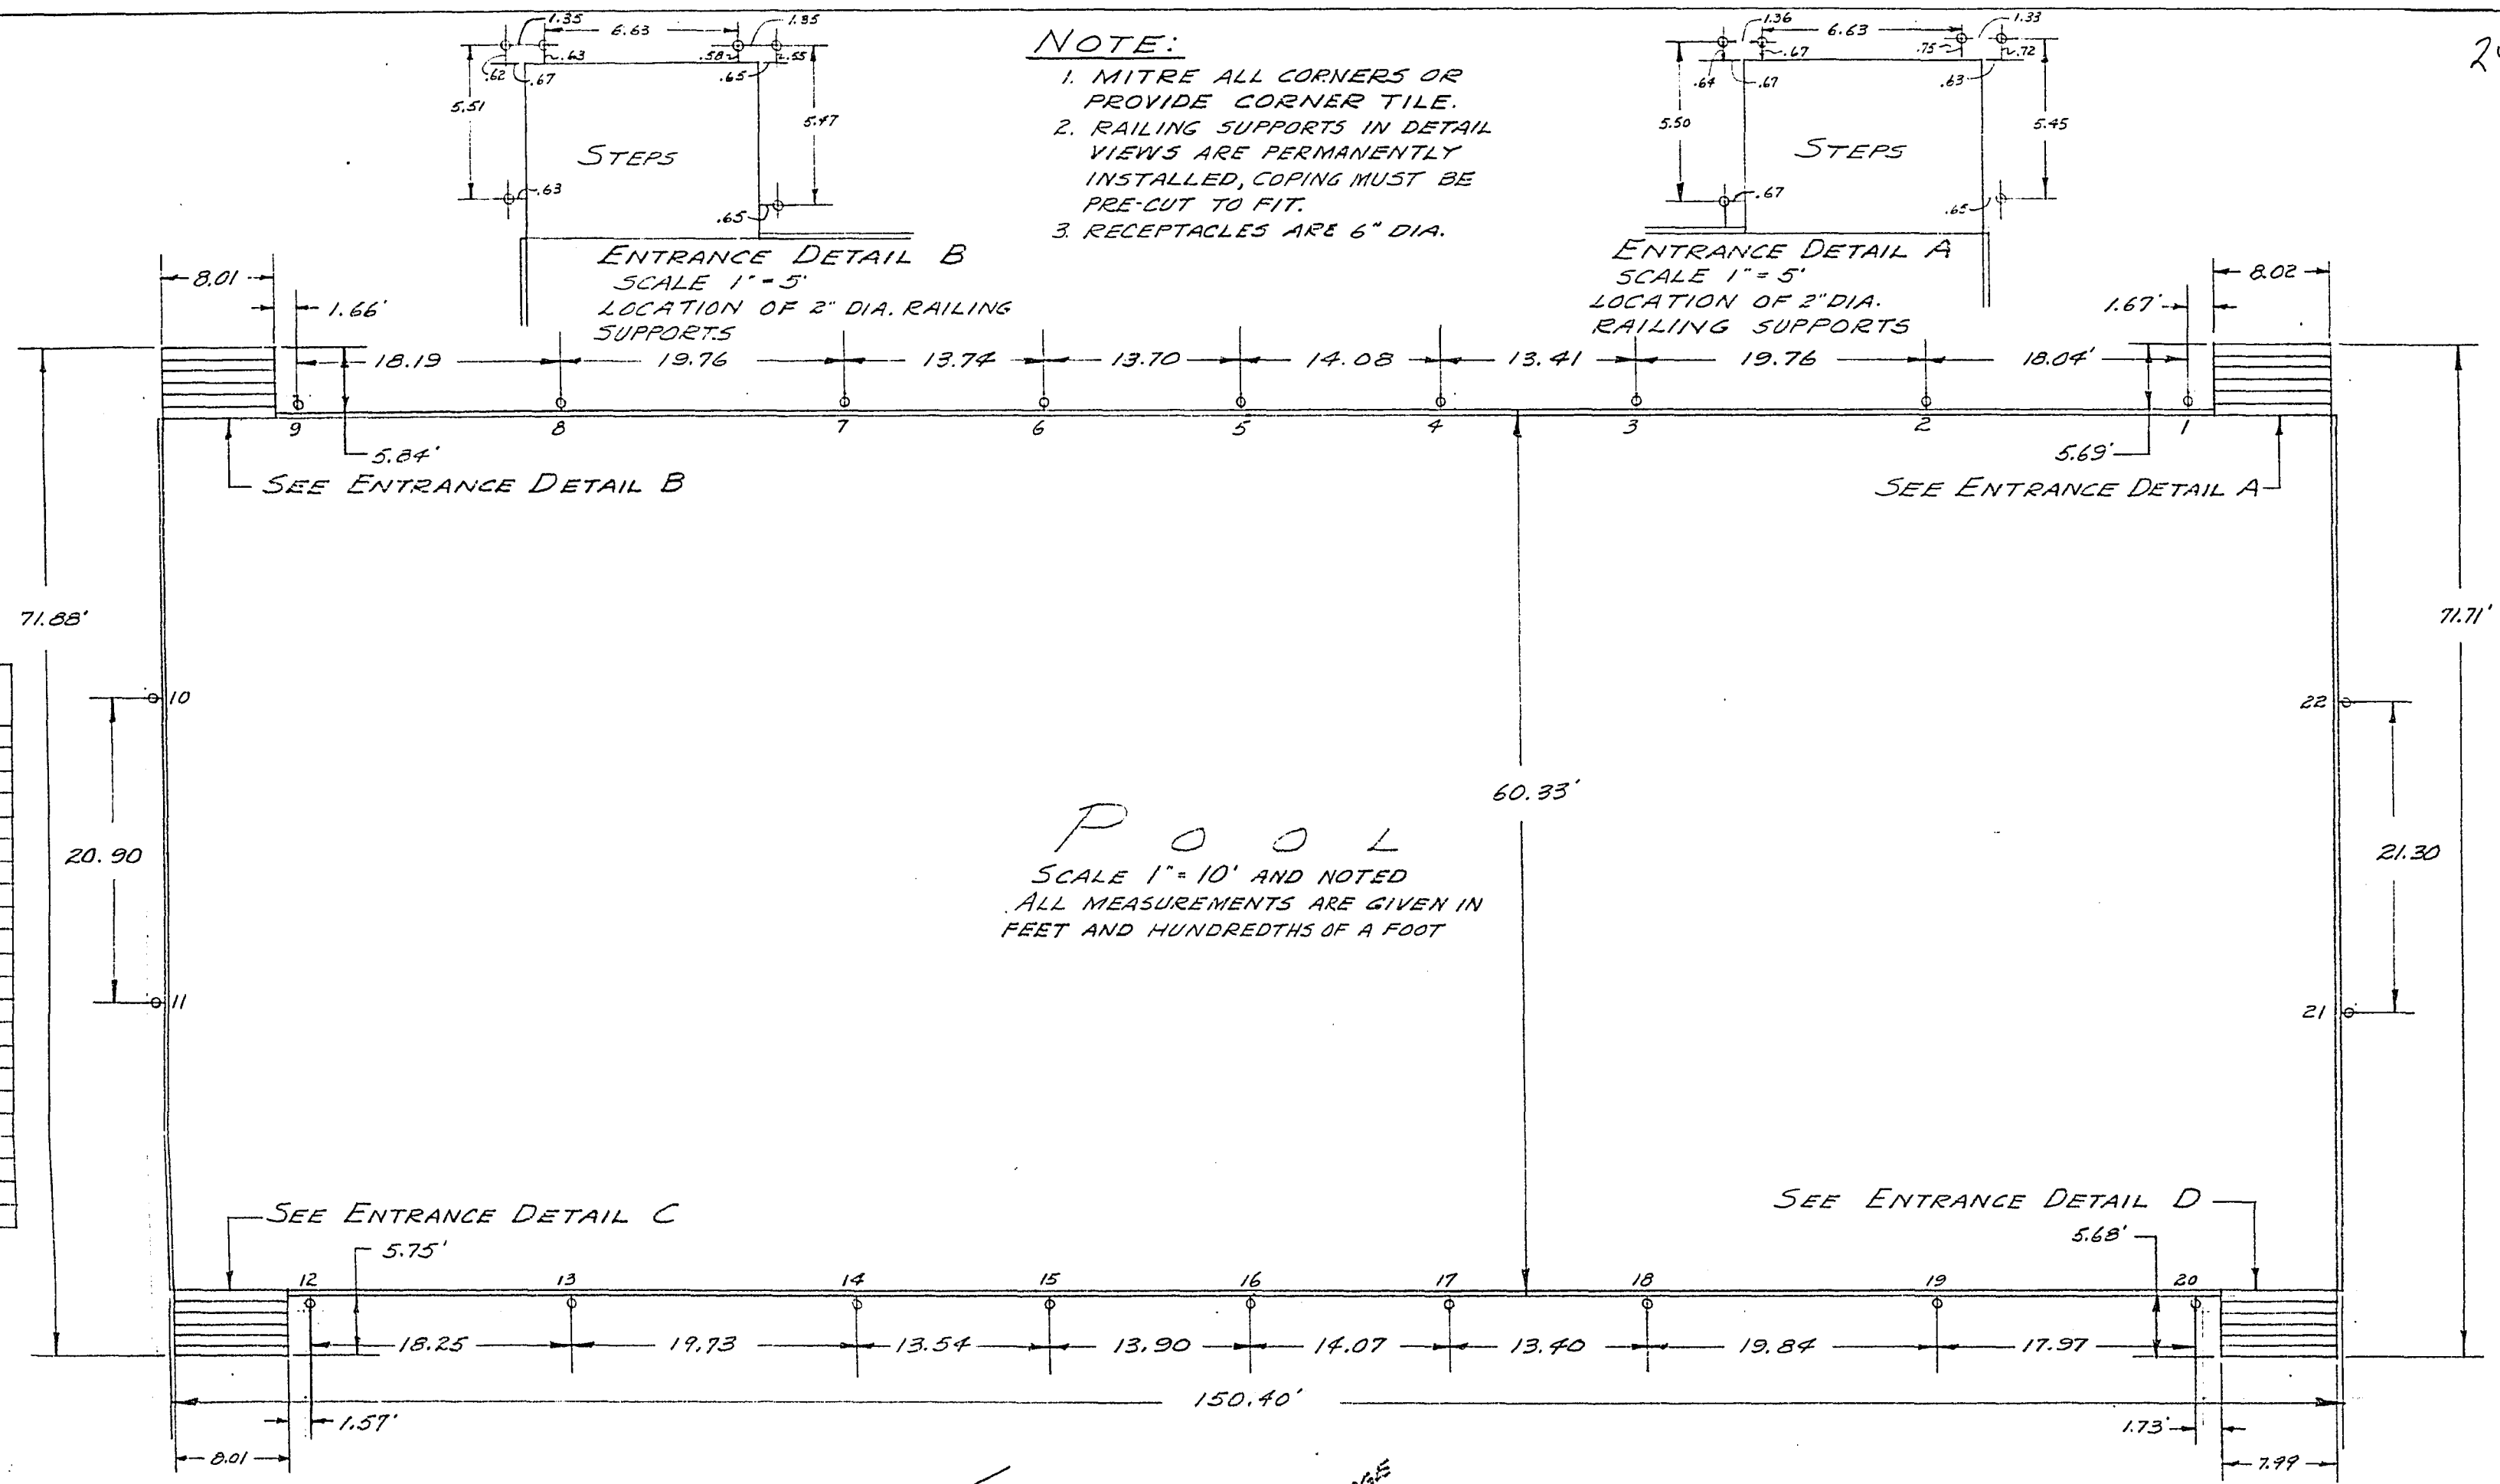

LAS VEGAS, NEVADA.

CENTRAL SWIMMING POOL
 OFFICE OF CITY ENGINEER
 MARCH 1948.

674-V4