


18-15-11

PLANT SCHEDULE				
SYMBOL	BOTANICAL NAME	COMMON NAME	QTY.	SIZE
TREES				
	CERCIUM FLORIDUM	BLUE PALM VERDE	6	24" BOX
	FRAXINUS VELUTINA BONTA'	BONTA' ASH	6	24" BOX
	PROSOPIS ALBA 'COLORADO'	THORNLESS MESQUITE	5	24" BOX
	QUERCUS VIRGINIANA	SOUTHERN LIVE OAK	36	24" BOX
SHRUBS				
	CASALPINA MEXICANA	MEXICAN BIRD OF PARADISE	23	5 GAL
	DALIA FRUTESCENS 'SIERRA NEGRA'	BLACK DALEA	40	5 GAL
	LEUCOPHYLLUM LAUGHMANAE 'RIO BRAVO'	RIO BRAVO SAGE	64	5 GAL
	VAQUILINA CALIFORNICA	ARIZONA ROSEWOOD	42	5 GAL
GROUND COVERS				
	DACQUARIS 'CENTENIAL'	CENTENIAL DACQUARIS	134	5 GAL
	CONVOLVULUS GEORGIN	BUSH HORNING GLORY	168	1 GAL
ACCENTS				
	HEPERALOE PARVIFOLIA	RED YUCCA	41	5 GAL
	YUCCA RECURVIFOLIA	KEEPPING YUCCA	21	5 GAL

1. CONTRACTOR IS RESPONSIBLE TO VERIFY ALL PLANT QUANTITIES. THE PLANT LIST IS INTENDED AS A REFERENCE ONLY.
2. LANDSCAPE ARCHITECT IS TO APPROVE ALL PLANT MATERIAL PRIOR TO INSTALLATION WITH PRIOR NOTICE OF 48 HOURS.
3. PLANT MATERIAL IS TO HAVE IDENTIFICATION TAGS ON 10 % OF TOTAL QUANTITY OF EACH SPECIES, SHOWING GENUS, SPECIES AND VARIETY ETC.
4. PROVIDE MATCHING SIZES AND FORMS OF LIKE SHRUB SPECIES AS SHOWN ON DRAWINGS.
5. DECOMPOSED GRANITE 1/2" MINUS, COLOR "PALOMINO CORAL", 2" DEPTH TYPICAL IN ALL PLANTING BEDS.
WHOLESALE DEALER:
KALAMAZOO MATERIALS, INC.
50 NORTH ALVERNON WAY
TUCSON, ARIZONA 85711
ATTN: PAUL D'ALESSIO
TELEPHONE: (602) 745-1345
6. LANDSCAPE BOULDERS: ROUND IN SHAPE 2' TO 4' IN DIAMETER SIZED ACCORDINGS TO THE FOLLOWING PERCENTAGES:
20% 4' LARGEST DIAMETER
40% 3' LARGEST DIAMETER
40% 2' LARGEST DIAMETER
ALL ROCK AND PLACEMENT TO BE APPROVED BY LANDSCAPE ARCHITECT PRIOR TO INSTALLATION.

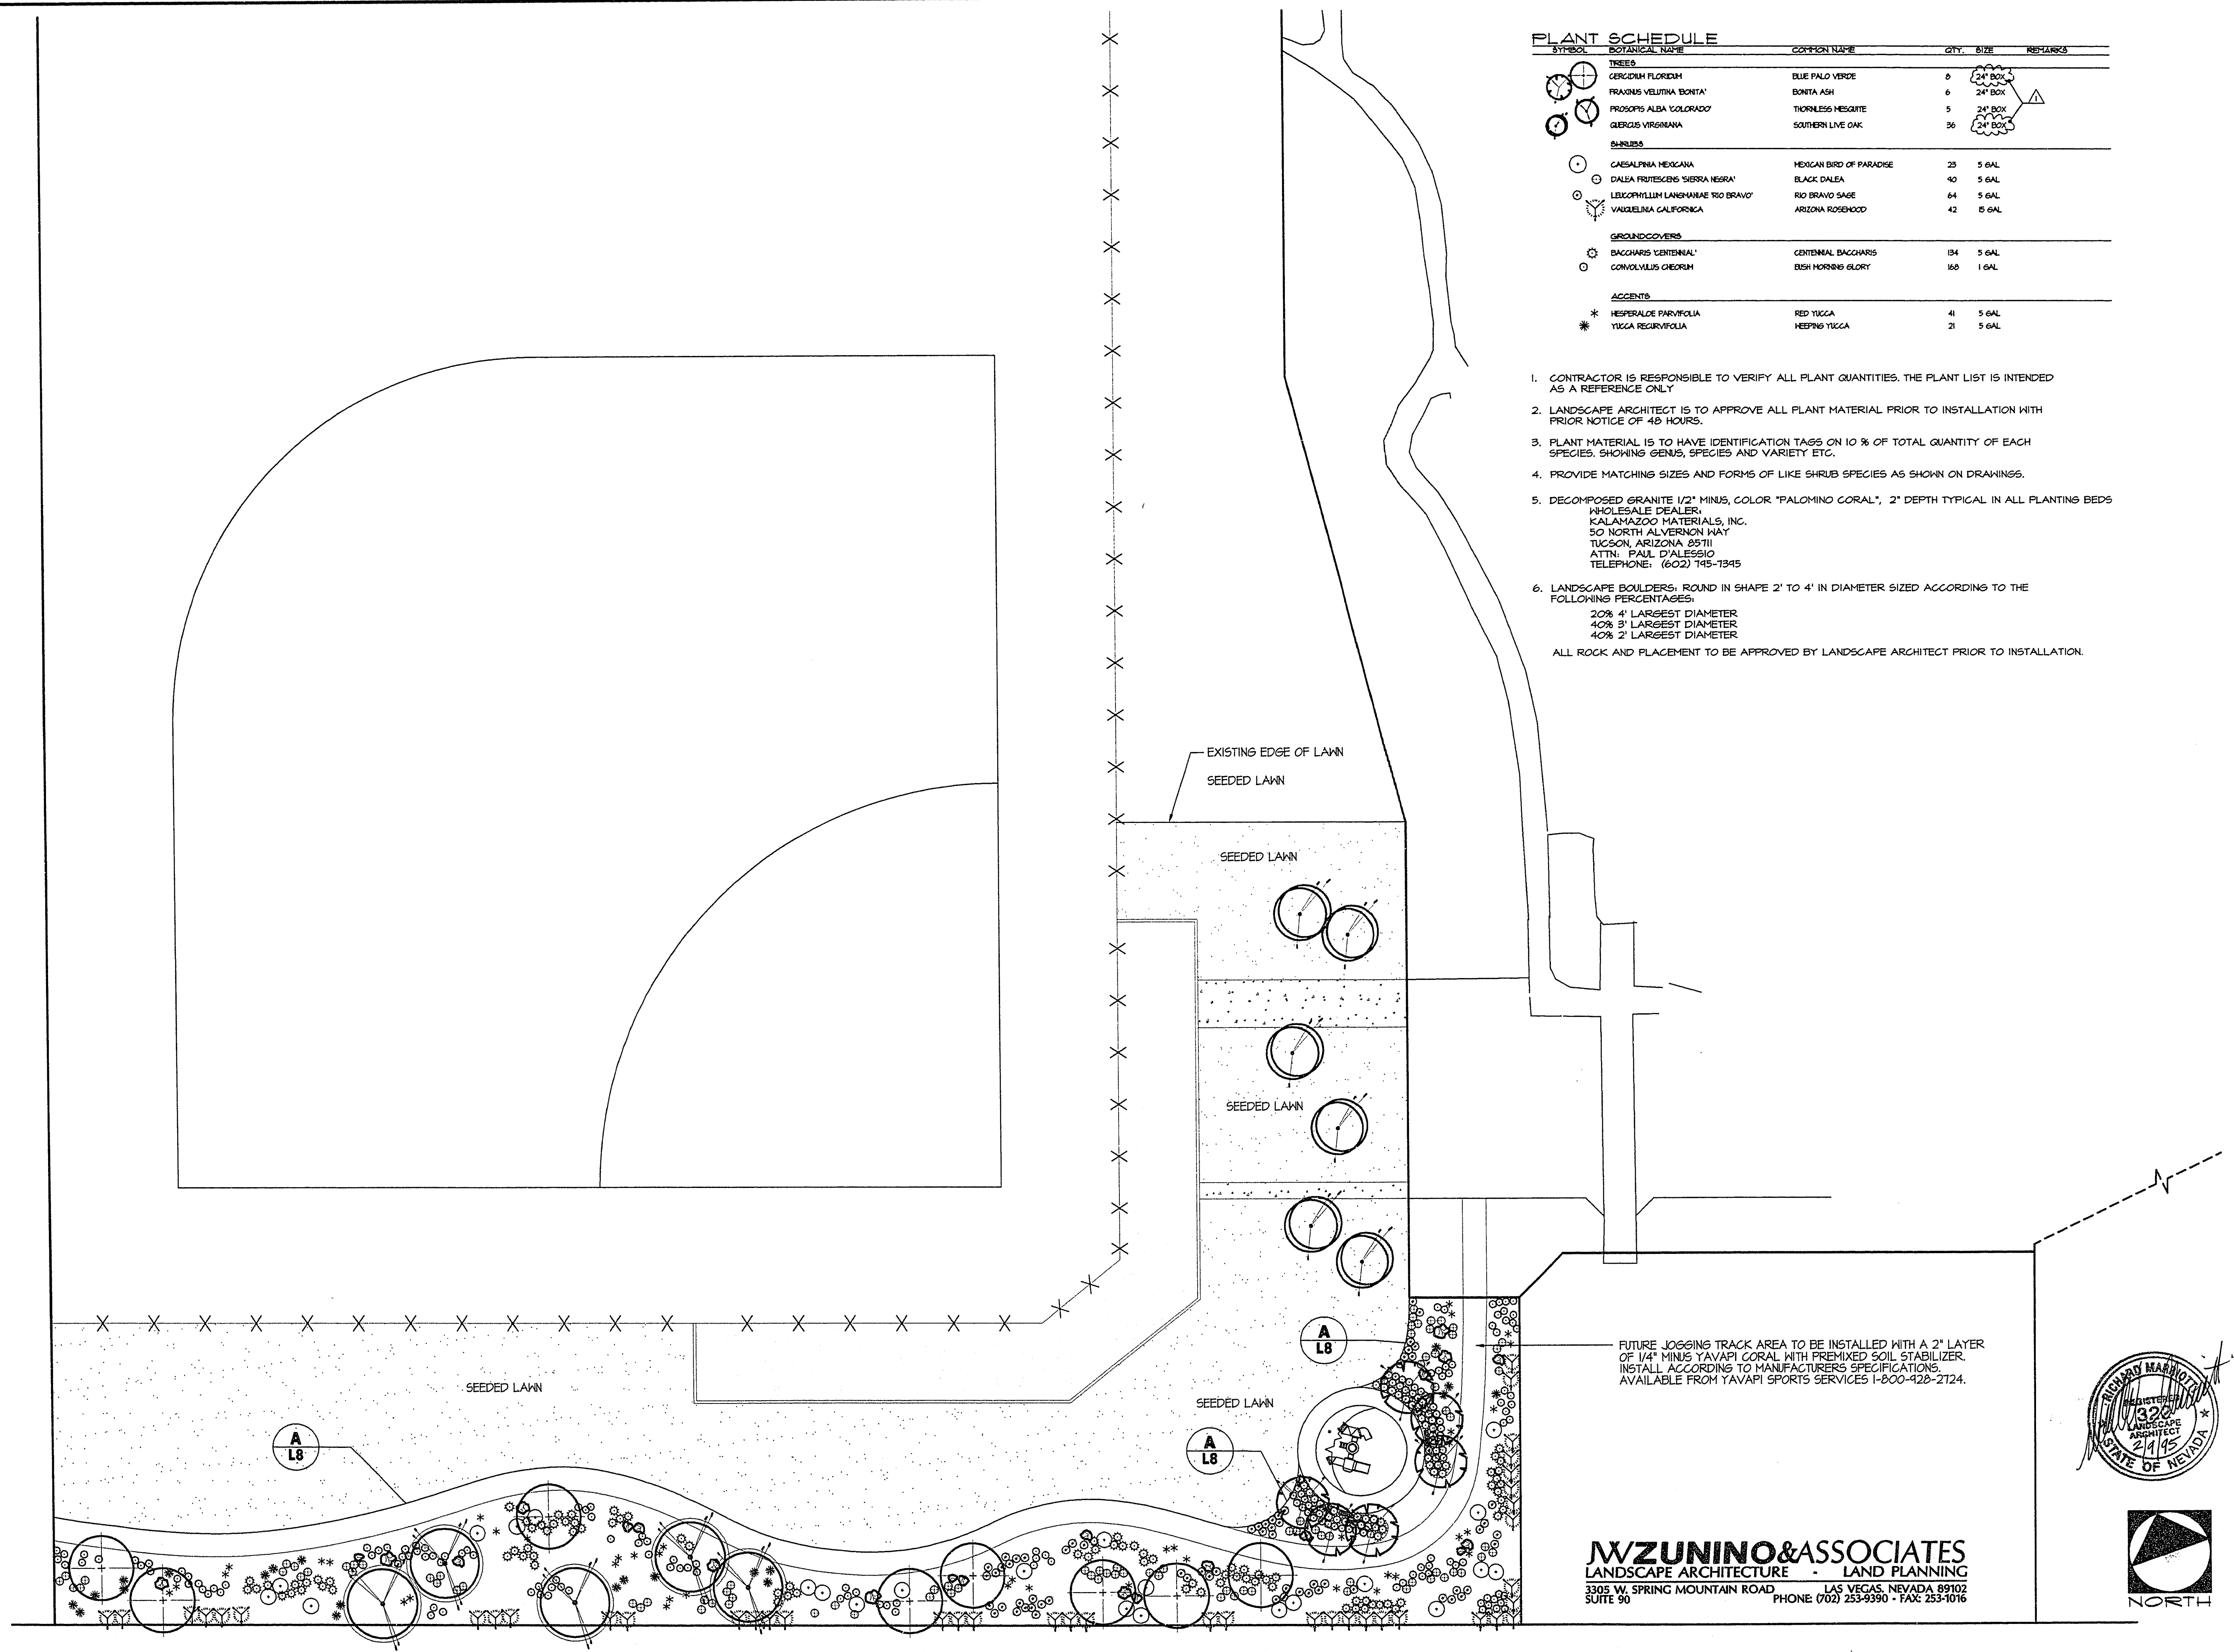

PROJECT NO: 94912

DATE: 12-16-94

SCALE: HORIZ: 1"=30'-0"

VERT: 1"=10'-0"

DWG FILE:

PROJECT

90° FIELD LANDSCAPE PLANTING PLAN

CHILDREN'S MEMORIAL - PHASE 3

SHEET 11 of 15

L4

OF 8 SHEETS

RECEIVED
3322
LANDSCAPE ARCHITECT
2/1/95
STATE OF NEVADA

NORTH

THE HICK GROUP, INC.
ENGINEERS & ARCHITECTS
2975 SOUTH RAINBOW BOULEVARD
LAS VEGAS, NEVADA 89102
PHONE (702) 344-1000

DRAWN BY: JAC
DESIGNED BY: BJ
APPROVED BY: BJ

IVZUNINO & ASSOCIATES
LANDSCAPE ARCHITECTURE - LAND PLANNING
3305 W. SPRING MOUNTAIN ROAD LAS VEGAS, NEVADA 89102
SUITE 30 PHONE (702) 253-9390 • FAX: 253-1016

Revised 650.35-4