
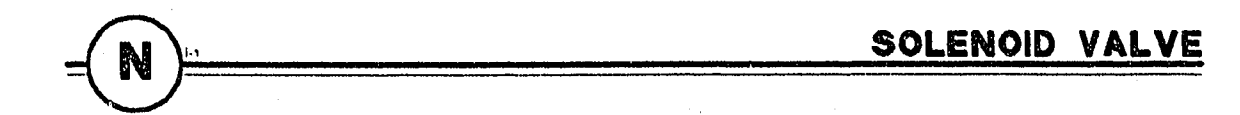
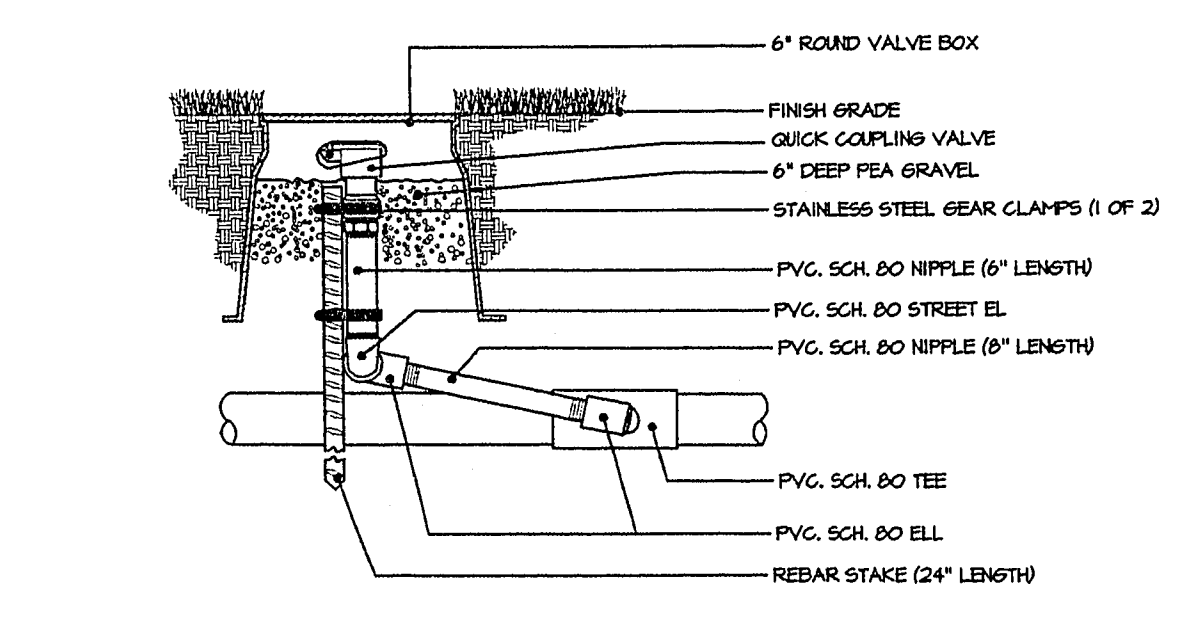
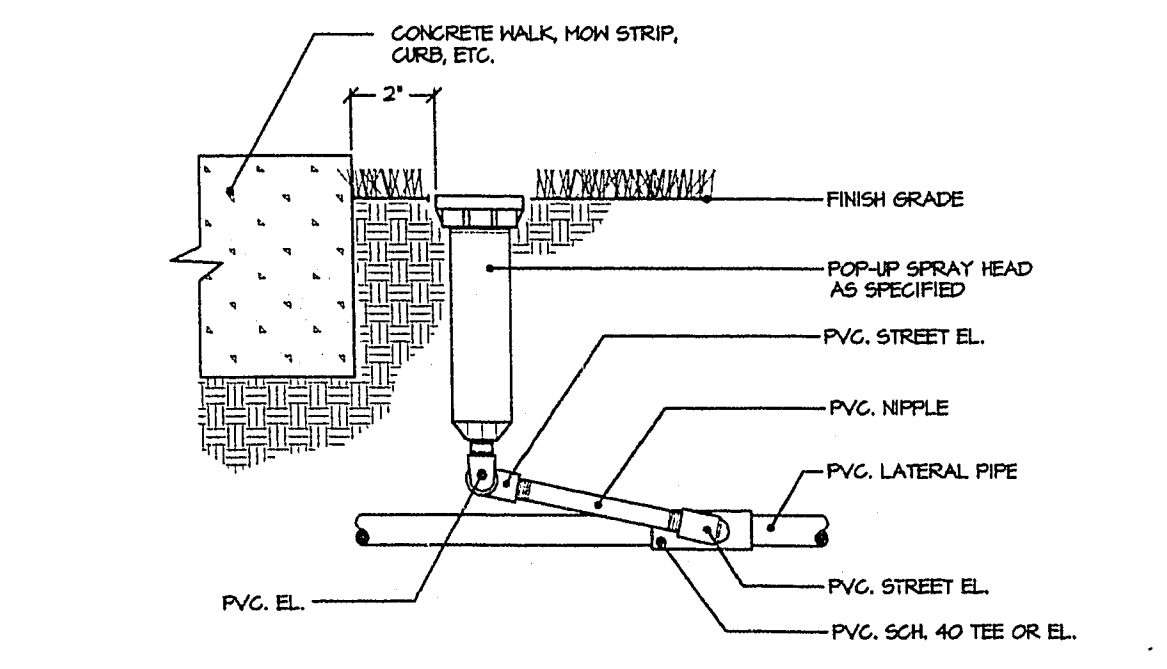
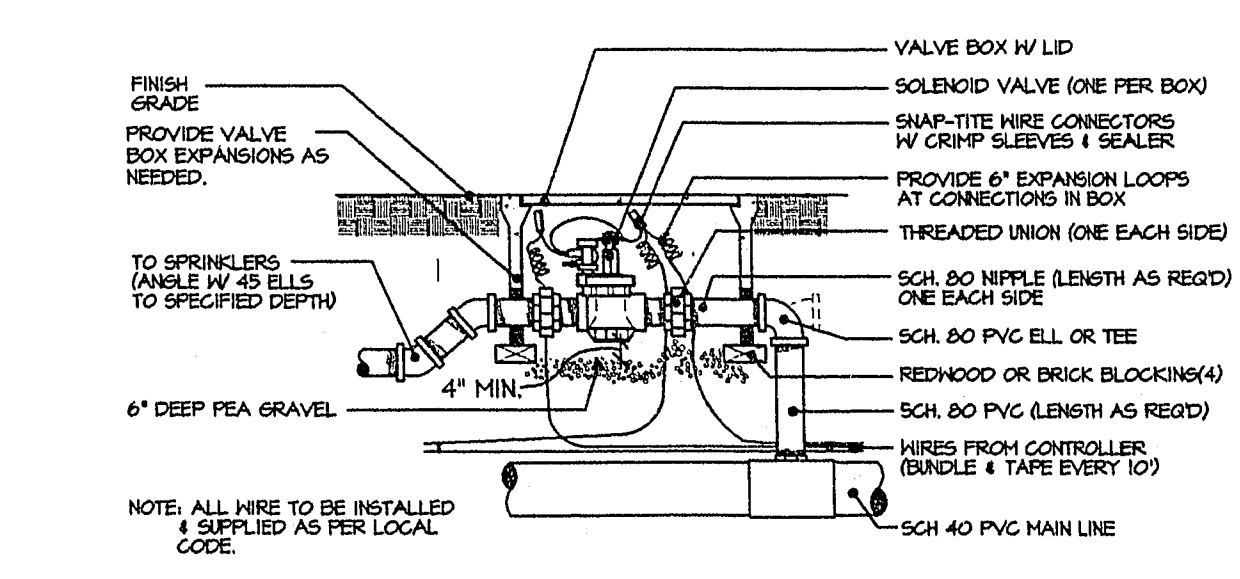
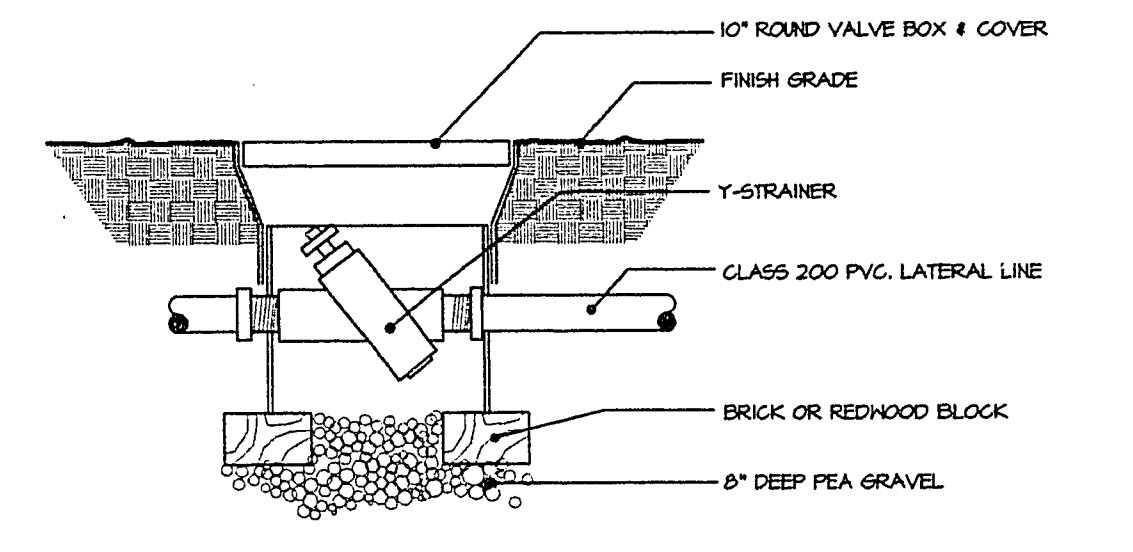
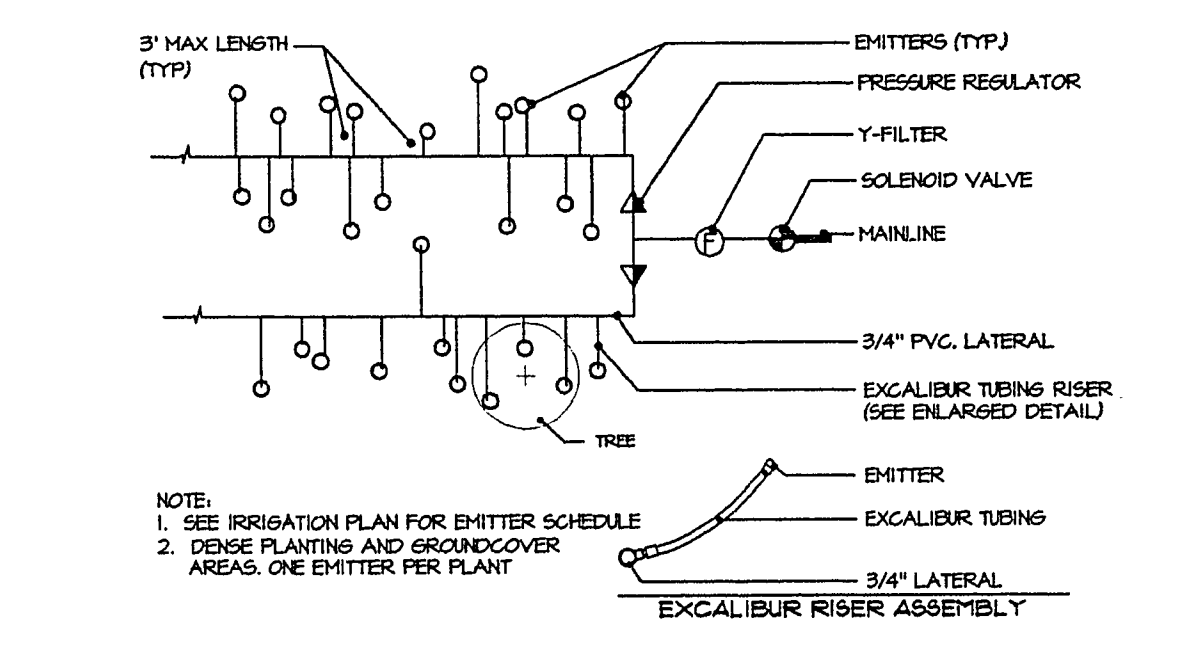
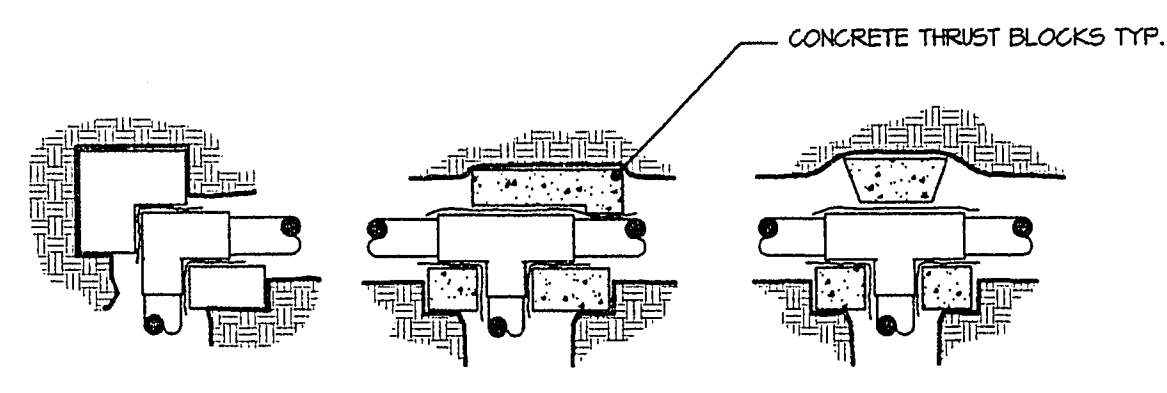
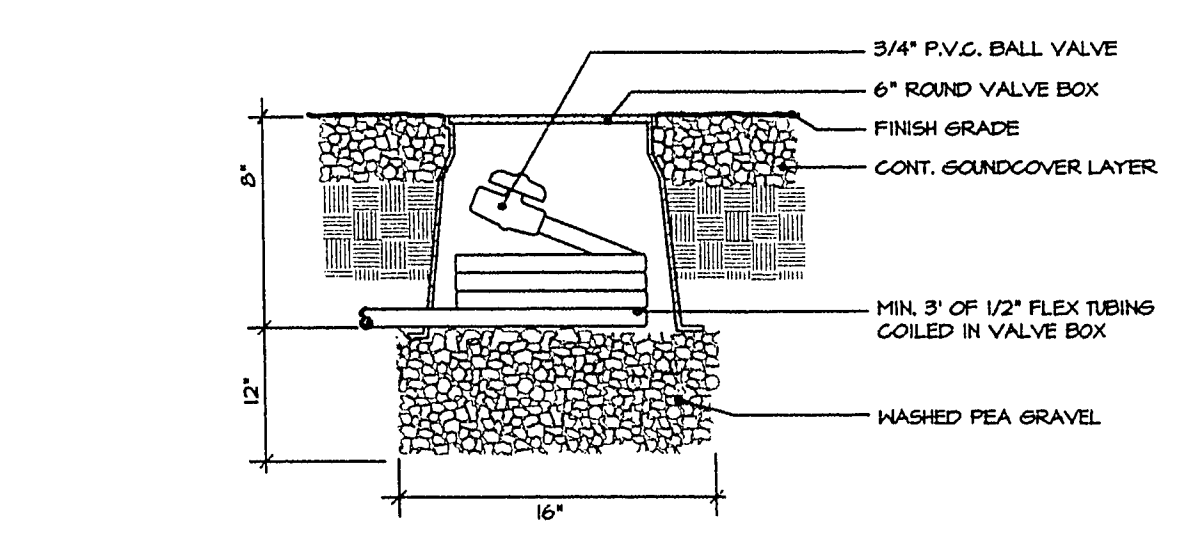
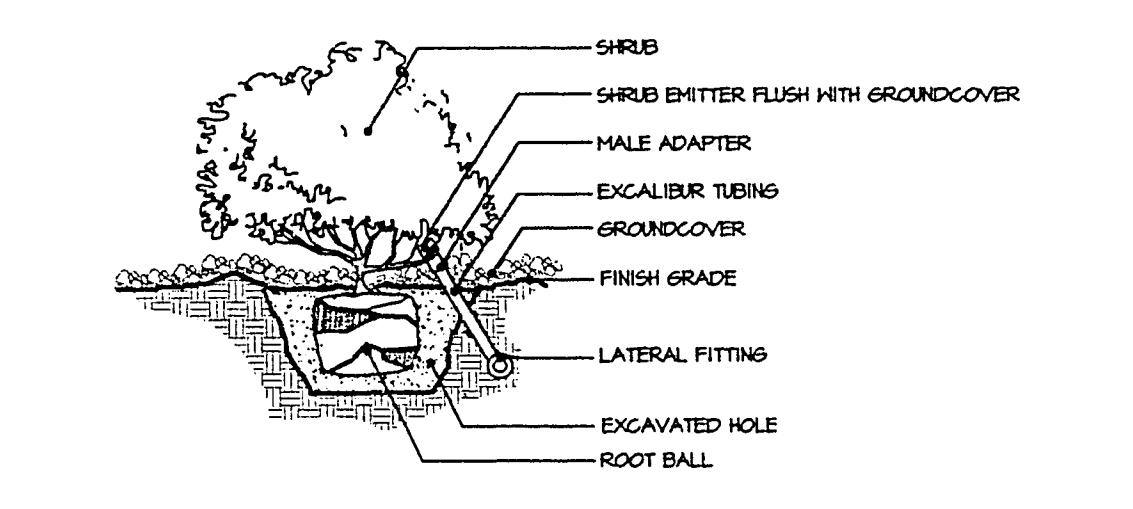
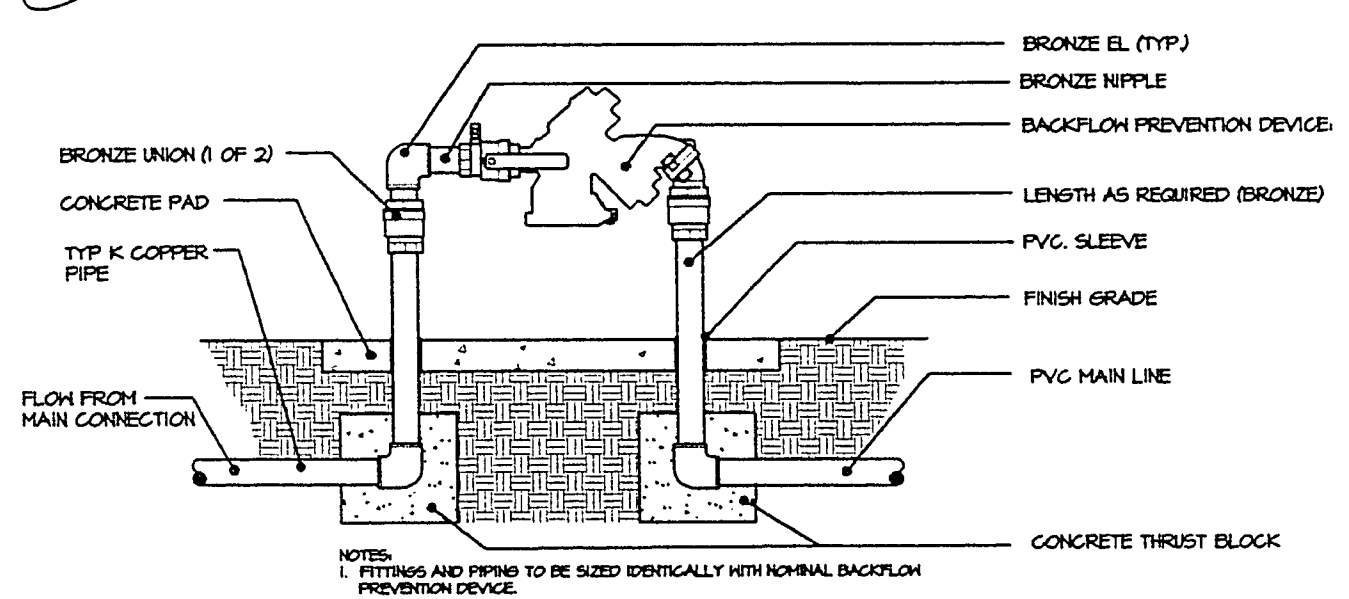
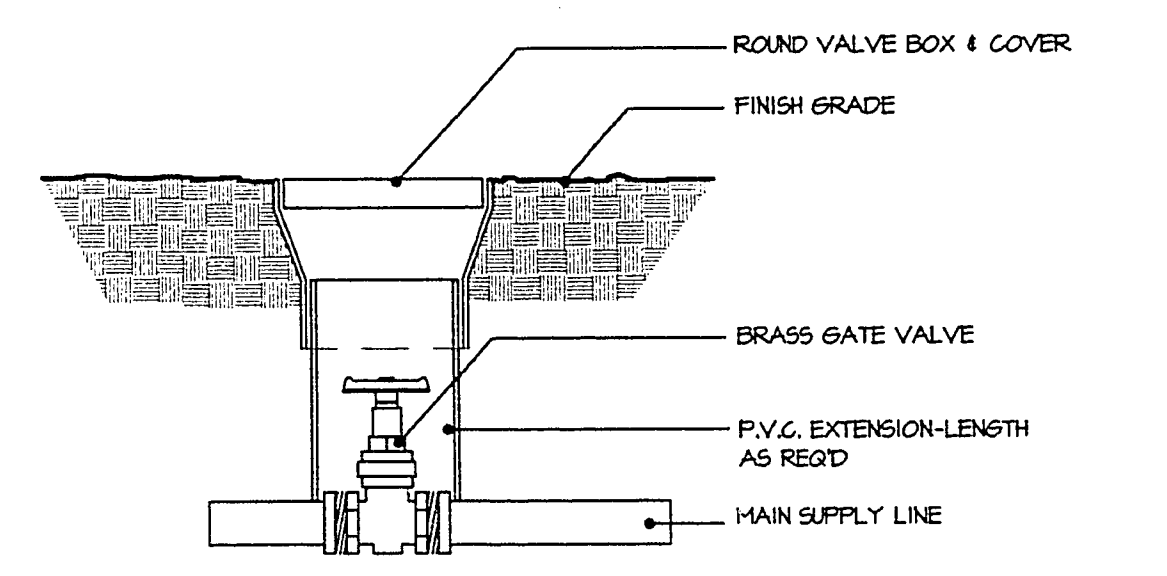
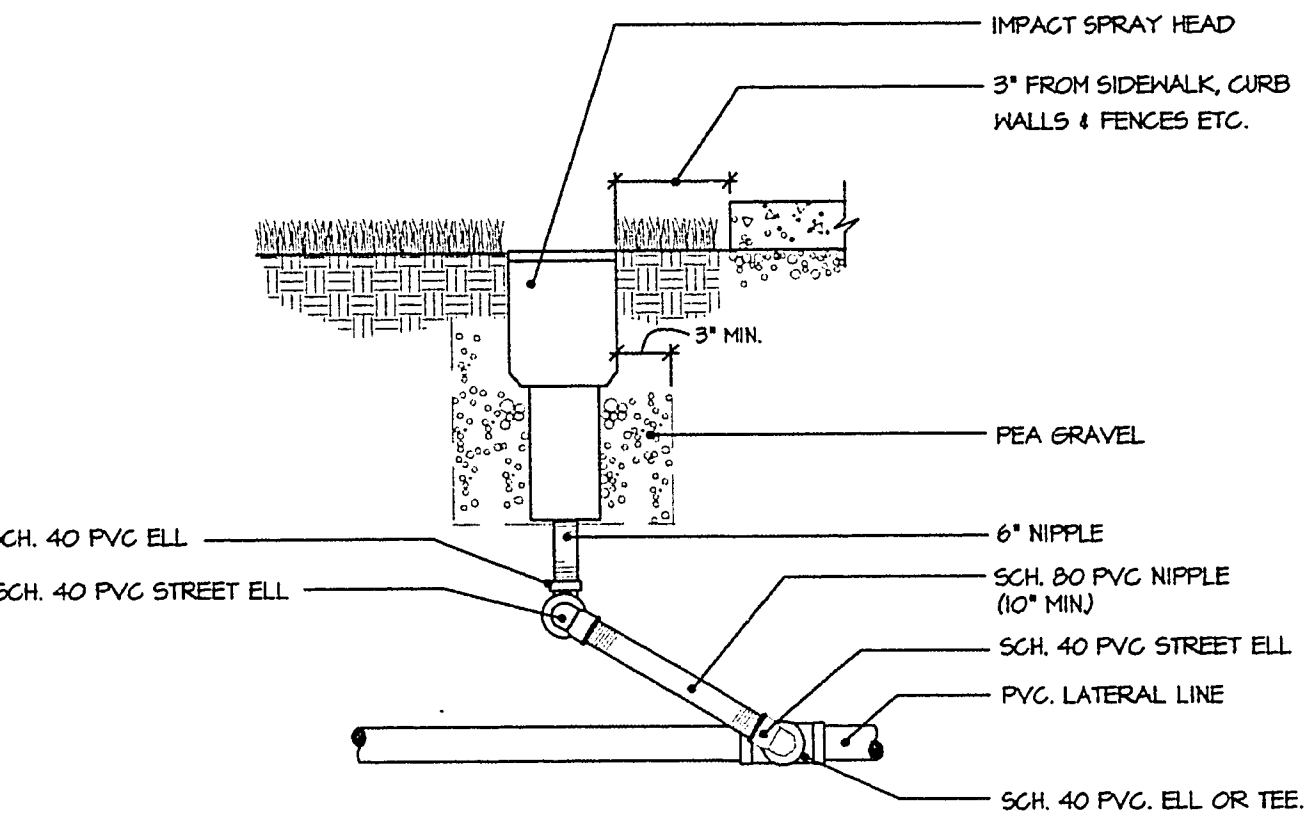
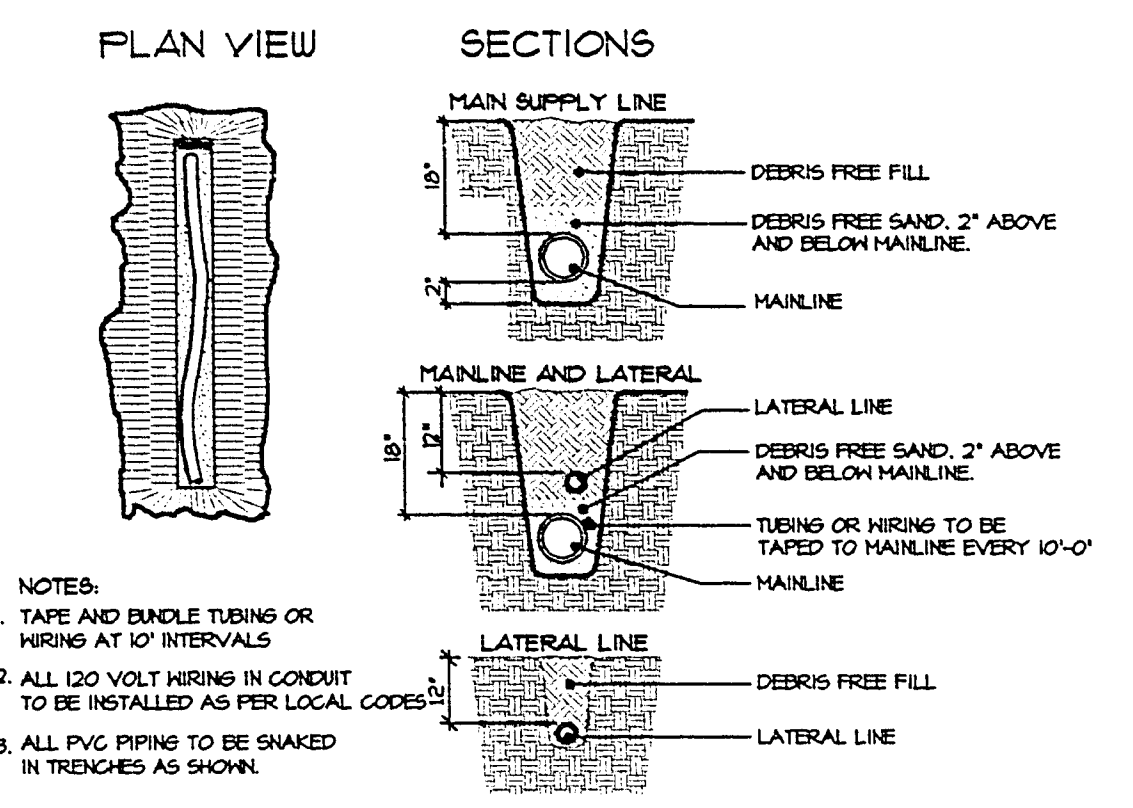
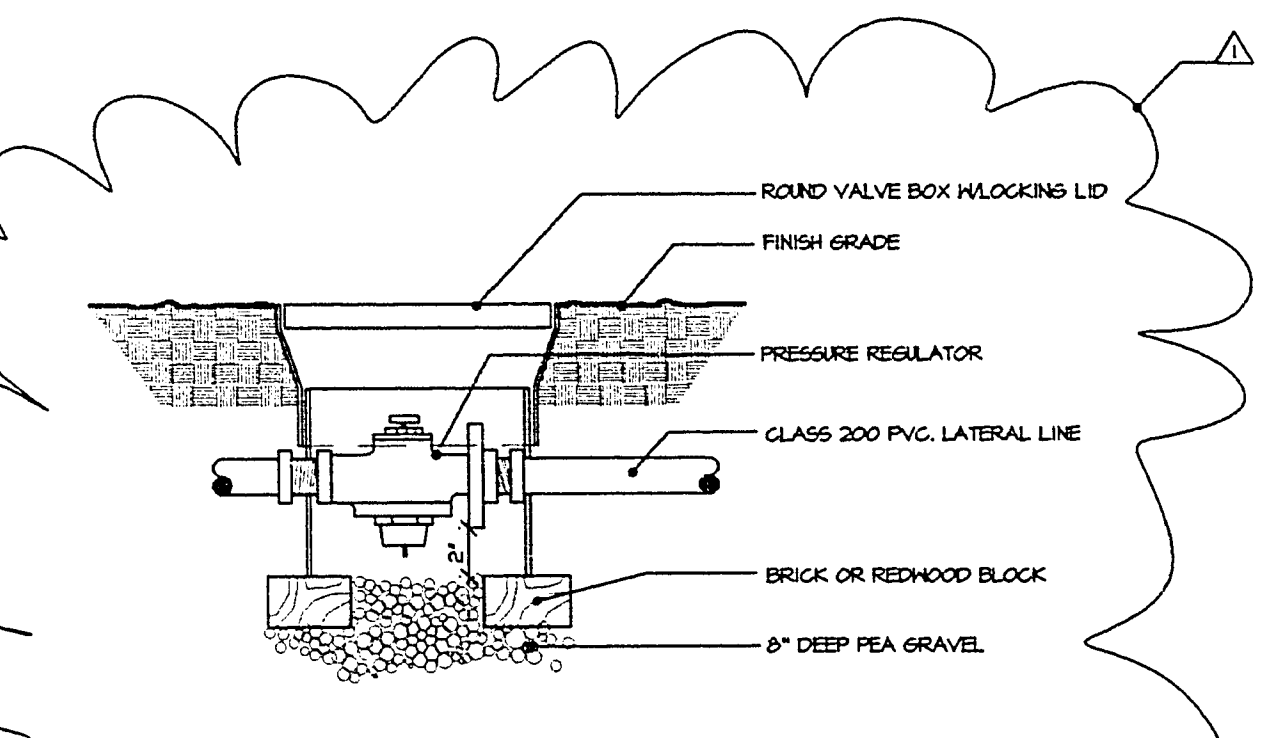
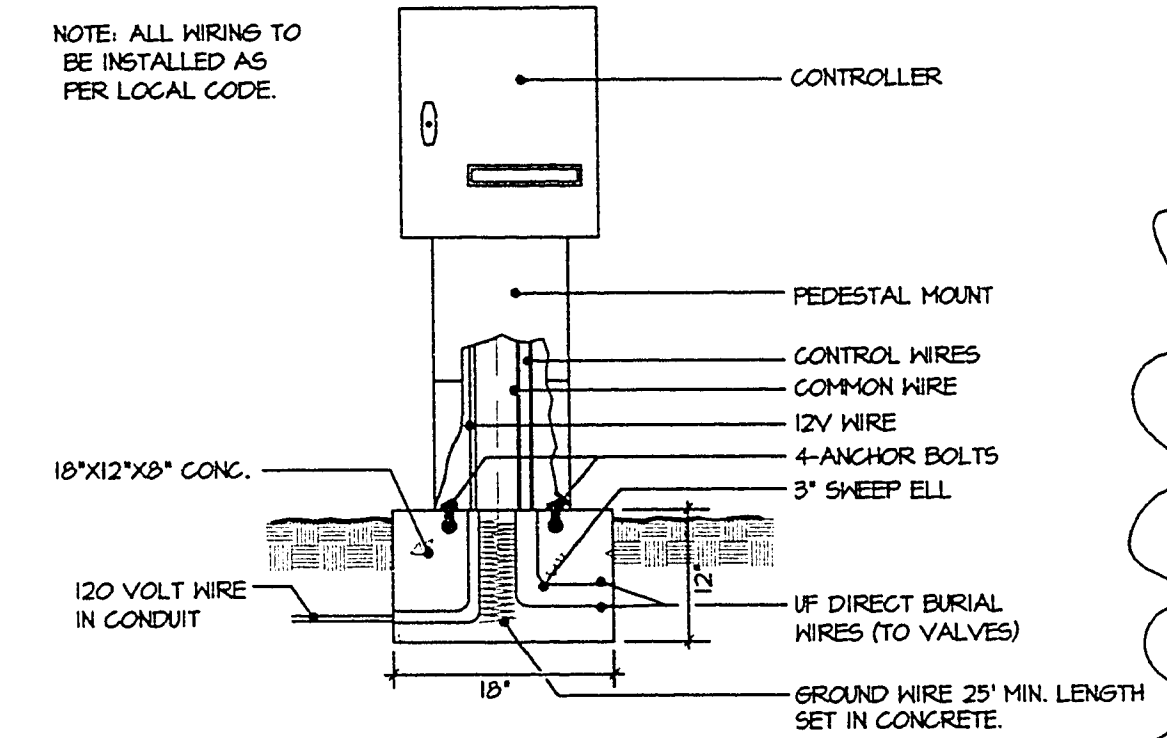


18-13-14

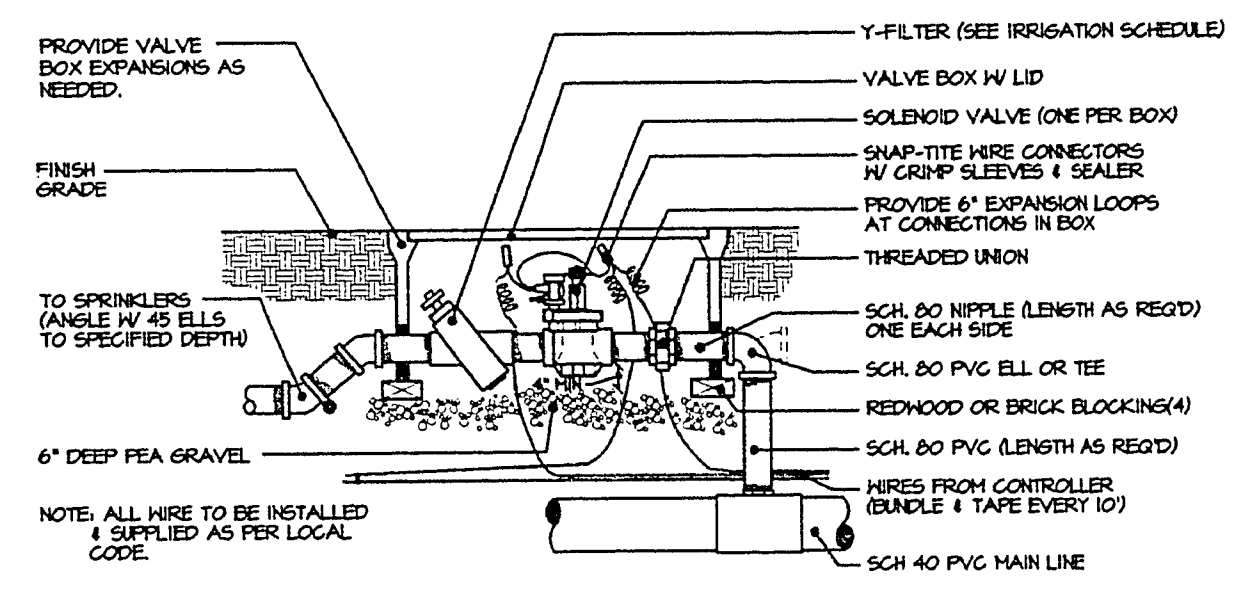


WZUNINO & ASSOCIATES
LANDSCAPE ARCHITECTURE • LAND PLANNING
3305 W. SPRING MOUNTAIN ROAD LAS VEGAS, NEVADA 89102
SUITE 90 PHONE: (702) 253-9390 • FAX: 253-1076

REV	DATE	BY	DESCRIPTION
1	2/6/05	TAG	CHANGE PRESSURE REGULATOR TO WILKINS

DRAWN BY: JLM
DESIGNED BY: JLM
APPROVED BY: JLM

THE WILKINS GROUP, INC.
ENGINEERS & ARCHITECTS
2075 SOUTH RAINBOW BOULEVARD
LAS VEGAS, NEVADA 89102
PHONE (702) 384-1085

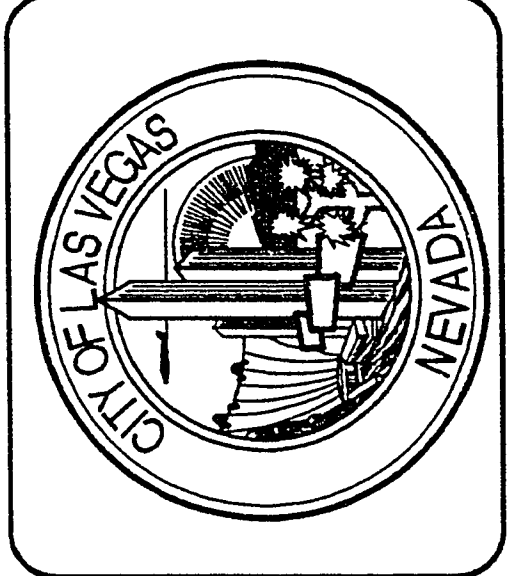

LANDSCAPE IRRIGATION DETAILS

CHILDREN'S MEMORIAL - PHASE 3

PROJECT NO: 94912
DATE: 12-16-94
SCALE: HORIZ: _____
VERT: _____
DWG FILE: _____

SHEET 14 of 15
L7
OF 8 SHEETS

Revised 650.35-4

ROUTED 12-16-94 TIME: 7 AM