18-13-45

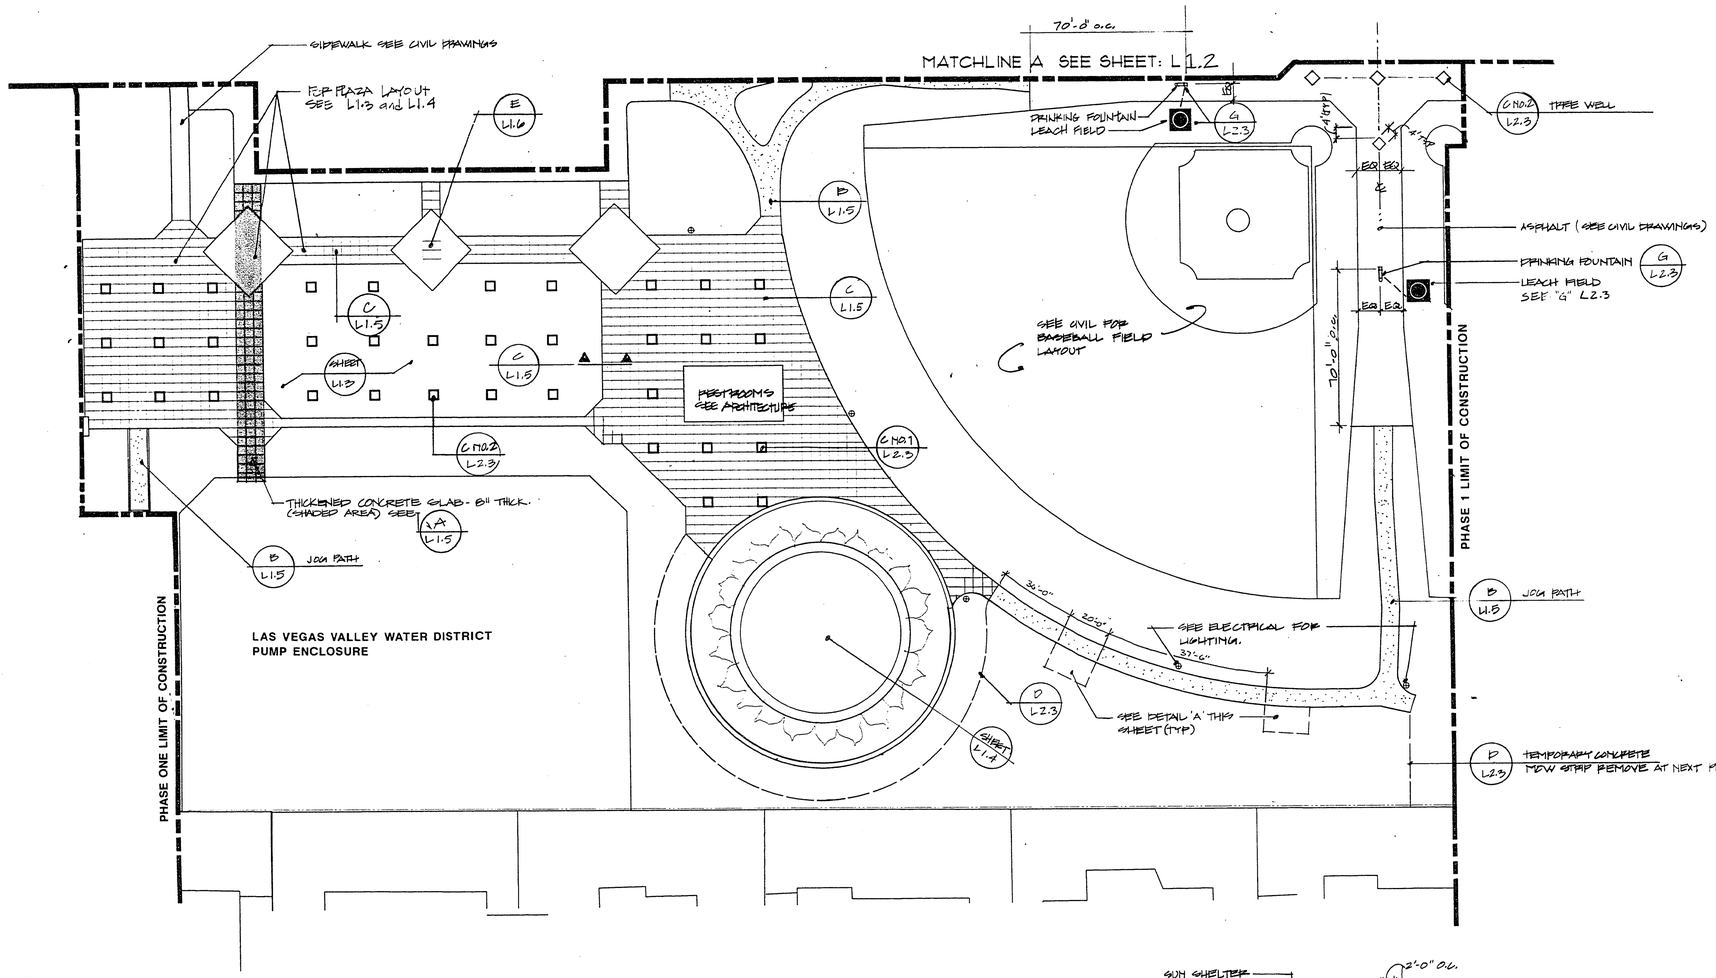

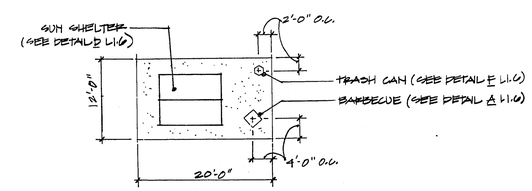

A L2.1 **PICNIC SHELTER LAYOUT**

LANDSCAPE LAYOUT

1"=30'-0"

NORTH

DARIN M. HULL REGISTERED 318 LANDSCAPE ARCHITECT STATE OF NEVADA

AS BUILT

REV.	DATE	BY	REVISION

THE MARK GROUP CONSULTANTS & ENGINEERS, INC.
2300 PASEO DEL PRADO SUITE D 108
LAS VEGAS, NEVADA 89102
PHONE (702) 364-1066

DRAWN BY
DESIGNED BY
APPROVED BY

JWZ/JUNINO ASSOCIATES LANDSCAPE ARCHITECTS AND PLANNERS INC.
2300 W. SHAHAD MOUNTAIN ROAD LAS VEGAS, NEVADA 89102
SUITE 30 PHONE (702) 256-3388 FAX (702) 256-3388

TITLE: LAYOUT PLAN

PROJECT: CHILDRENS MEMORIAL PARK

PROJECT NO. JWZ-91403
DATE : MAY 4 1992
SCALE : HORIZ. 1"=30'-0"

SHEET L1.1
23 OF 38 SHEETS

650.35-VI

91403/CLYL1