1873-56

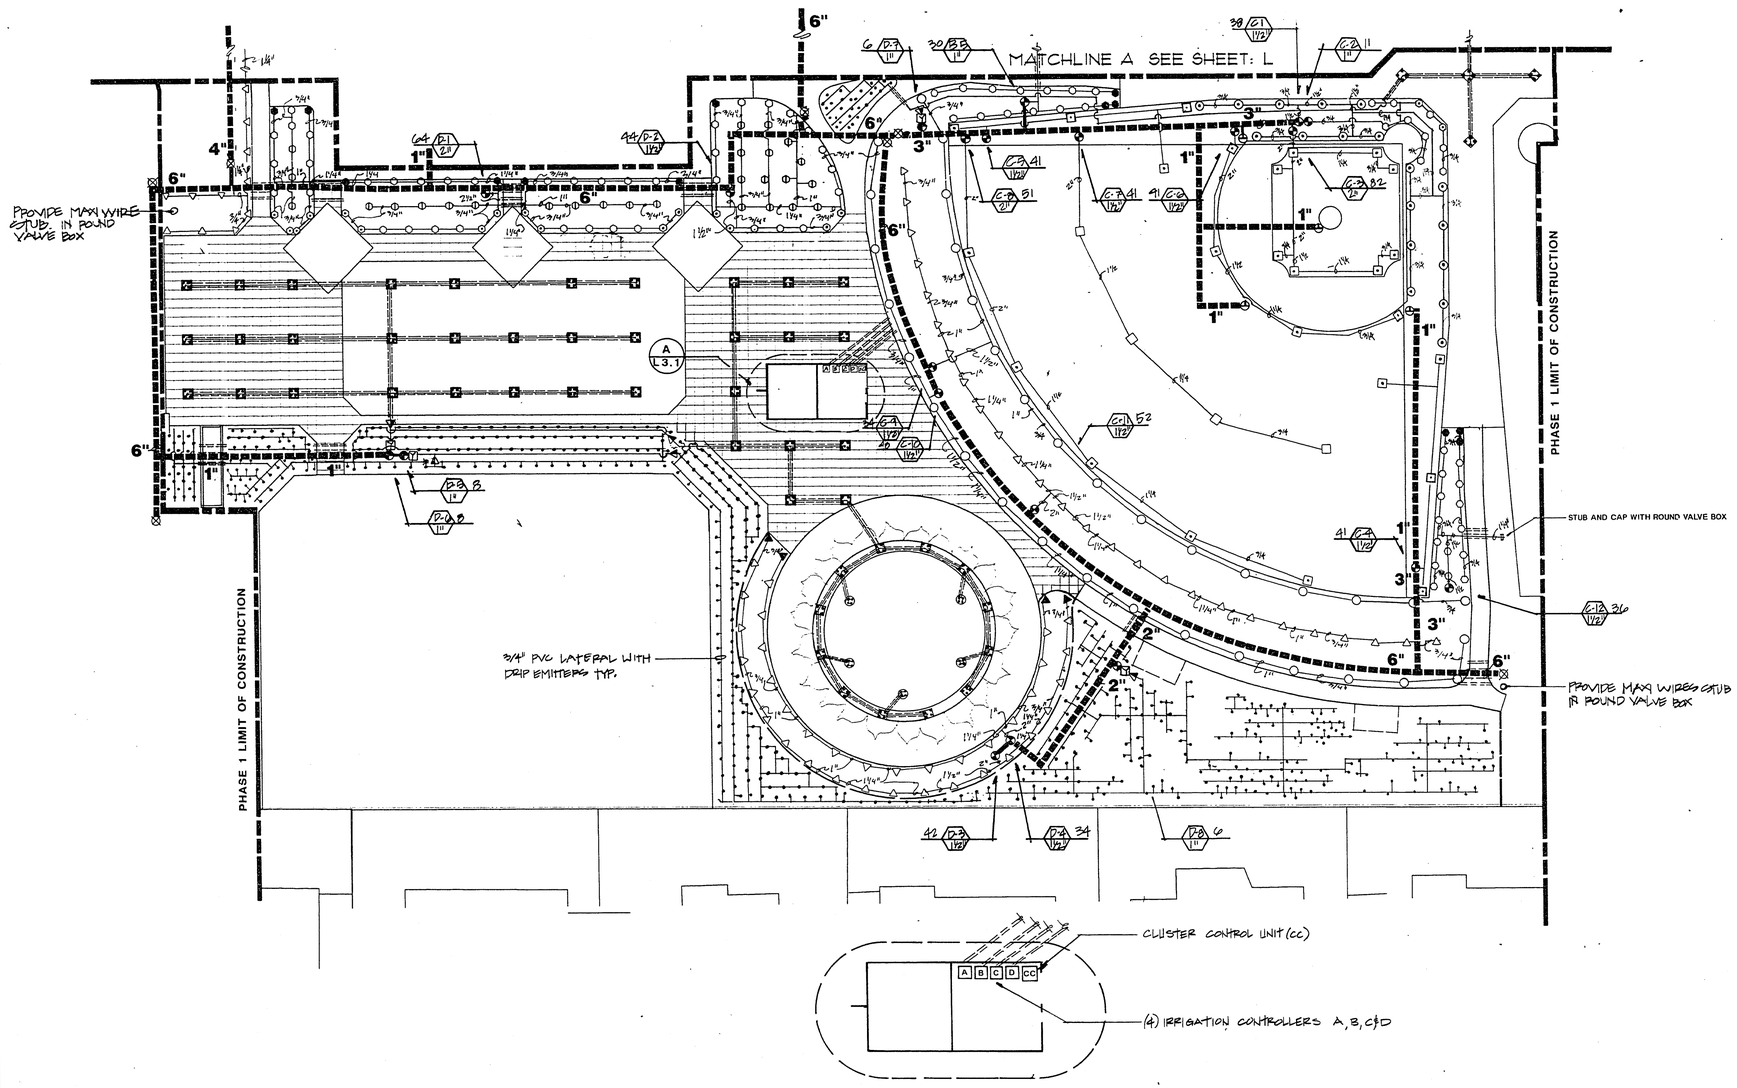

A / L 3.1 ENLARGED IRRIGATION CONTROLLER LOCATION
N.T.S.

IRRIGATION PLAN

1"=30'-0"

NORTH

AS BUILT

REV.	DATE	BY	REVISION

THE MARK GROUP
CONSULTING & DEVELOPMENT, INC.
2300 PASEO DEL PRADO SUITE D 108
LAS VEGAS, NEVADA 89102
PHONE (702) 364-1066

DRAWN BY
DESIGNED BY
APPROVED BY

JWZ LANDSCAPE ARCHITECTS
JWZ ASSOCIATES, INC.
LAS VEGAS, NEVADA

TITLE: IRRIGATION PLAN

PROJECT: CHILDRENS MEMORIAL PARK

PROJECT NO. JWZ-91403
DATE : MAY 4 1992
SCALE : HORIZ. 1"=30'-0"

SHEET L3.1
34 OF 38 SHEETS

650.35-VI

CLV.L31