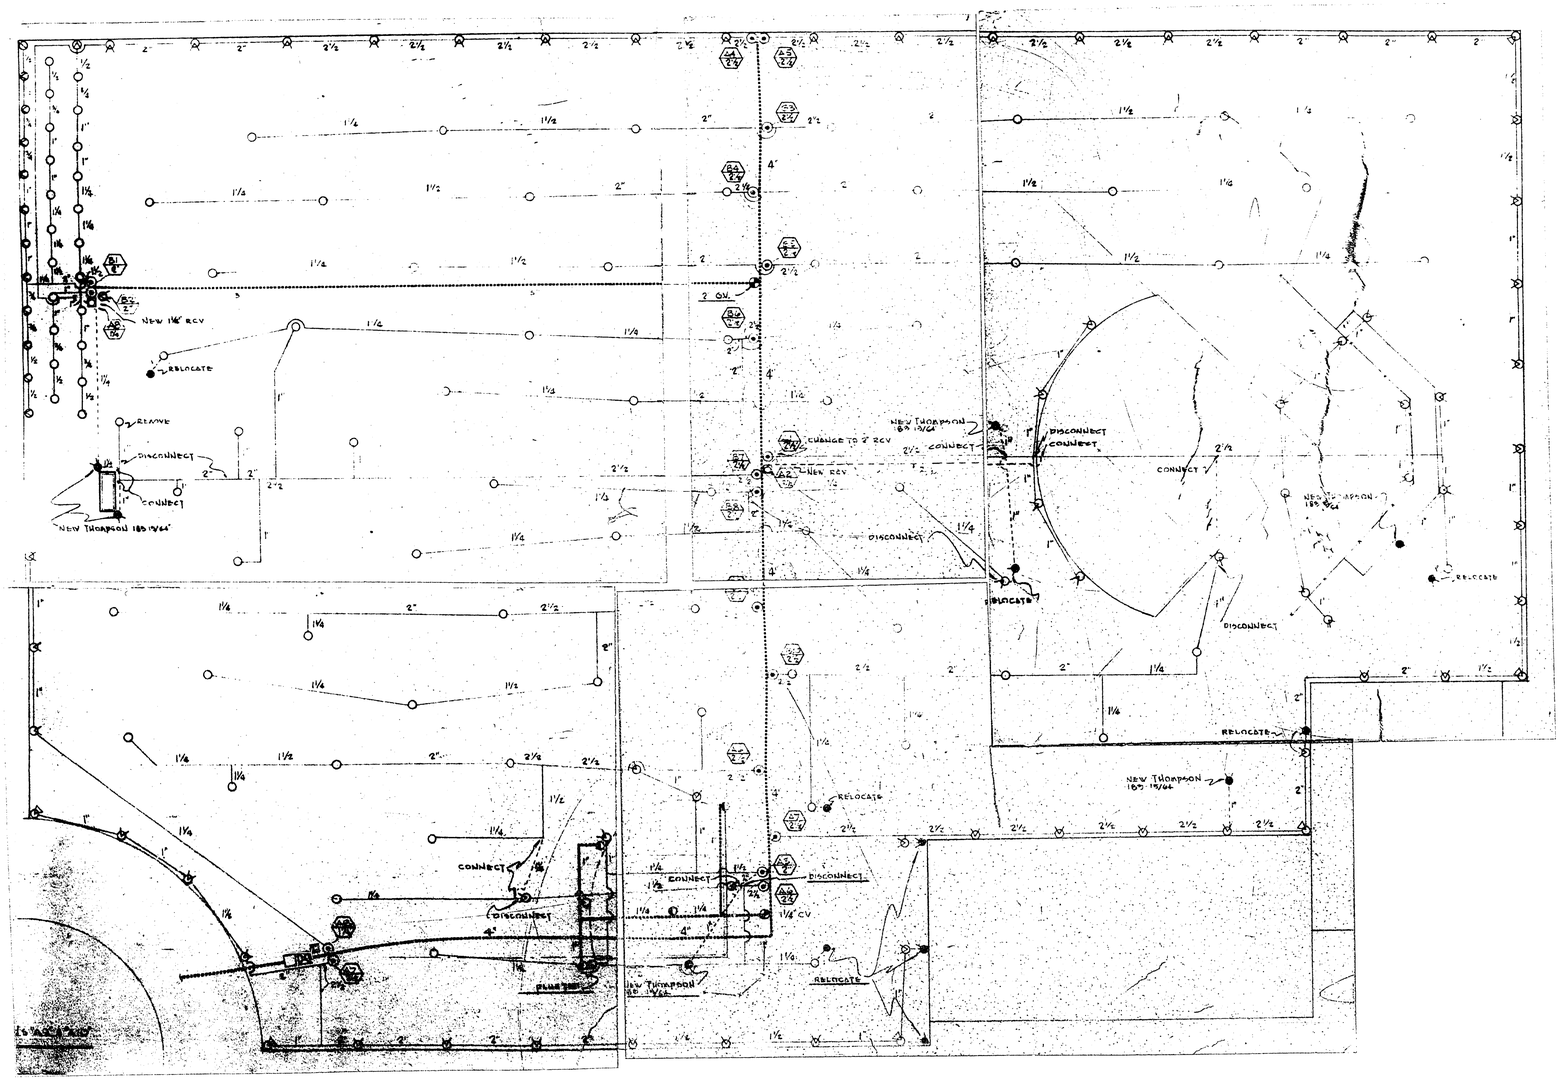
NEW 1½" RCV
RELOCATE
REMOVE
DISCONNECT
CONNECT
NEW THOMPSON 1½ 15/16"
2" CV
CHANGE TO 2" RCV
NEW RCV
NEW THOMPSON 1½ 15/16
DISCONNECT
CONNECT
RELOCATE
1¼" CV
PLUG

650-4-27A