
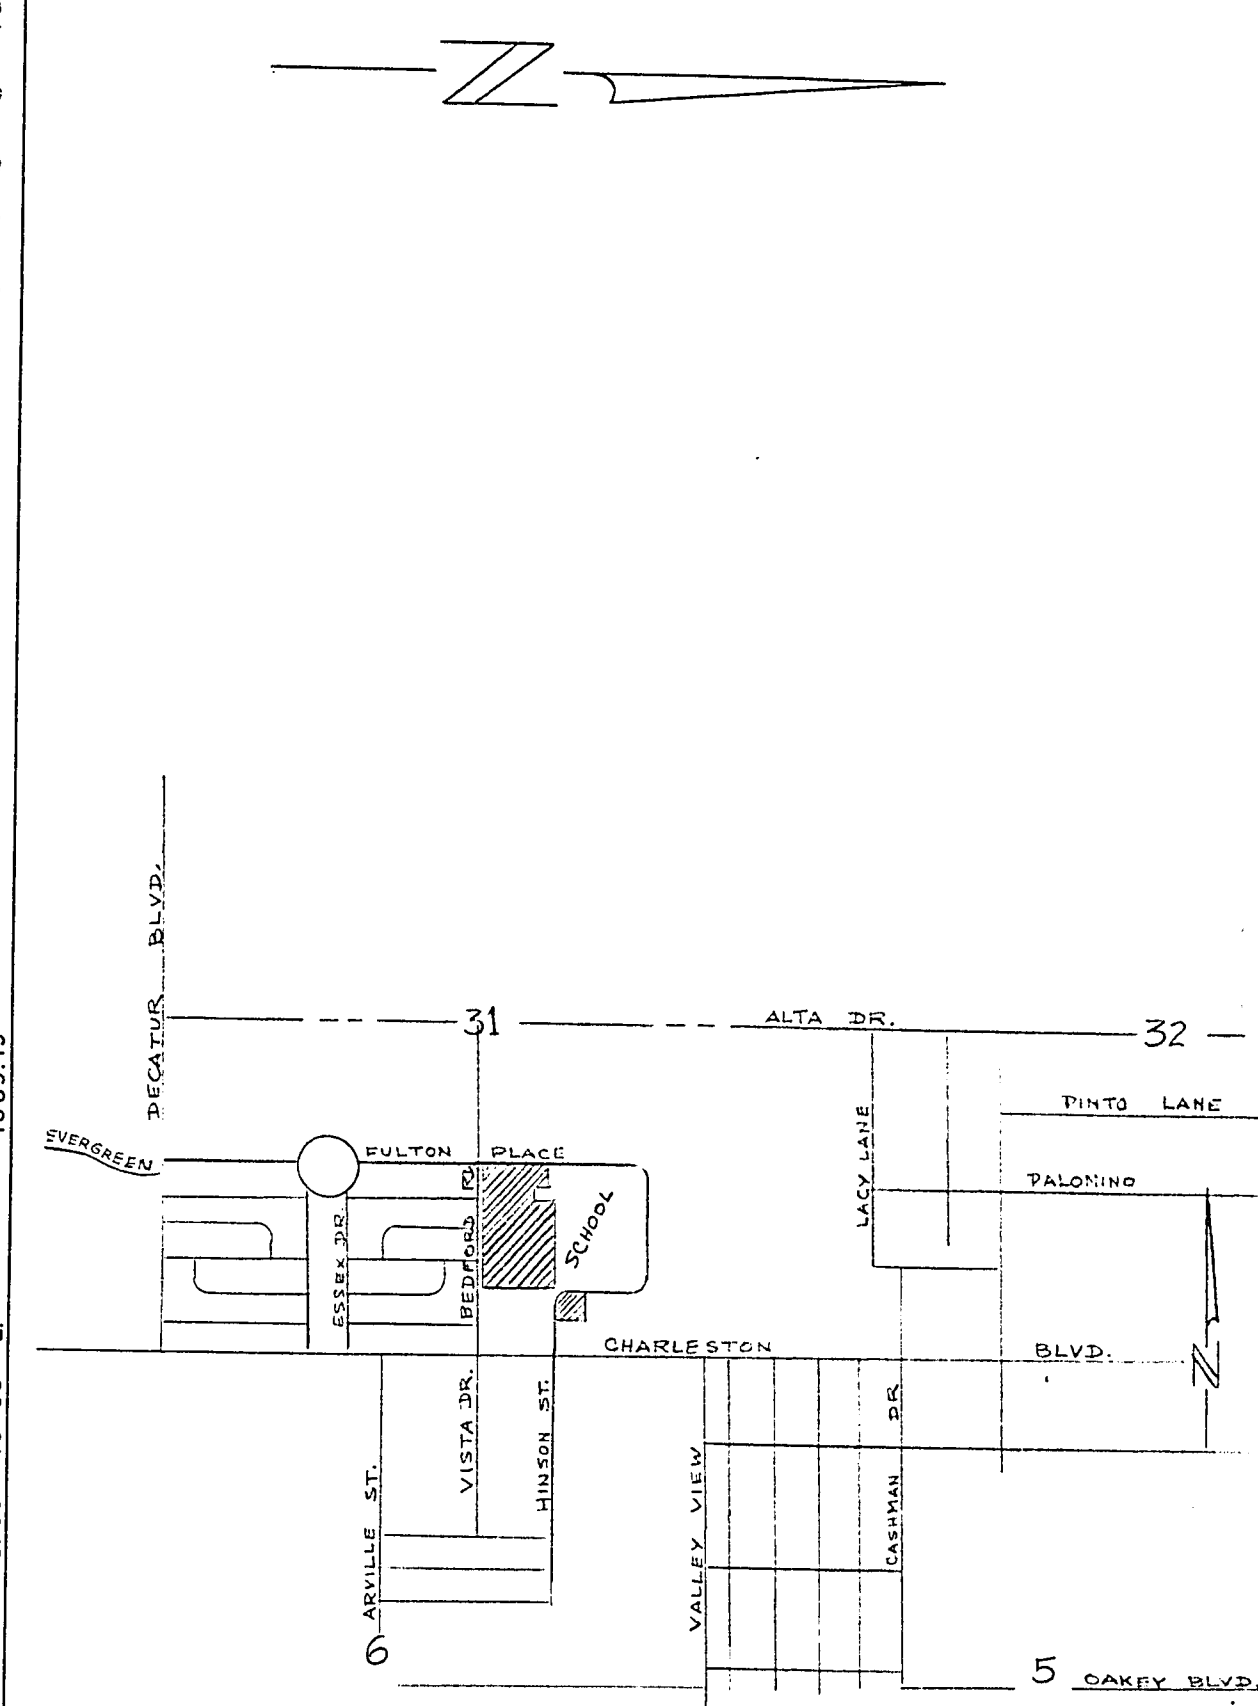


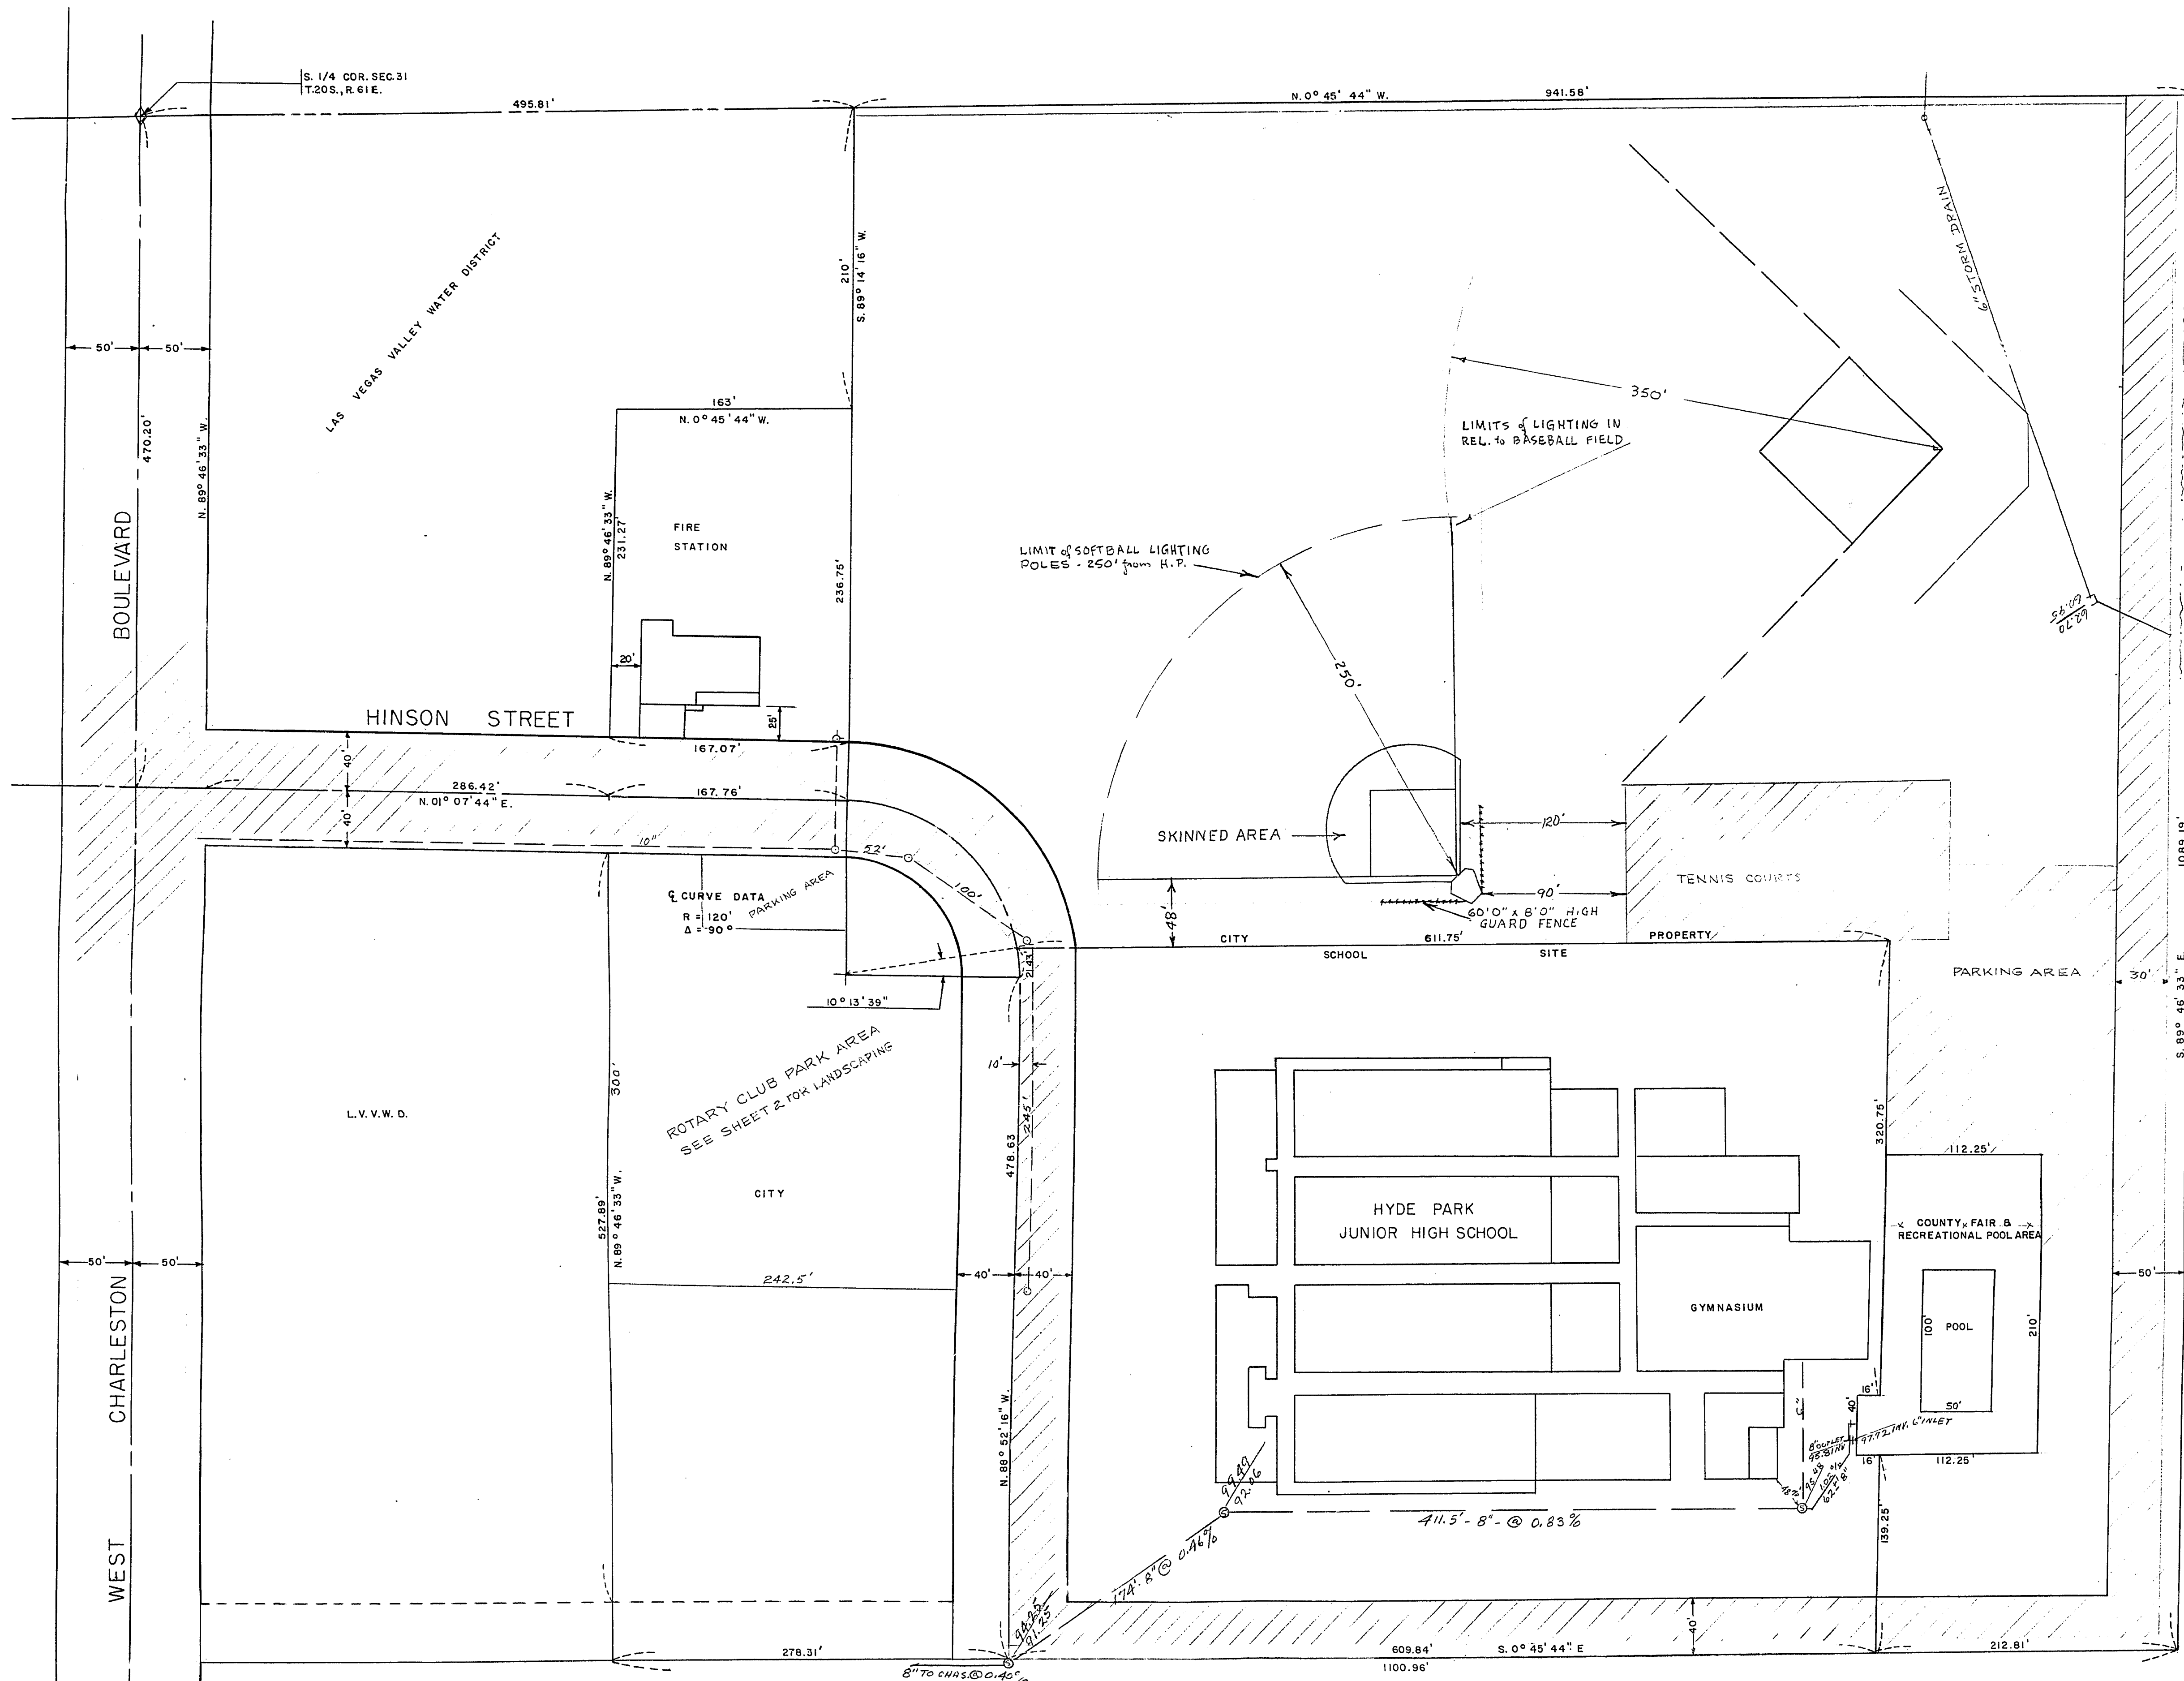

FOR DETAIL OF POOL DRAINAGE SEE DRWG. 650.4-V6

APPROVALS	
N.B. Trent, Supt. of Rec.	
Kenneth Hadland, Park Supt.	

CITY OF LAS VEGAS NEVADA ENGINEERING DEPT.			
CRAGIN PARK RECREATIONAL AREA GENERAL LAYOUT PLAN			
DESIGNED BY	DATE	SCALE	1" = 60'
DRAWN BY LEA HARPER	8-10-57	FIELD BOOK NO.	NONE
CHECKED BY B. J. [Signature]	9-11-57	WORK ORDER NO.	50-89-11
APPROVED [Signature]	1/12/57	DRAWING NO.	650.4-V7
CITY ENGR.			

REVISIONS		
NO.	BY	DESCRIPTION
1	LM	CHANGE IN POOL AREA DIMENSIONS
2	LM	ADD LIGHTS & FOOTBALL FIELD
3	LM	RELOCATE SOFTBALL FIELD
4		
5		
6		

APPROVAL & REVISION #3
[Signature] Supt. of Recreation
[Signature] Supt. of Parks
10/5/57