
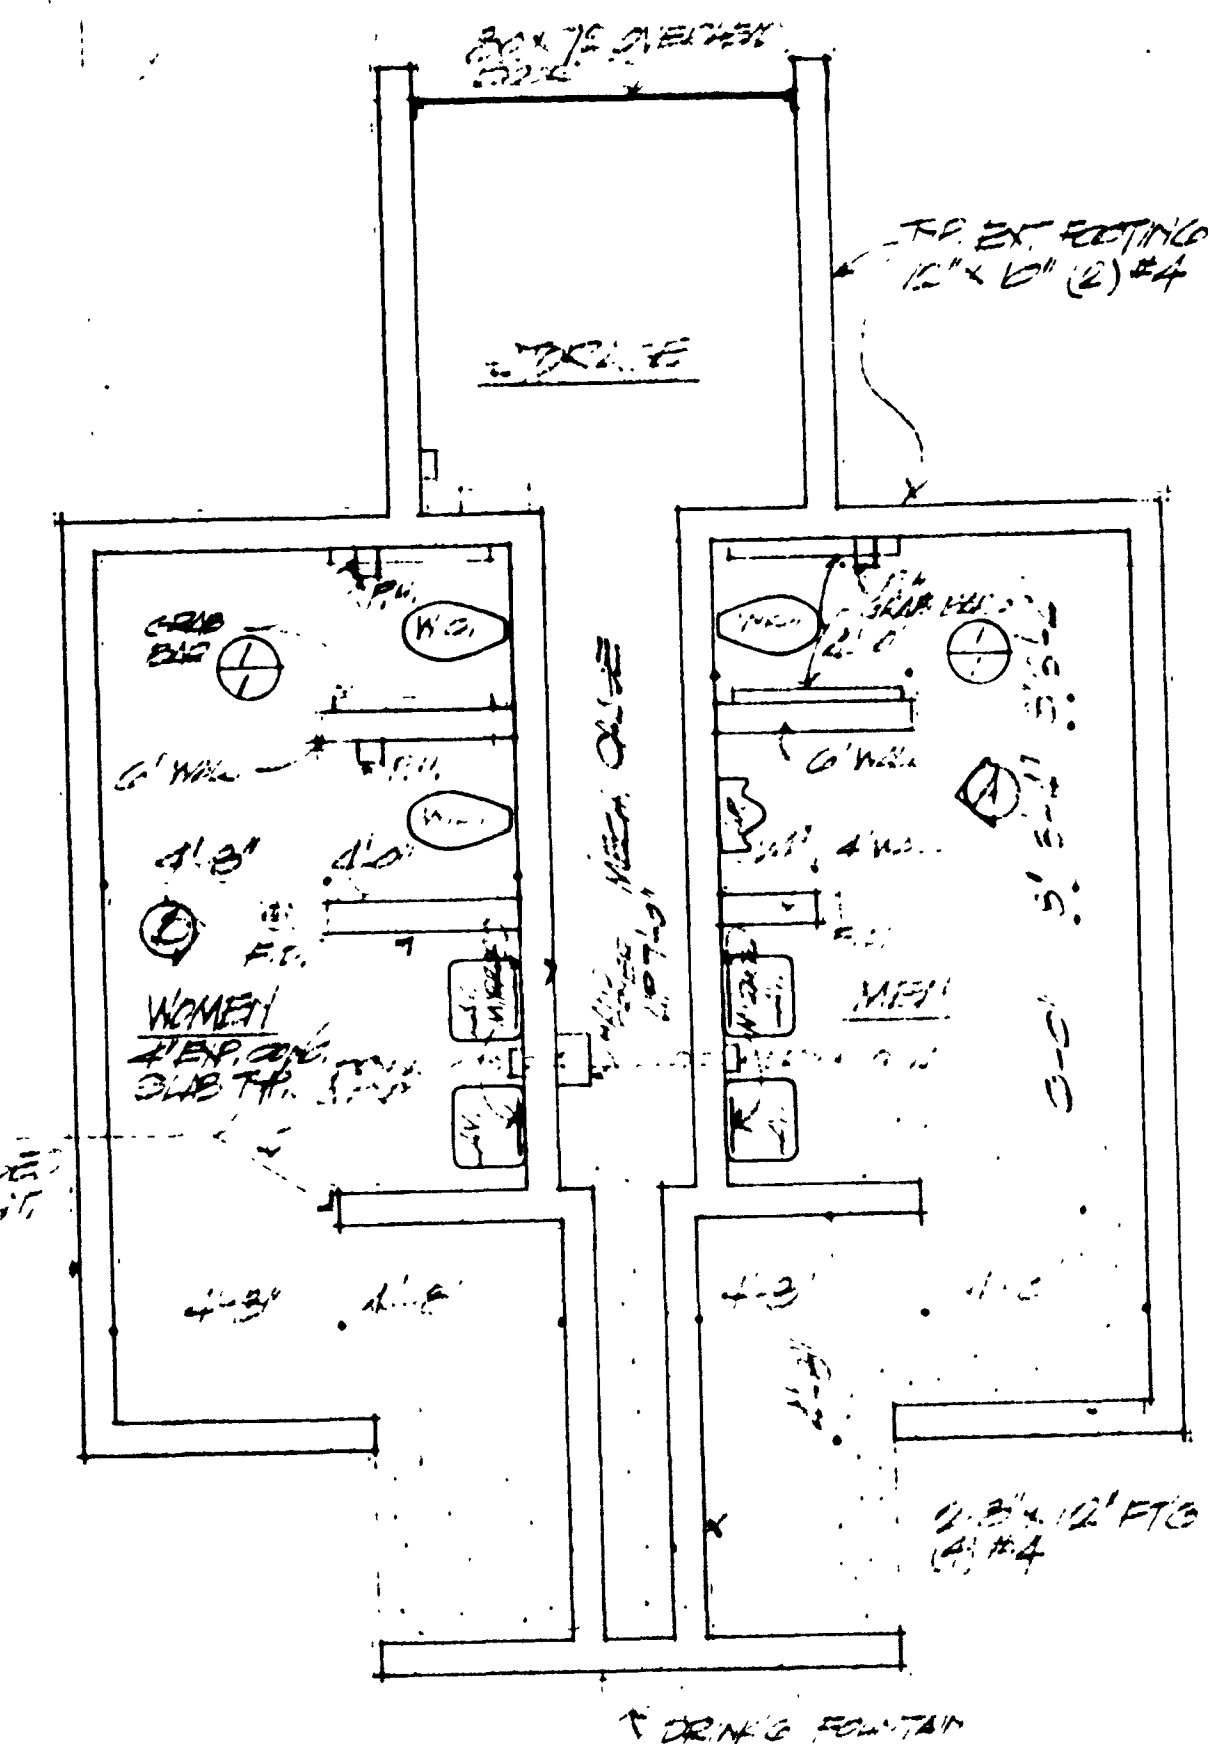
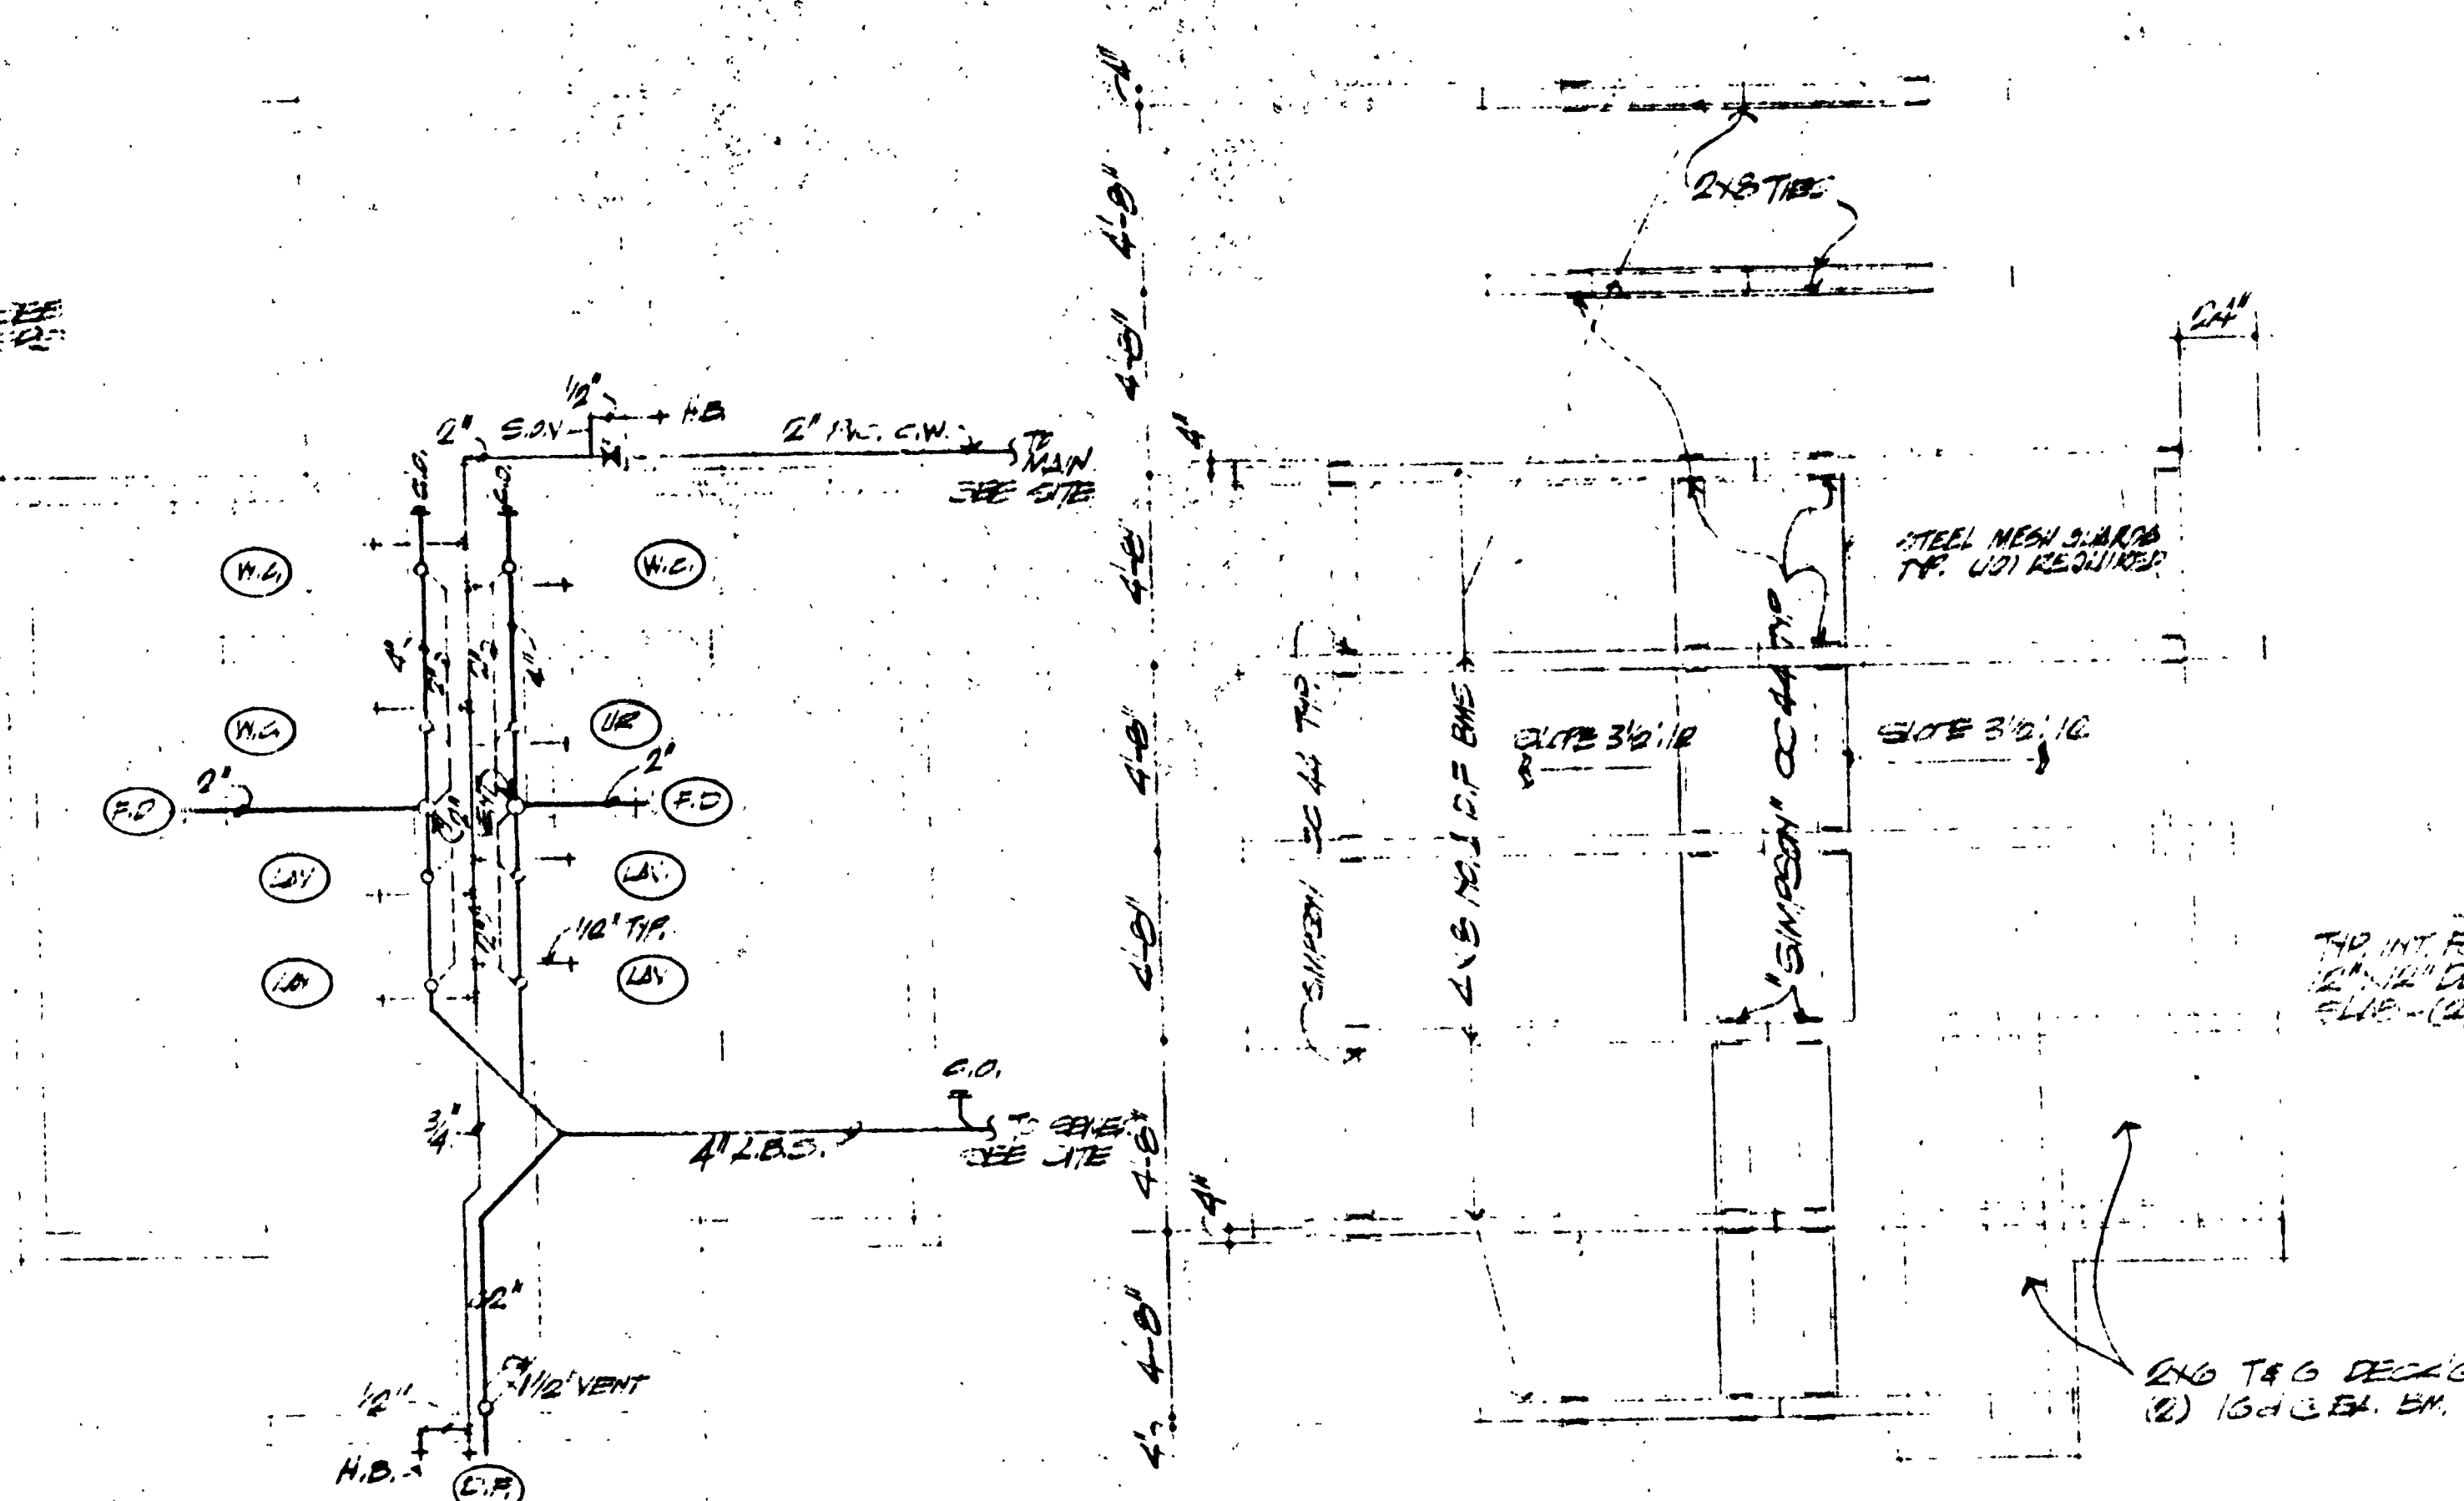


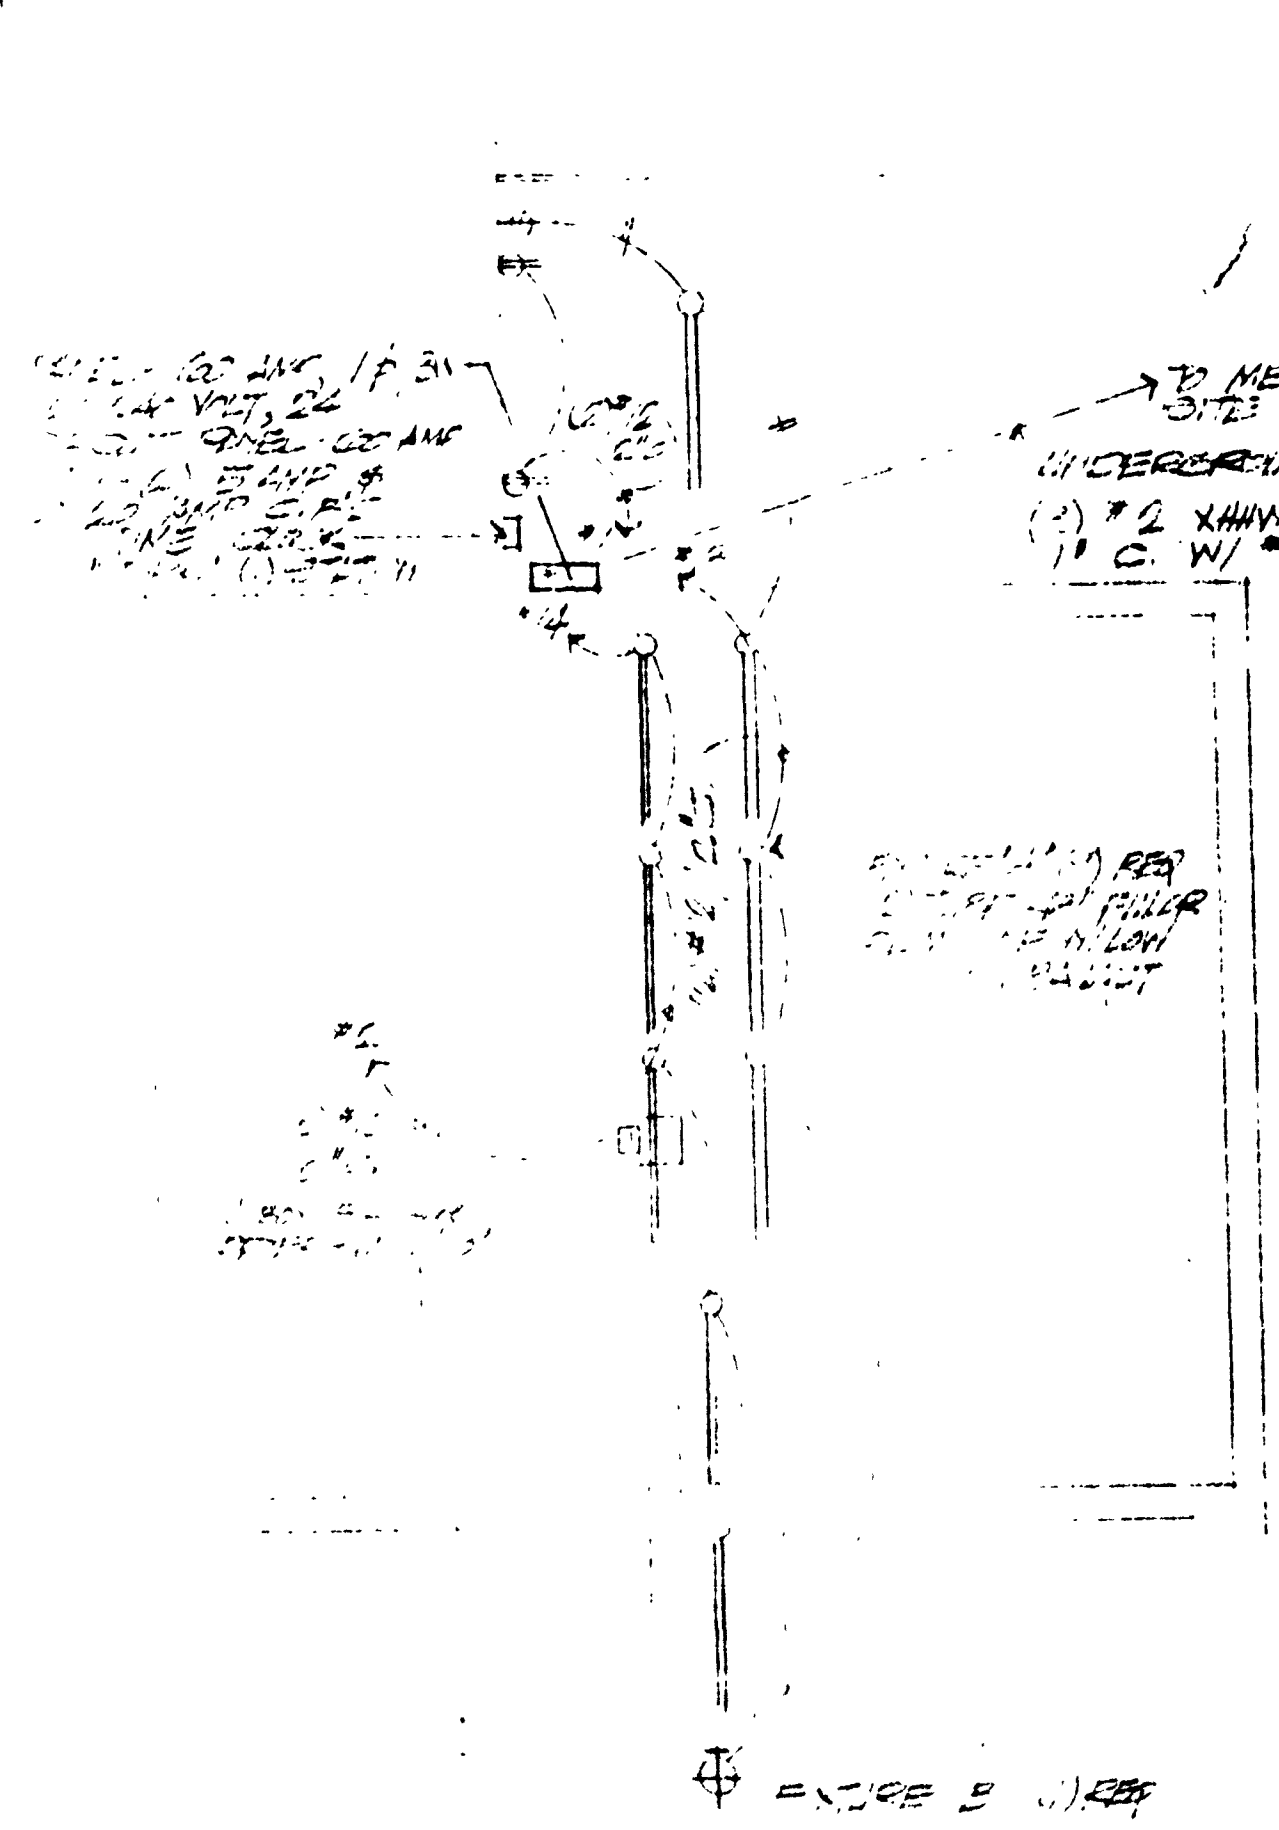

ELEC. NOTES


ELEC. PLAN


FIGURE SCHEDULE

- W.C. SUPER SECURE CS 300 W/ PUSH BUTTON GLASS FLUSH VALVE
- U.R. SUPER SECURE CS 300 W/ PUSH BUTTON GLASS FLUSH VALVE
- LAV. SUPER SECURE CS 755 W/ COLD WATER PUSH BUTTON VALVE
- D.F. HANGS 1011 (BRONZE CS NO. 10 B) FLUSH W/ PUSH BUTTON VALVE - MT. CS 35" FROM MT.
- F.O. J.R. SMITH 4010-2-1" NICKEL BRASS 1/2" 5" ROUND VERTICAL PRIZE
- H.B. J.R. SMITH (RECESSED) * 5710 COMPLETE W/ BOX

NOTES:

1. ALL WATER & WASTE IN CHASE SHALL BE WALL MT.
2. WATER VALVES FOR W.C. & U.R. SHALL BE INSTALLED IN PIPE CHASE
3. WATER LINES TO BUILDING SHALL BE COPPER - 1" COLD & 1/2" HOT - 1" ABOVE GRADE
4. 1/2" P.C. PIPE FROM MAIN TO BUILDING


PLUMBING PLAN

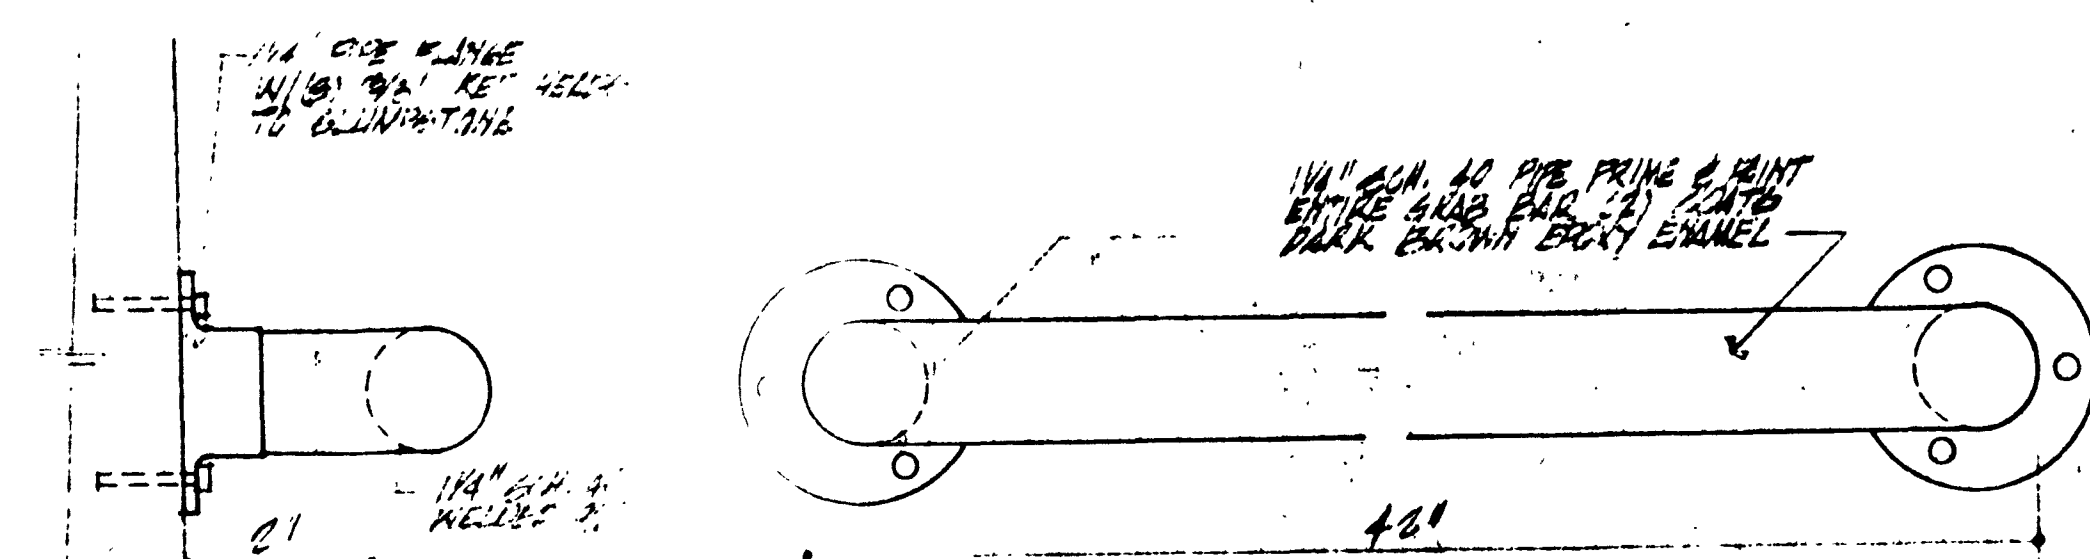

SIDE ELEV.

FRONT ELEV.

PIPE & BAR DETAIL (1)


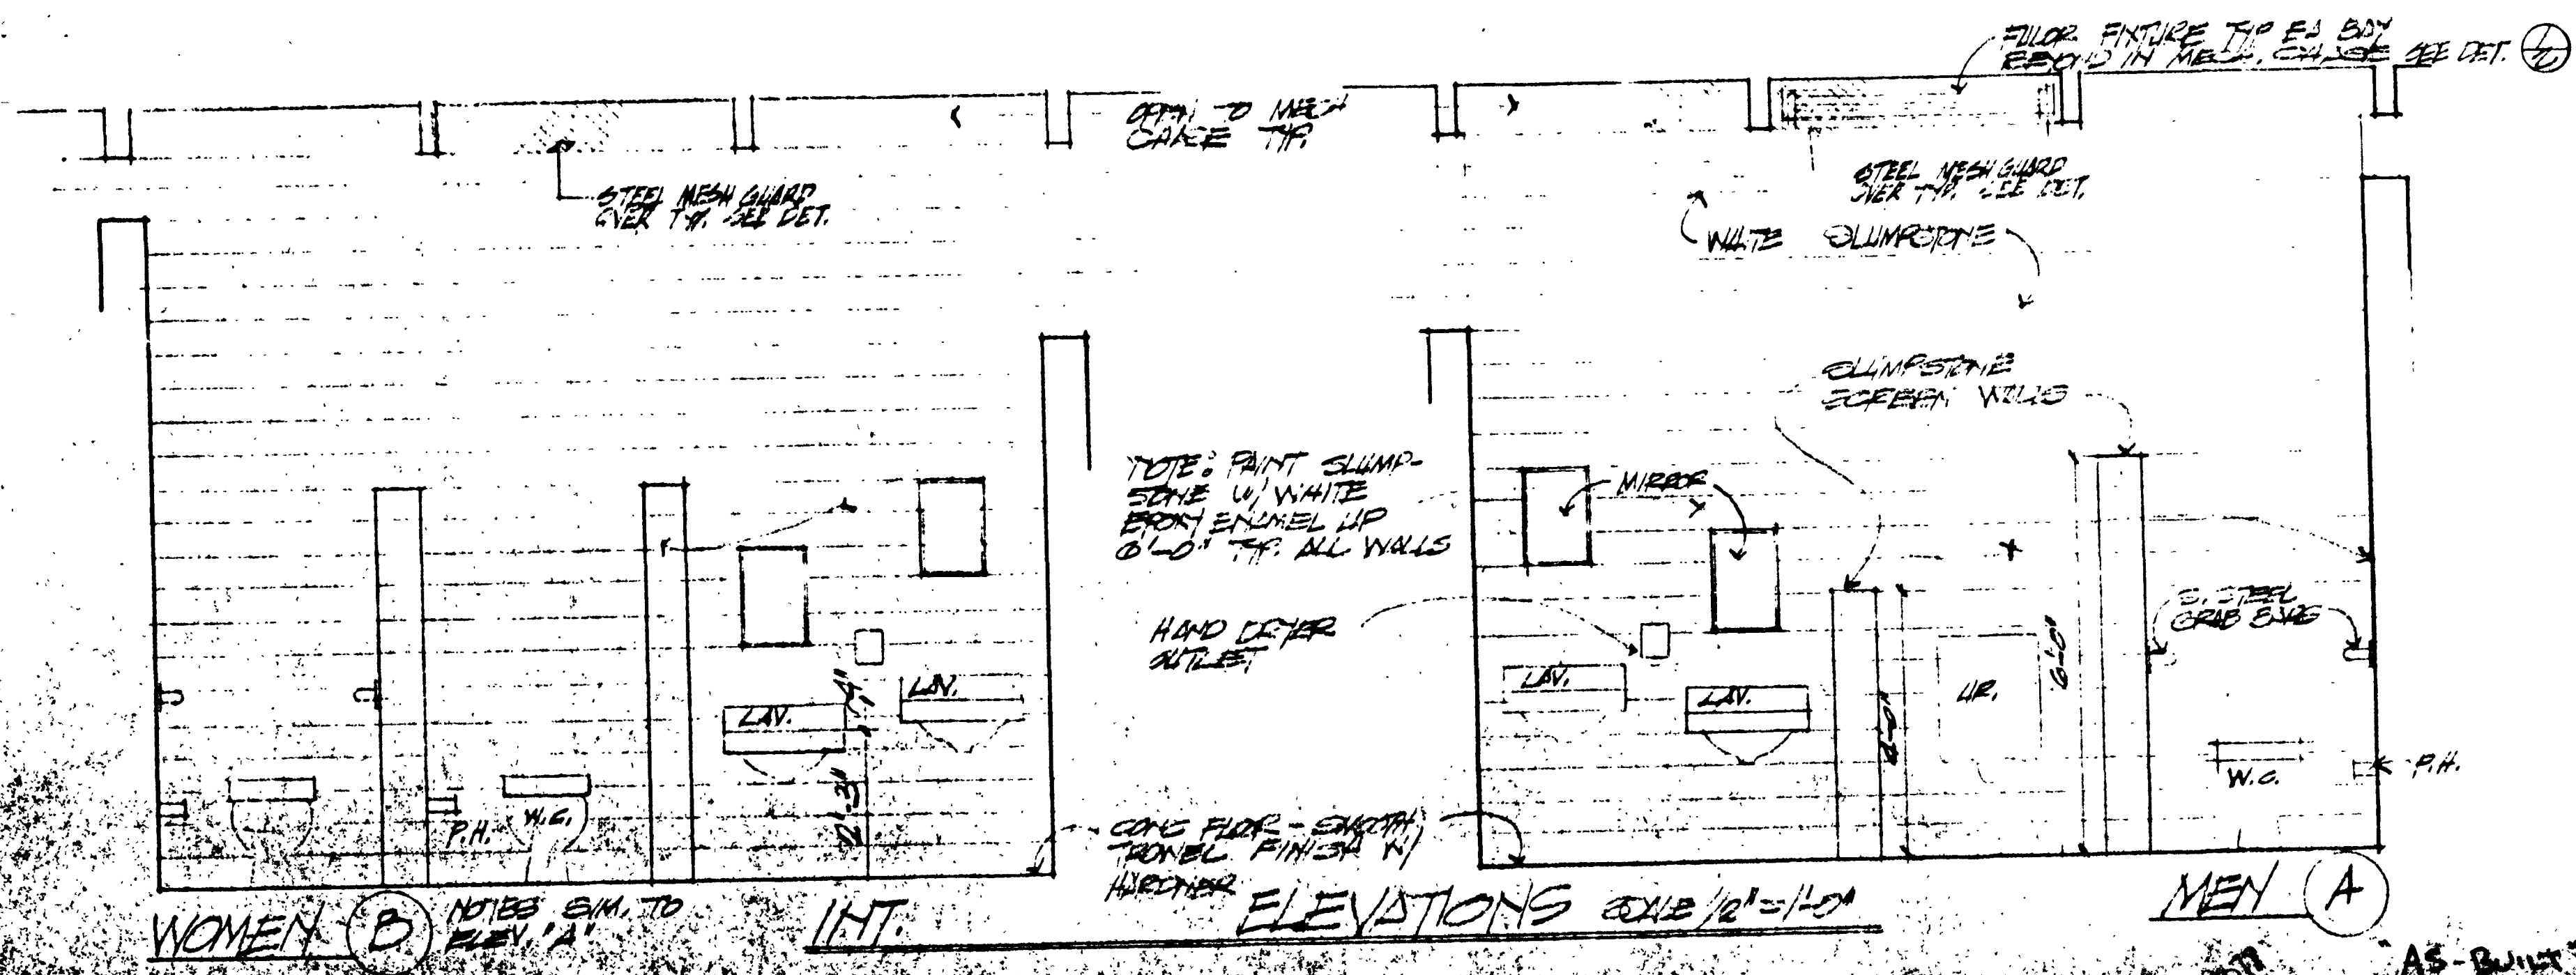


WOMEN (B) NOTES SAME TO ELEV. 'A'

INT.

ELEVATIONS SCALE 1/2" = 1'-0"

MEN (A)

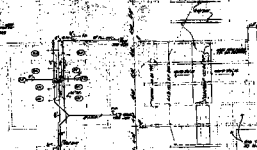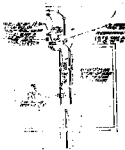

PLAN VIEW

1. L. L. LINE
2. L. L. LINE







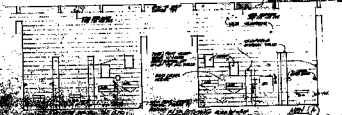



