16-13-62

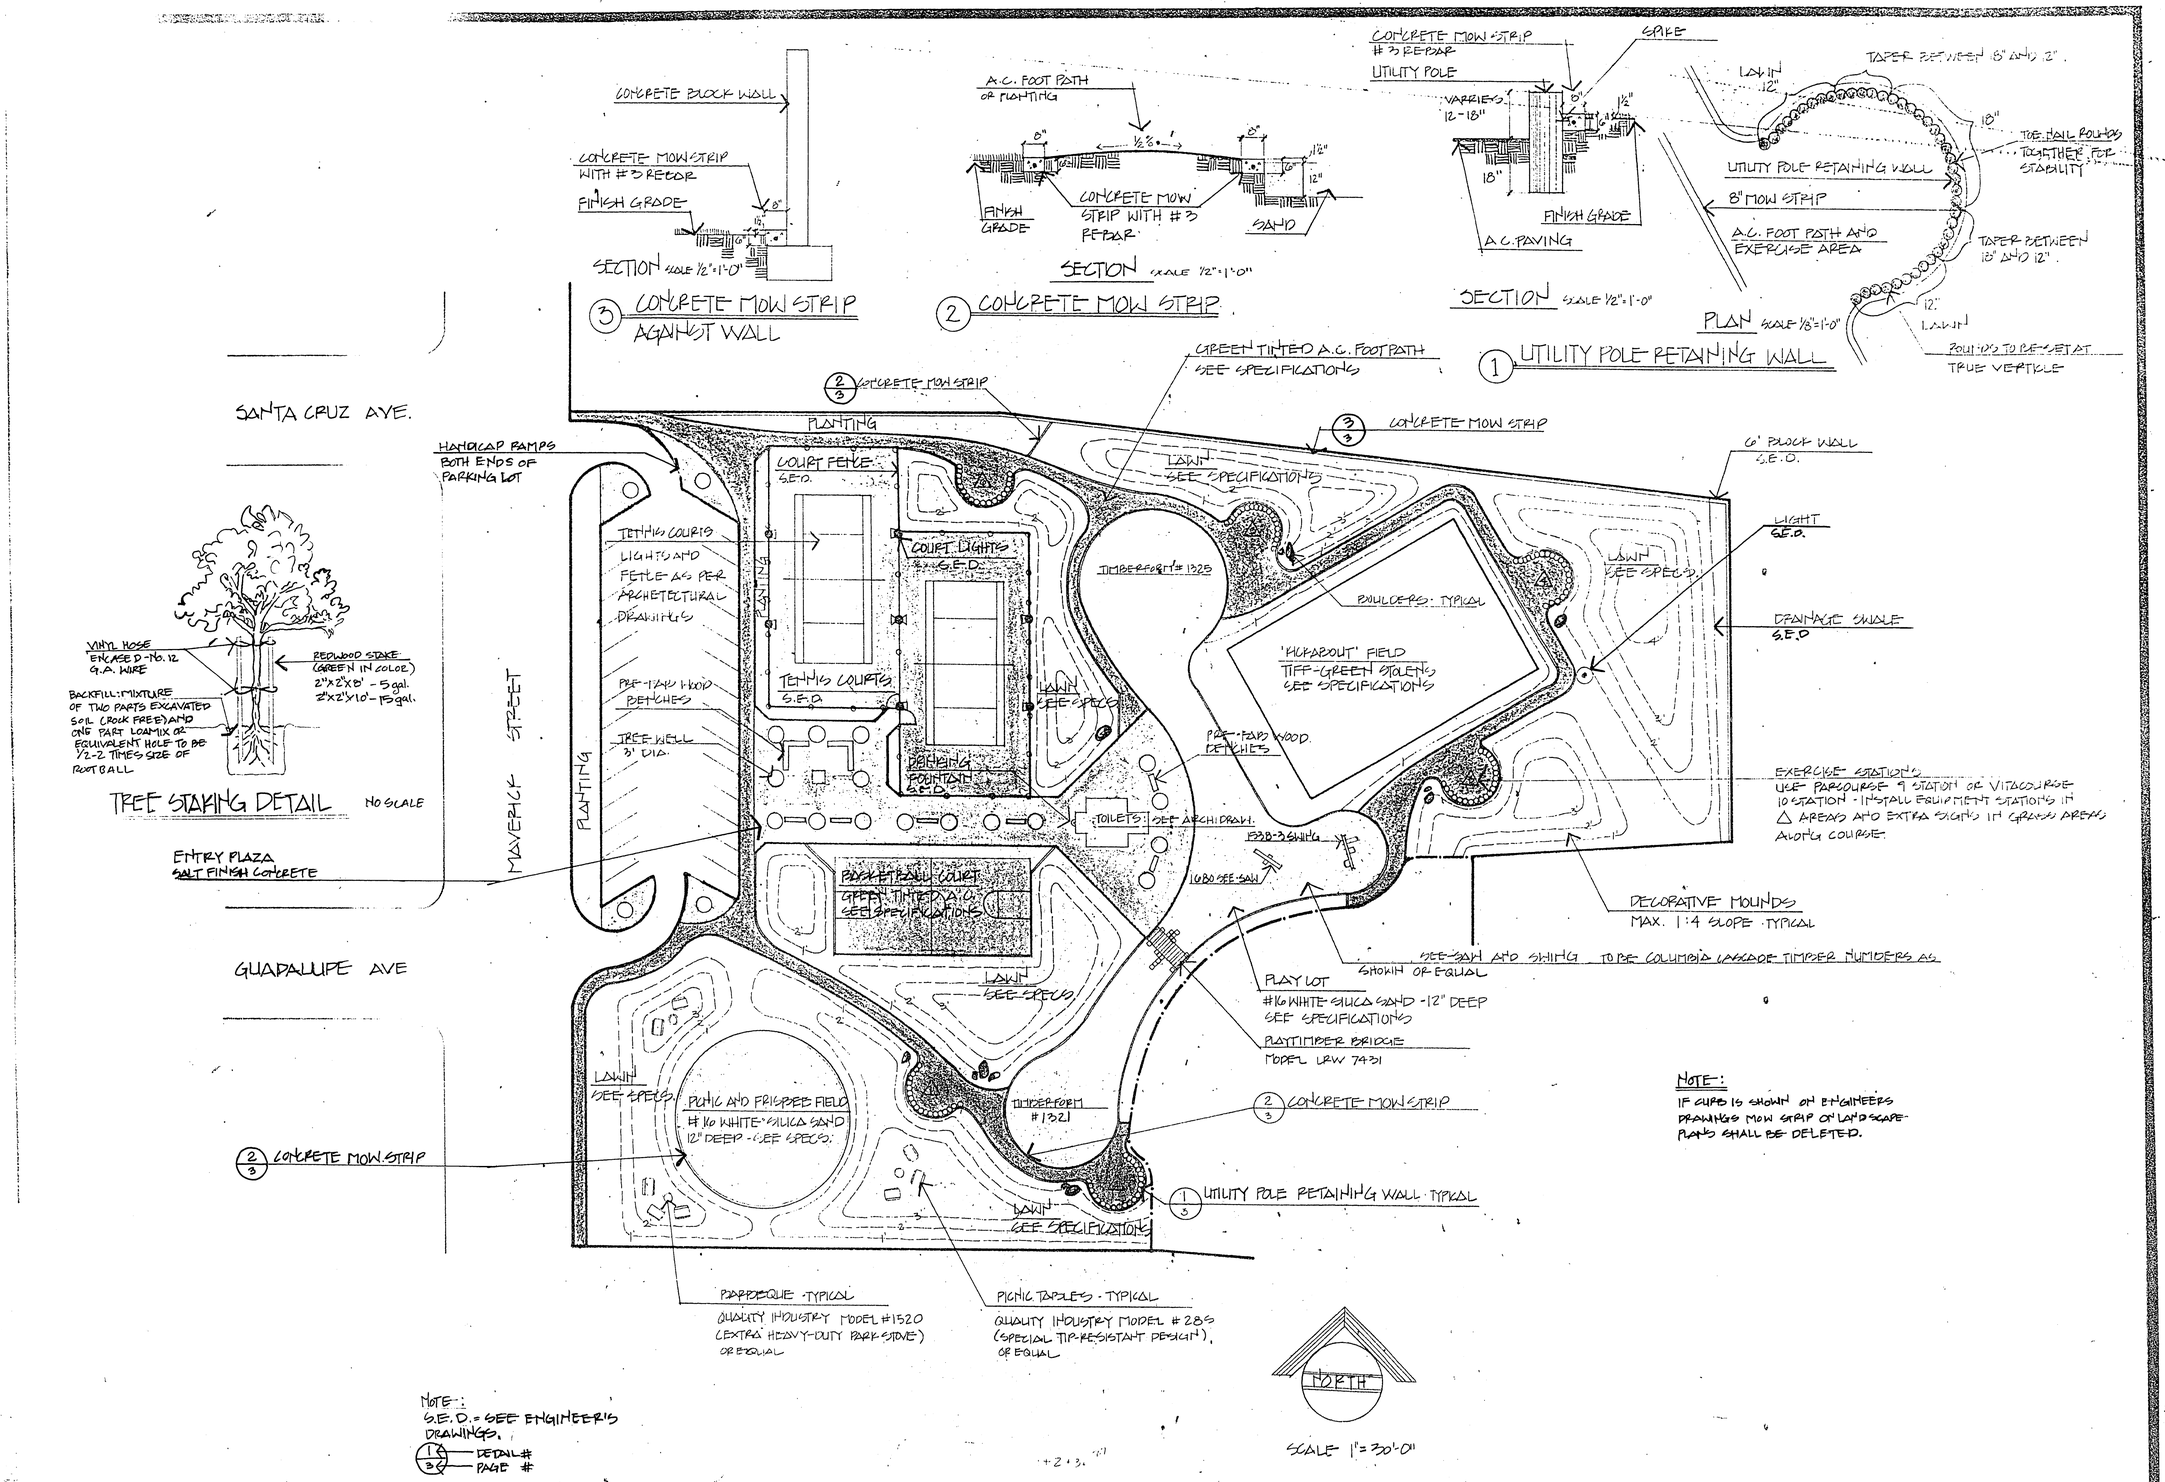

NOTE:
IF CURB IS SHOWN ON ENGINEERS DRAWINGS MOW STRIP ON LANDSCAPE PLANS SHALL BE DELETED.

"AS-BUILT"

SHEET TITLE
CONSTRUCTION PLAN

PROJECT TITLE AND LOCATION
CHARLESTON HEIGHTS PARK
CITY OF LAS VEGAS

DRAWN BY RWJ
DESIGN BY RWJ
CHECKED BY

JOHN A. FITZPATRICK
LANDSCAPE ARCHITECT
7427 BROADWAY
LEMON GROVE, CALIF. 92045
714 466-5320
LAS VEGAS, NEV.
702 739-5868

DATE JAN 18 1977
REVISIONS

PROJECT NO. 78062
SHEET NO. 3 of 3
DATE 650.28-2