



NOTE "A"
Photo cell relay control to be similar to Fisher Pierce model # 6620-A, 120 volt, 60 cycle D.P.S.T. or approved equal. (As per std Dwg # 401.2)

NOTE "B"
Multiple street lighting relay with photo electric receptacle to be similar to Westinghouse R.C.O.C. type M.R.U.G. Spec # 338 two pole N.O. 50amp 120/240 volt A.C. with 120 volt A.C. coil and with holes A/B for 1/4" conduit or approved equal (As per std Dwg # 401.2)


1. Conduit to be placed 1 foot inside fence for future use.
2. Conduit stubs are to be marked with a shinner above the ends in the Asphalt.
3. All conduit to have a minimum of 24" cover in all areas

CHANGE TO: GARAGE & REPAIR SHOP - SATELLITE CITY YARDS.
BID NO. 70.5 - CONTRACT NO 70.5 - C.L.Y. DWG 660-V59.

CHANGE GARAGE DOOR HEADERS (6 EA.) IN
CROSS SECTION 2/7 ON SHEET 7 IN ACCORDANCE
WITH THIS SKETCH.

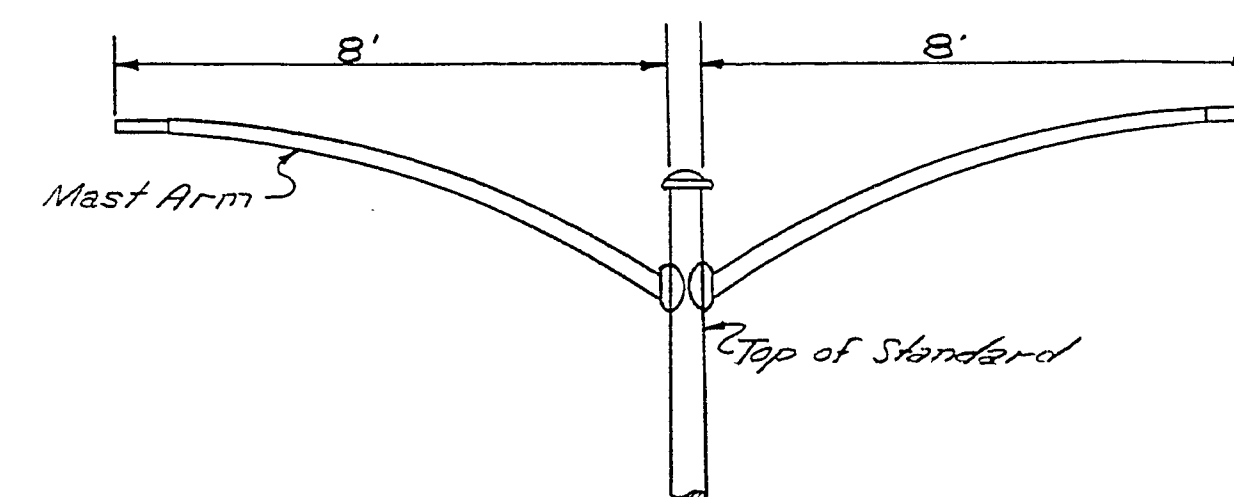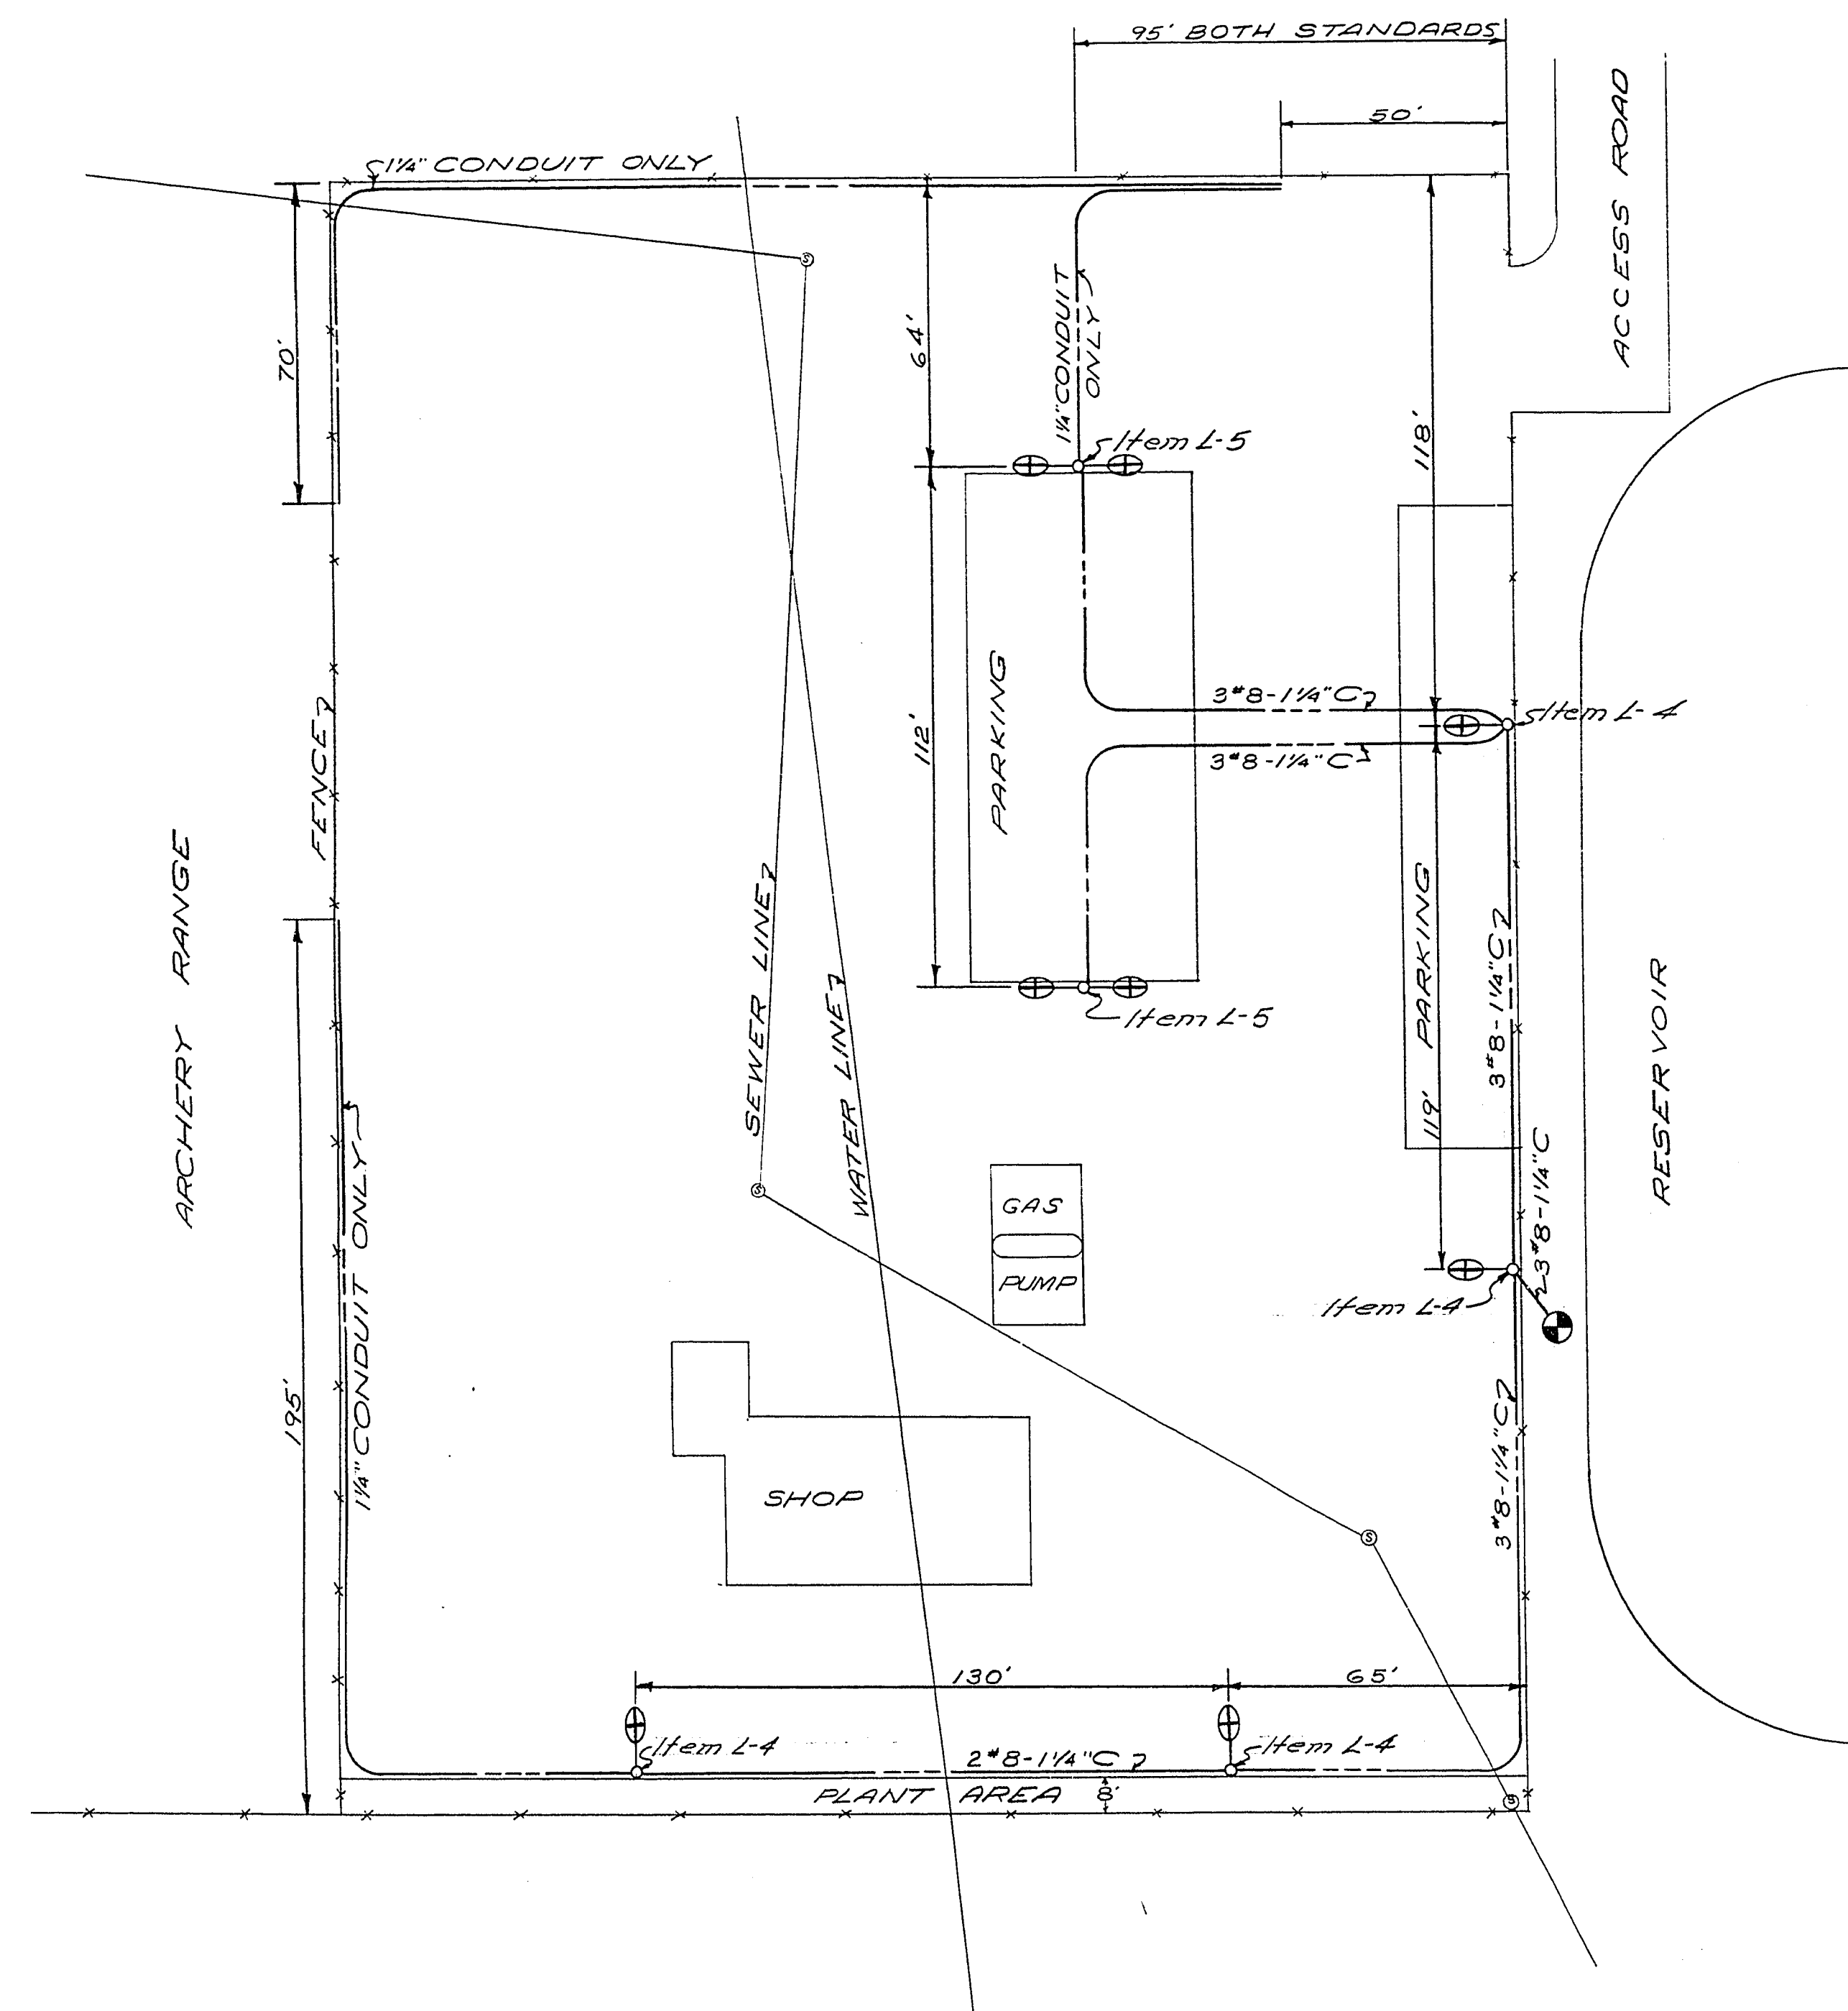

DETAIL "C"
SIMILAR STD. DWG. 400.1.
WITH DOUBLE 8' MAST ARMS

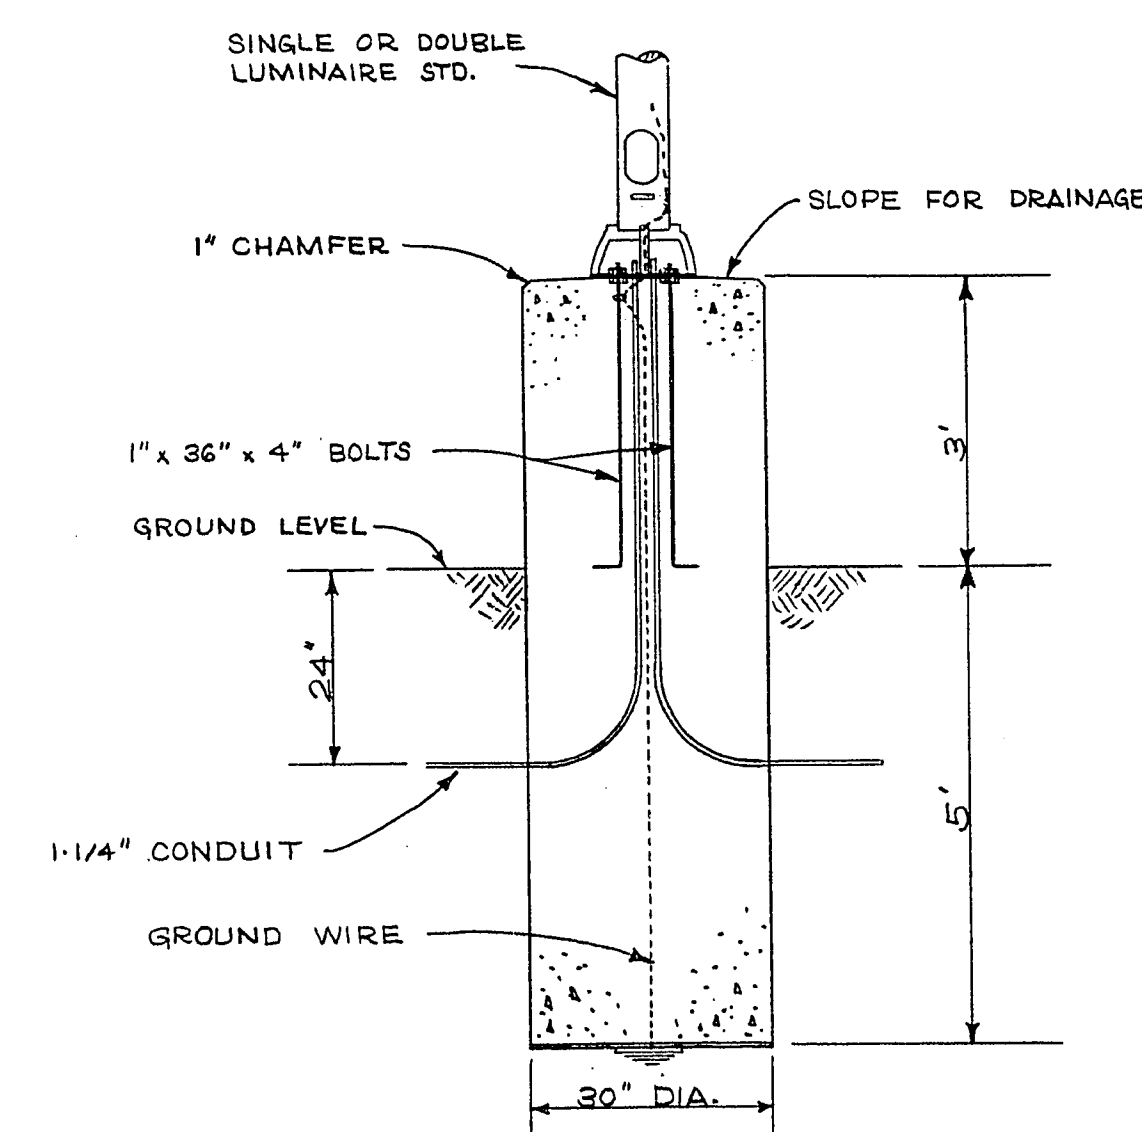


SCALE: 1" = 2'

— FOUNDATION DETAIL "B" —

SINGLE & DOUBLE LUMINAIRE STANDARDS

SIMILAR TO C.L.V. STANDARD DWG. 403.0

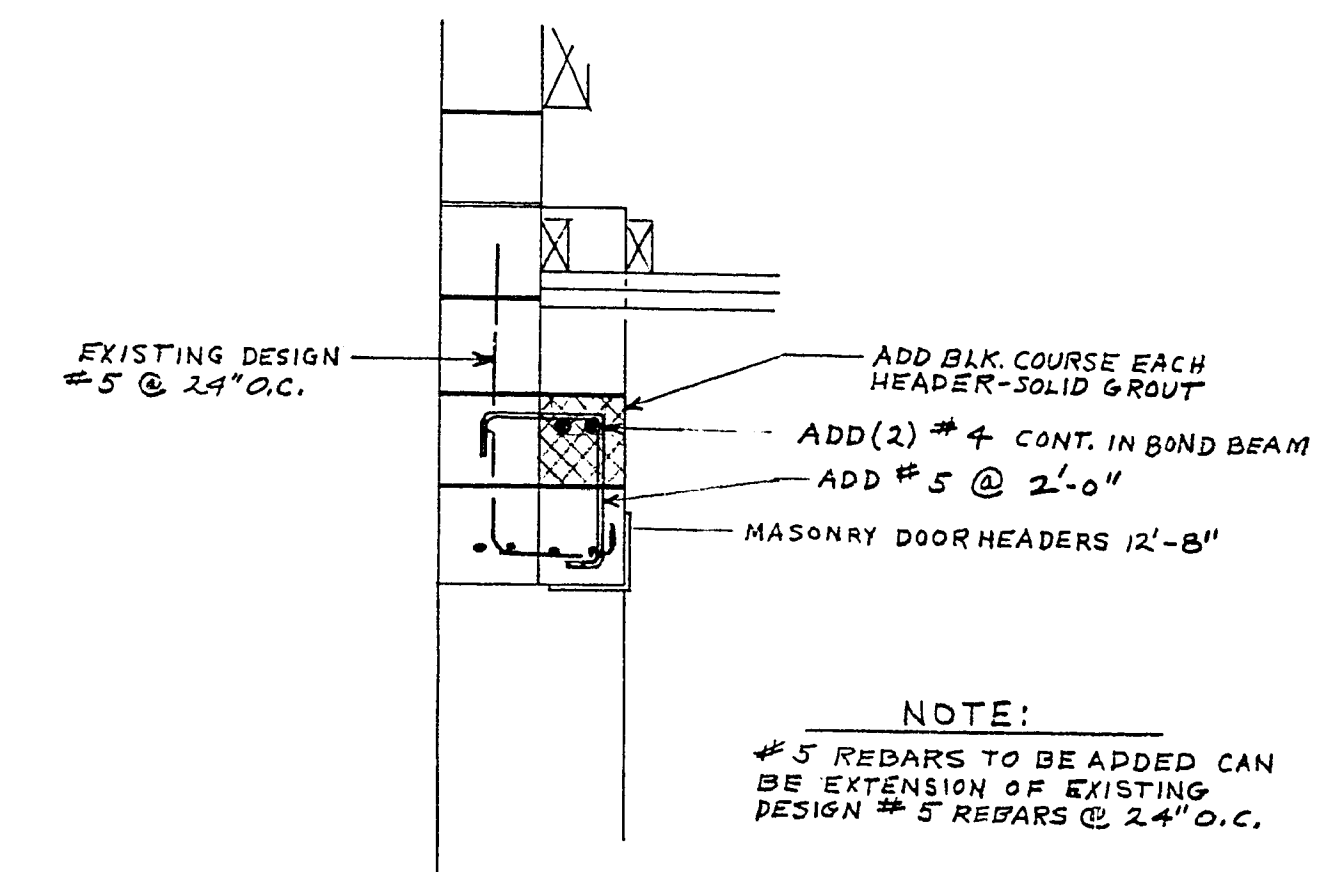

FIELD SKETCH NO. 1
DATE: 5-8-70

7.2.8

CONTRACT
DRAWING
FEB 6 1970

APPROVED		
DATE		
RT	DIV	DATE
3	D.P.W.	7/21/70
2	SERV.	7/21/70
	FIELD	
	R/W	
	TRAFF	
	UTIL	
	SUBD	
	SAD	
1	ENGR.	7/24/70

TOTAL	2	EA	L-5	1 gauge standard similar to std dwg. *400.1 except with 2-8" most arms (As per detail "C") with 400 watt 120/240volt. I.E.S. distribution type III w merc. vapor luminaire with integral constant wattage ballast on a 8' foundation complete (As per detail "B"), installed and wired including conduit wiring
	4	EA	L-4	1 gauge standard as per std dwg. *400.1 with 400watt 120/240volt I.E.S. distribution type III w merc. vapor luminaire with integral constant wattage ballast on a 8' foundation complete (As per detail "B"), installed and wired including conduit wiring.
	1	EA	L-3	Service & control installed & wired complete including conduit wiring as per std dwg. *400.1 (See Note "g" & "h")
	2734	LF	L-2	1 1/2" Street lighting conduit installed (24" minimum cover)
	2450	LF	L-1	24" Trenching
	Unit Item No. DESCRIPTION			
APPROXIMATE QUANTITIES				
CITY OF LAS VEGAS NEVADA DEPARTMENT OF PUBLIC WORKS SERVICES DIVISION				
AREA LIGHTING SATELLITE CITY YARD				
W.O. NO. 9740		F.B.K. NO.	DATE	DRAWING NO.
SC. (H) 1" = 30'		SC. (V)		
DES. <i>John Curry</i>			1-28-70	
DR. <i>John Curry</i>			1-16-70	FILE NO.
APPROVED BY DIRECTOR OF PUBLIC WORKS				660-59
<i>R. J. Sawyer</i> FEB 4 1970				
				SHEET 18 OF 18