
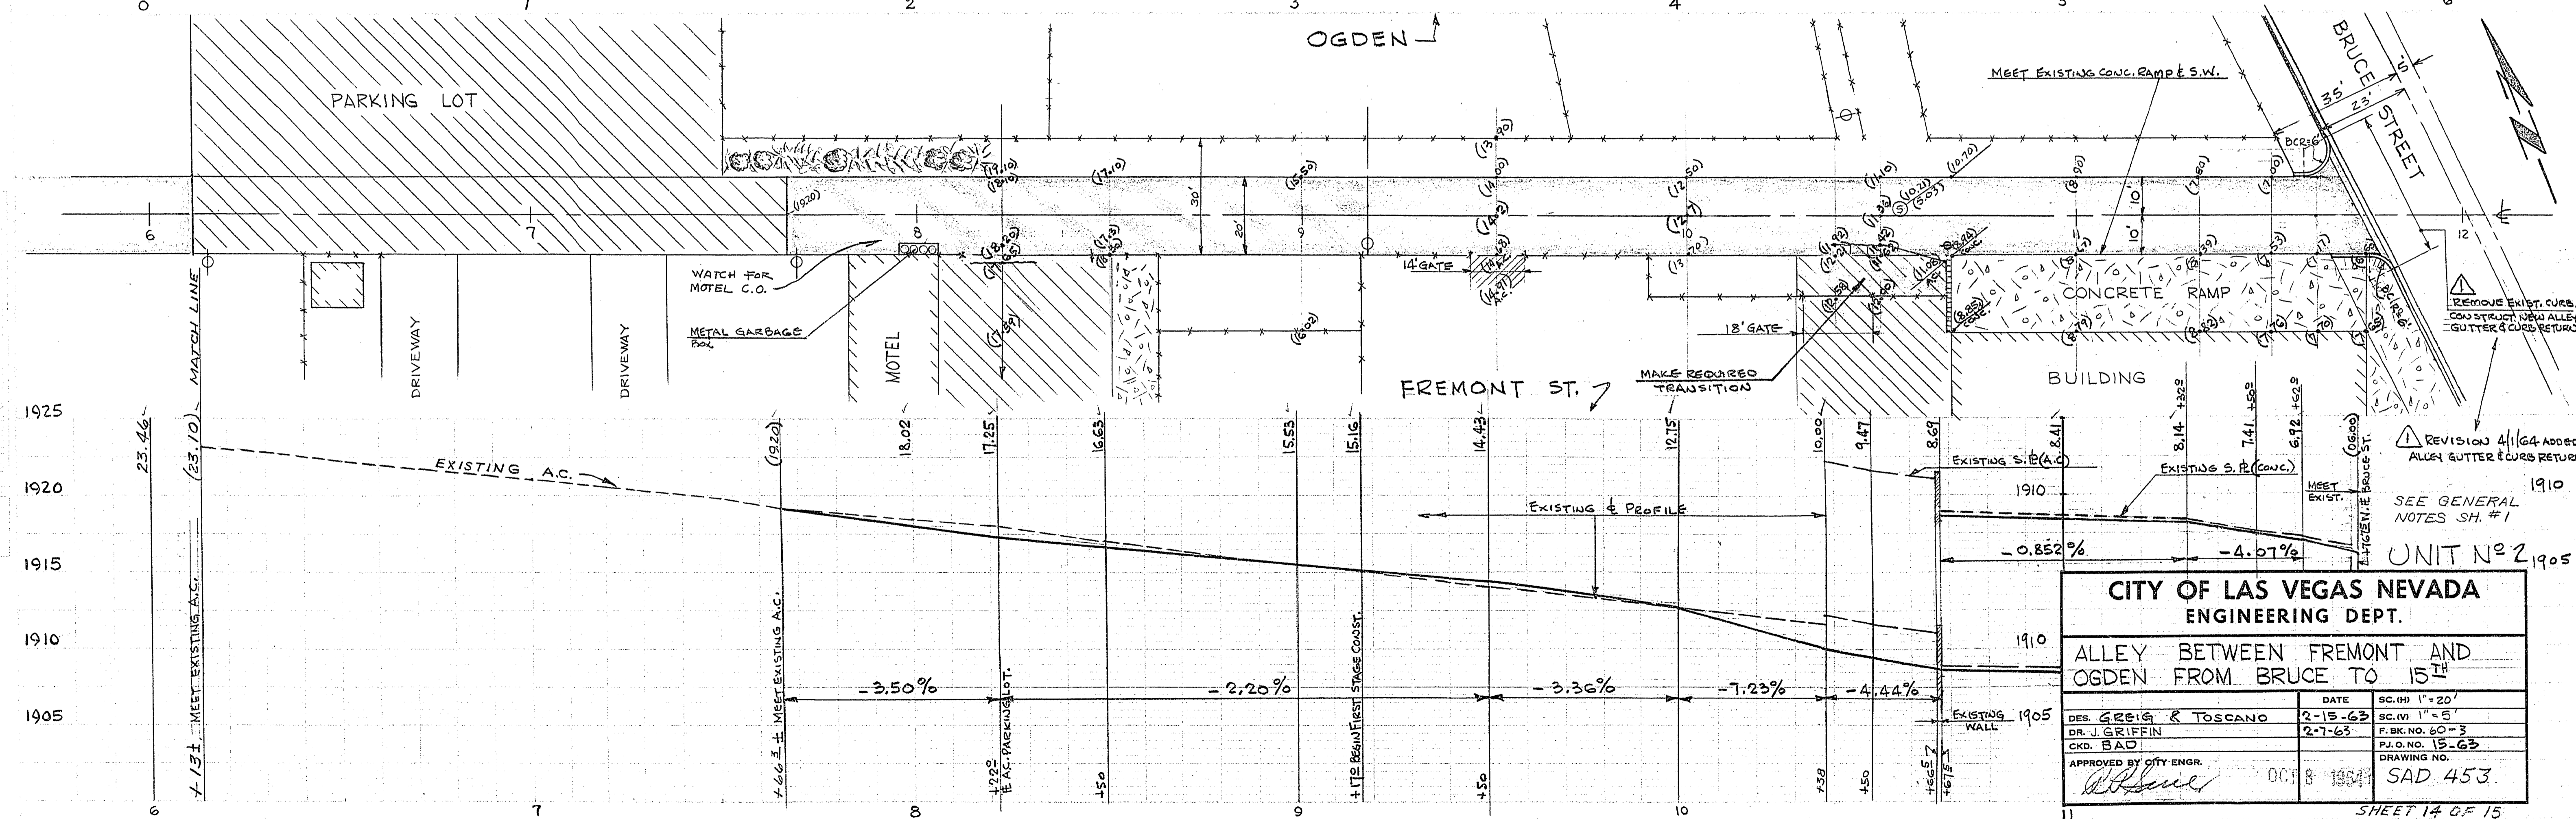


2-5-11

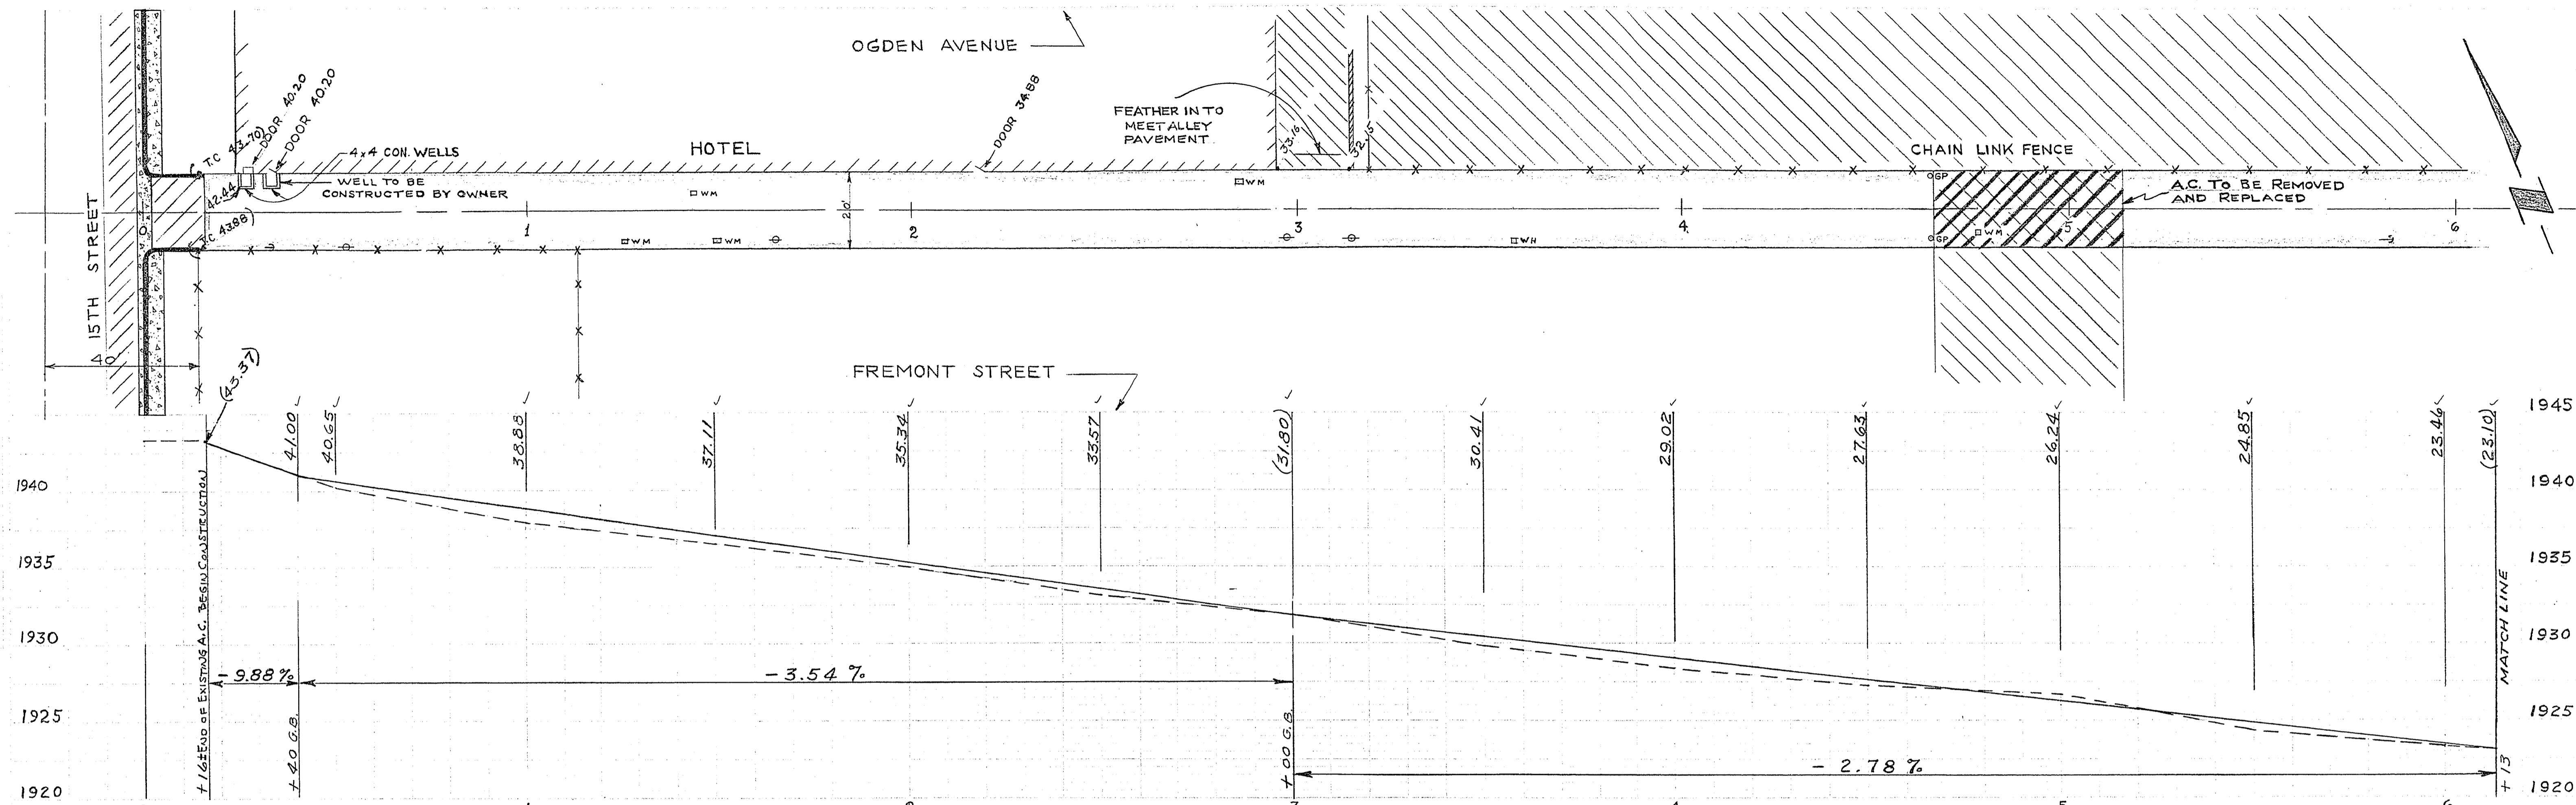

CITY OF LAS VEGAS NEVADA
ENGINEERING DEPT.

**ALLEY BETWEEN FREMONT AND
OGDEN FROM BRUCE TO 15TH**

DES. GREGG & TOSCANO	DATE 2-15-63	SC. 1/1" = 20'
DR. J. GRIFFIN	2-7-63	SC. 1/1" = 5'
CHKD. BAD		F. BK. NO. 60-3
		P.L.O. NO. 15-63
APPROVED BY CITY ENGR.		DRAWING NO. SAD 453

OCT 8 1964

SHEET 14 OF 15

108-V107

CONTRACT
DRAWING
OCT 8 1964