7-531

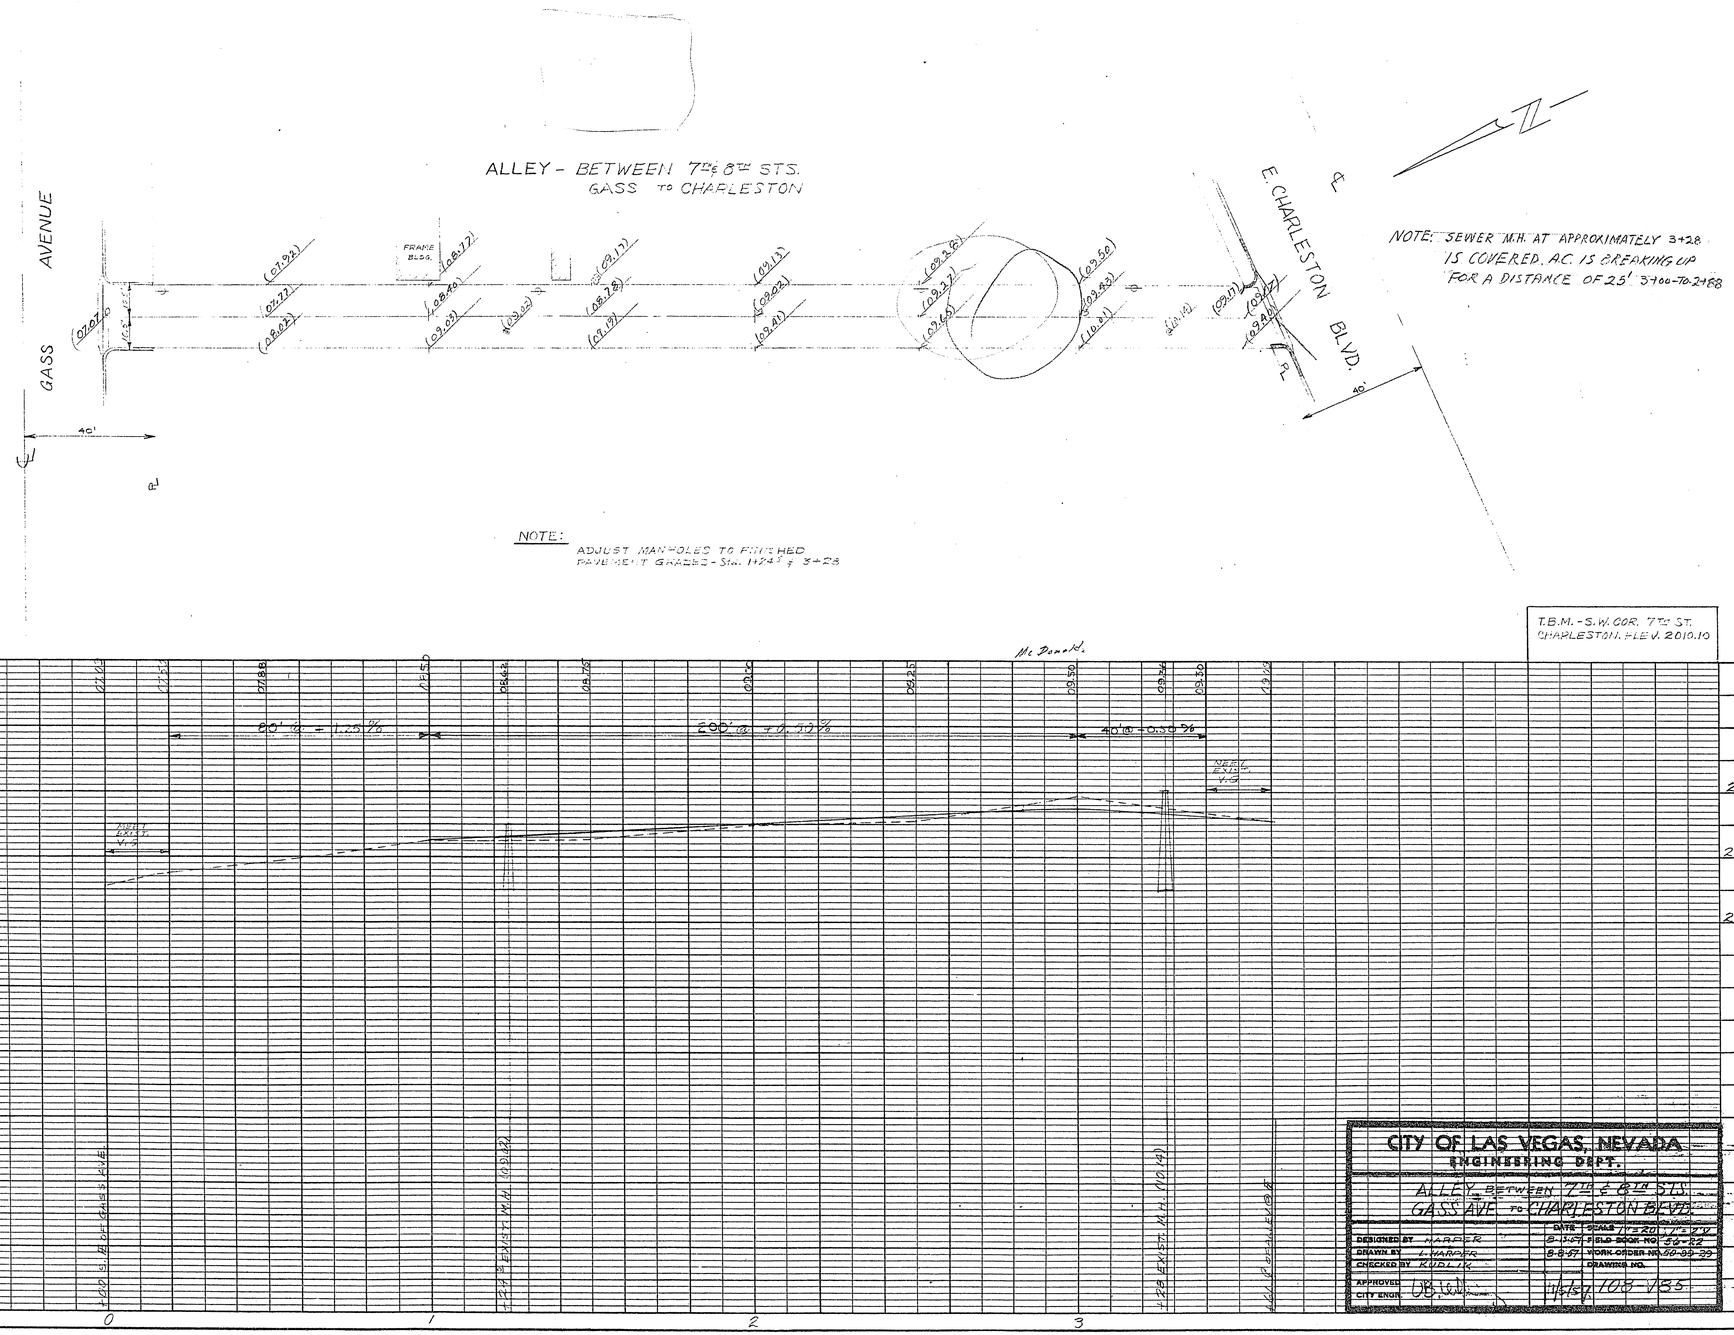

PLAN		BY	DATE
NOTE BOOK	SURVEYED		
	PLOTTED	S.H.R.	8-24-57
	ALIGNMENT CHECKED	HARPER	8-25-57
NO. 26-22	R.L. DIVISION ENGINEER		

PROFILE		BY	DATE
NOTE BOOK	SURVEYED		
	PLOTTED	S.H.R.	8-24-57
	GRADES CHECKED	HARPER	8-25-57
NO. 26-22	R.L. DIVISION ENGINEER		
	STRUCTURE NOTATIONS CHK'D		

CITY OF LAS VEGAS, NEVADA
ENGINEERING DEPT.

ALLEY BETWEEN 7TH & 8TH STS.
GASS AVE TO CHARLESTON BLVD.

		DATE	SCALE 1"=20' V; 1"=10' H
DESIGNED BY	HARPER	8-3-57	FIELD BOOK NO. 26-22
DRAWN BY	L. HARPER	8-8-57	WORK ORDER NO. 60-99-39
CHECKED BY	KUDLIK		DRAWING NO.
APPROVED			
CITY ENGR.		11/15/57	108-155

PLATE 1-PLAN-PROFILE-F.A.S.
CLEARPRINT PAPER CO., S.F. CAL.
No. 1000H-1