



2-5-58

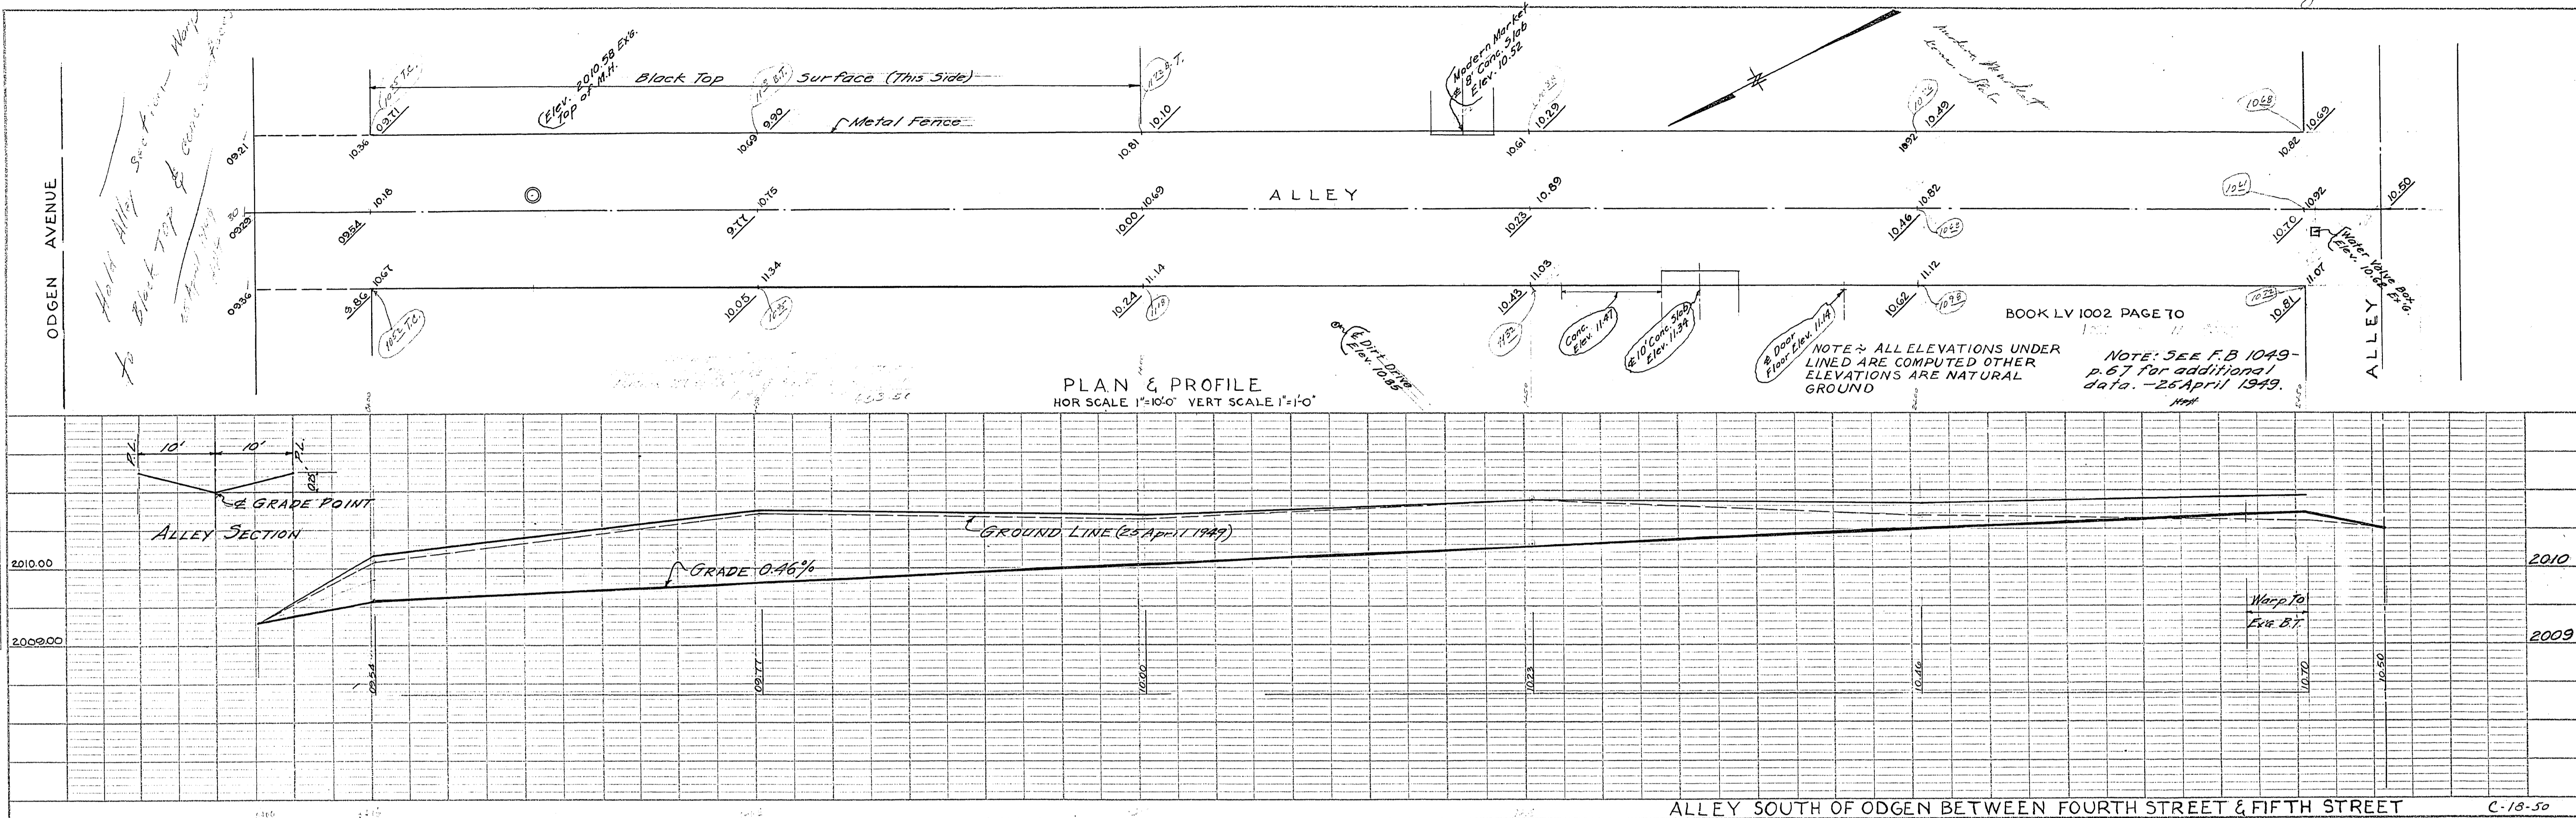

PLAN	SCHEMATIC	DATE	
NOTE BOOK	ALIGNED CHECKED		
NO.	AT. OF WAY CHECKED		

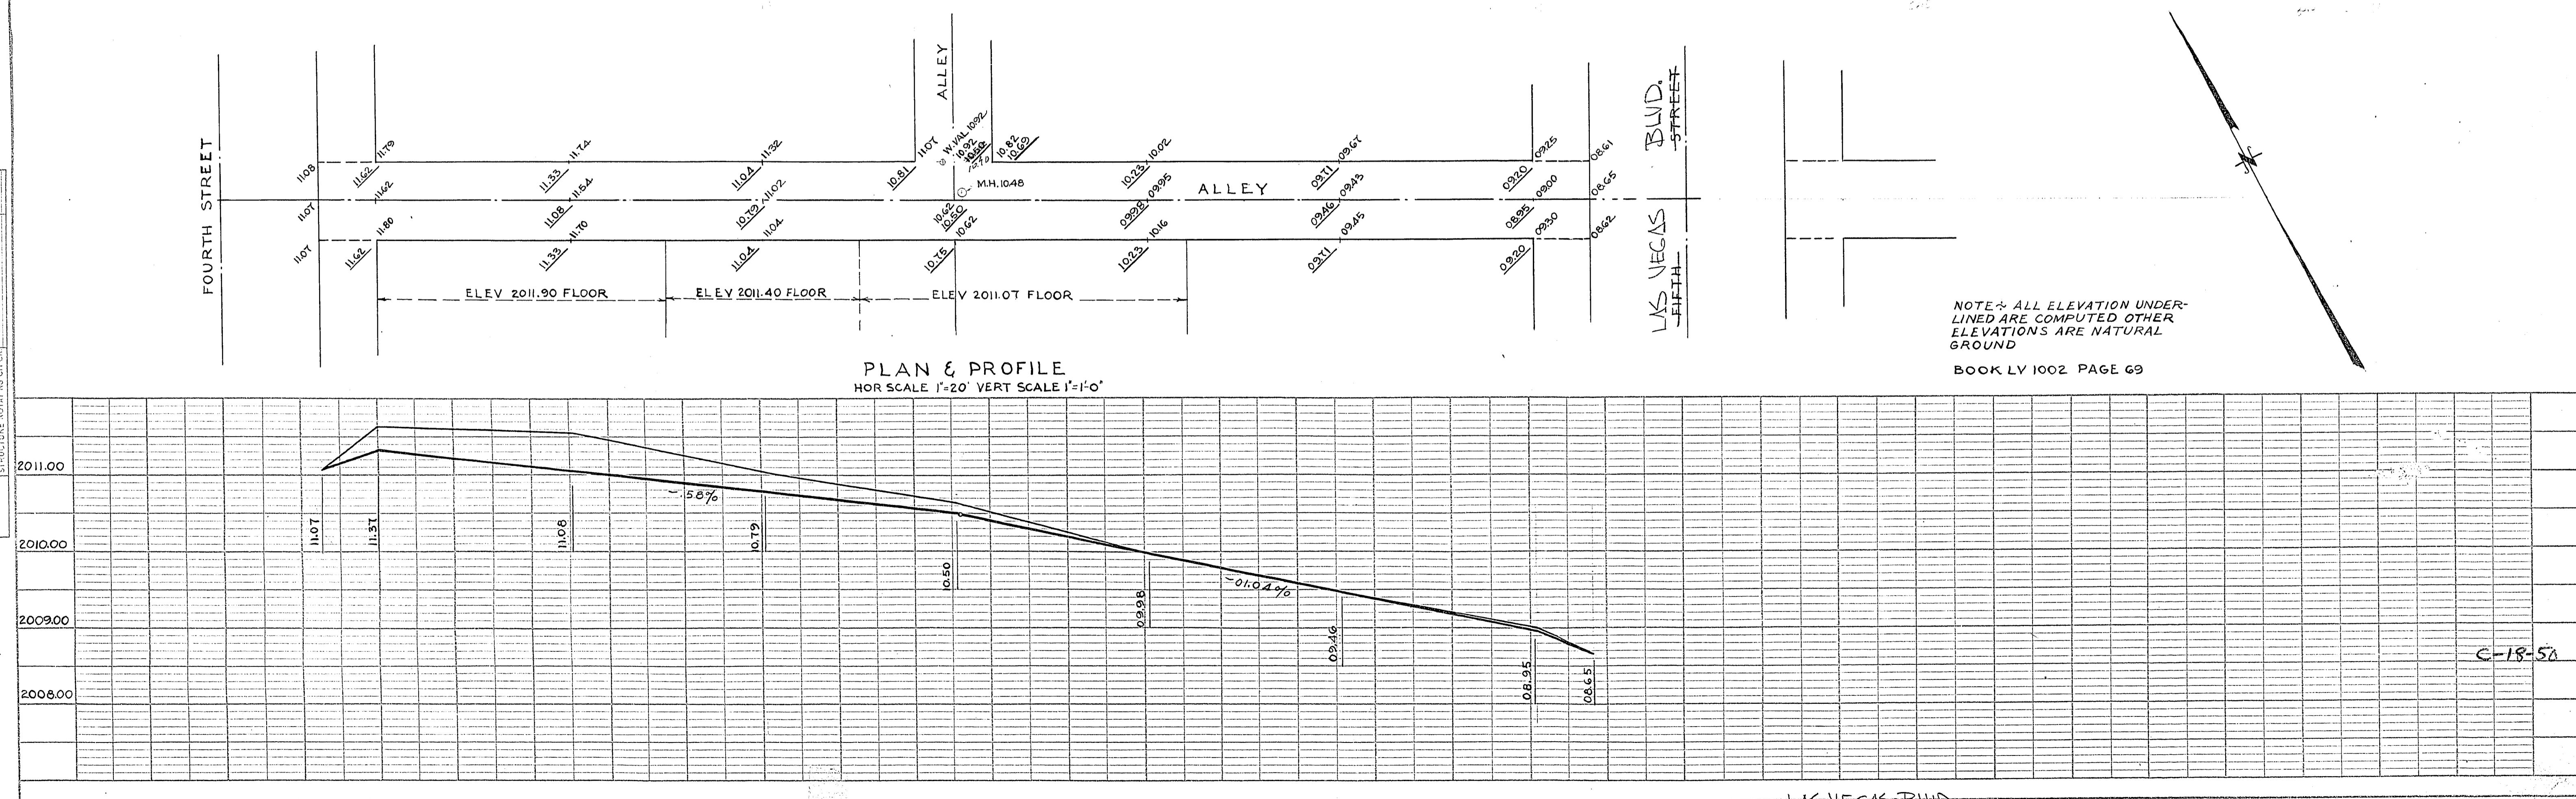

PROFILE	ENGINEER	DATE	
NOTE BOOK	CHECKED		
NO.	STRUCTURE NOTATION CHECKED		