

2-5-14

PLAN



DATE: _____

SCALE: _____

PROJECT: _____

NOTE: BOOK _____

FIG. _____

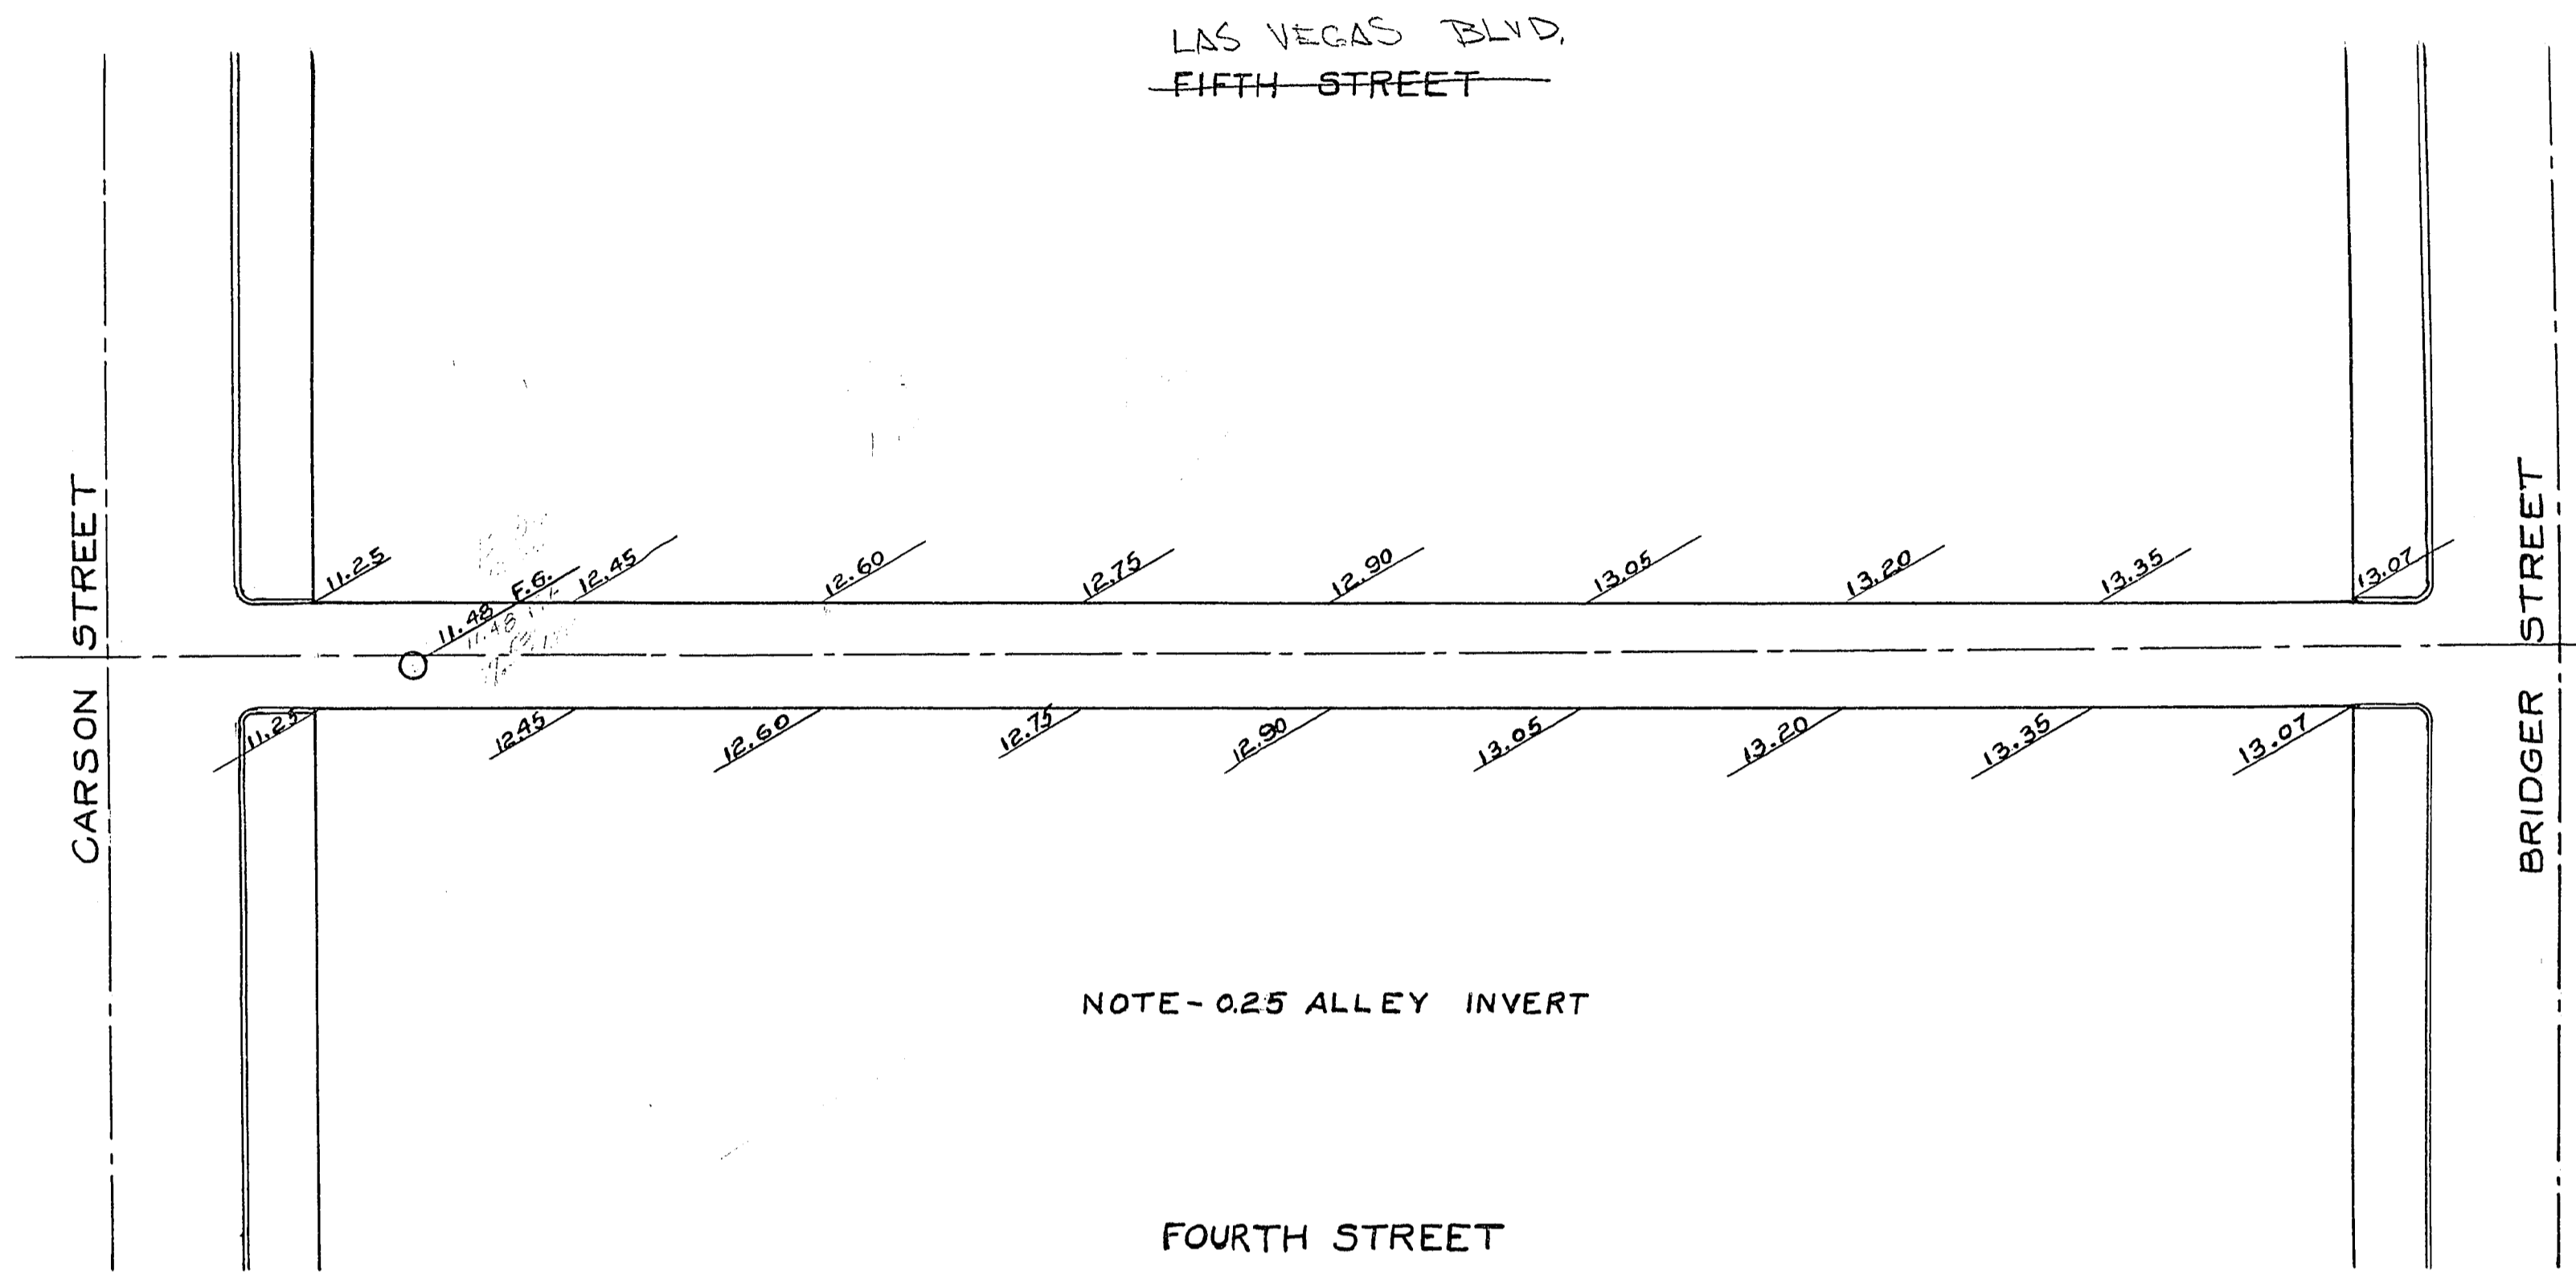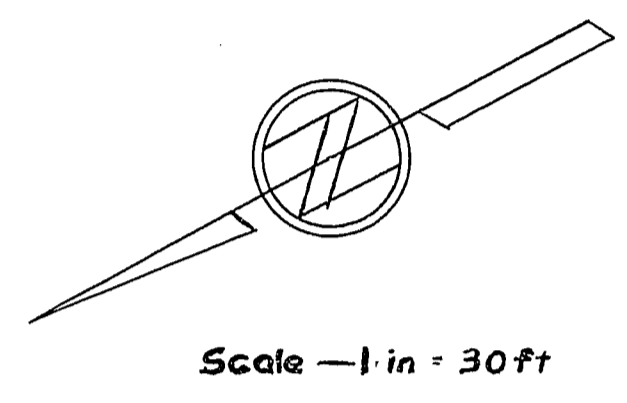

FB. 1075 P. 24
 B.M. United FR. No. 51d
 Carson bet 4th & 5th
 Elevation 2013.61

PROFILE


DATE: _____

SCALE: _____

PROJECT: _____

NOTE: BOOK _____

FIG. _____

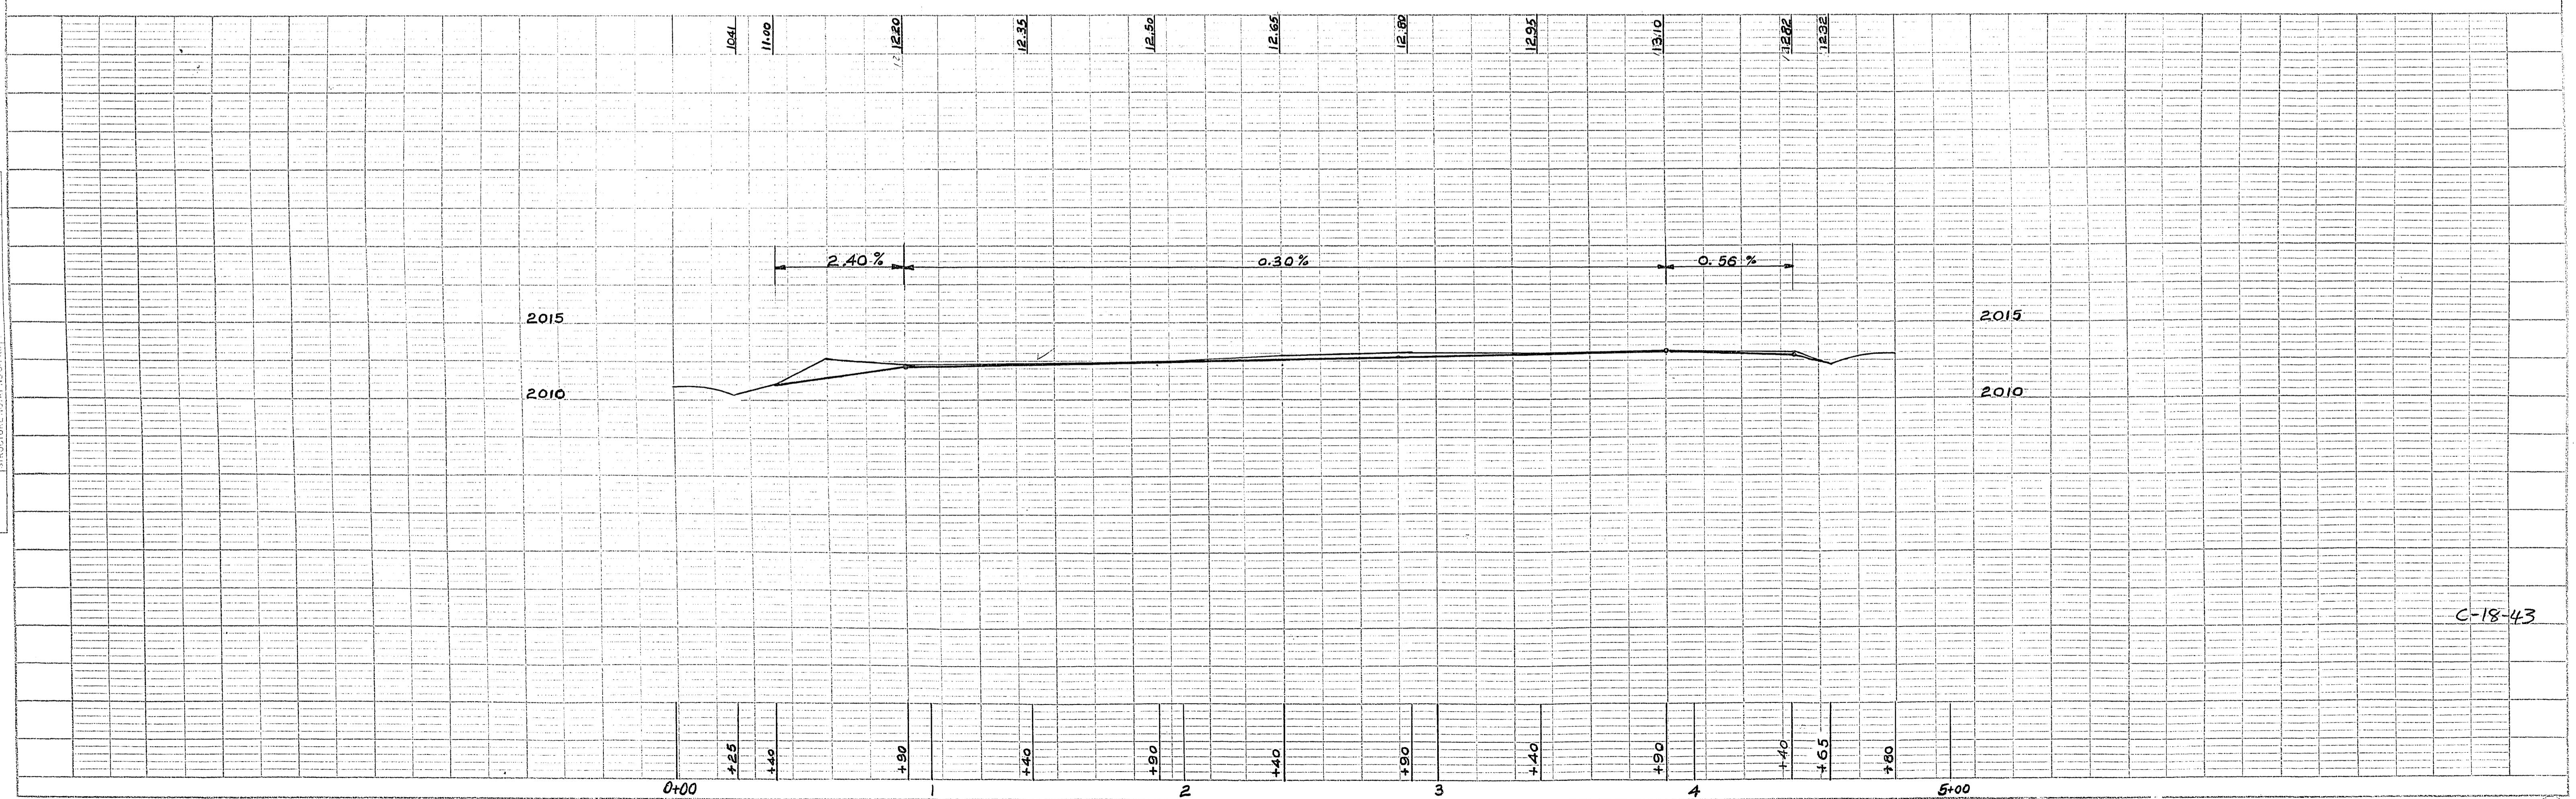

C-18-43

ALLEY Between 4th & 5th - Carson to Bridger

108-V33

PLATE 111-40, 111-41, 111-42, 111-99, 111-100