2-5-95

'A' STREET

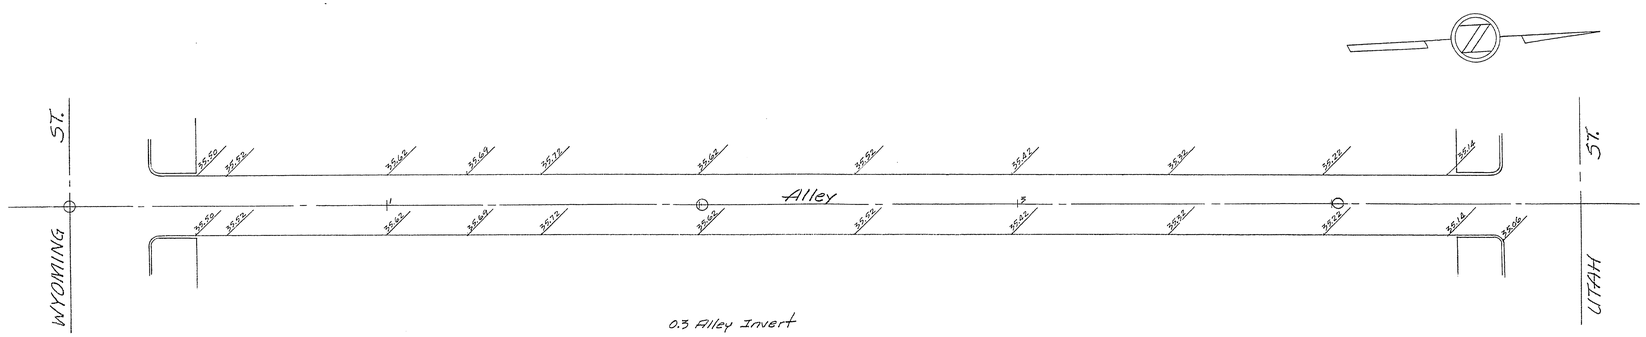

SOUTH MAIN STREET

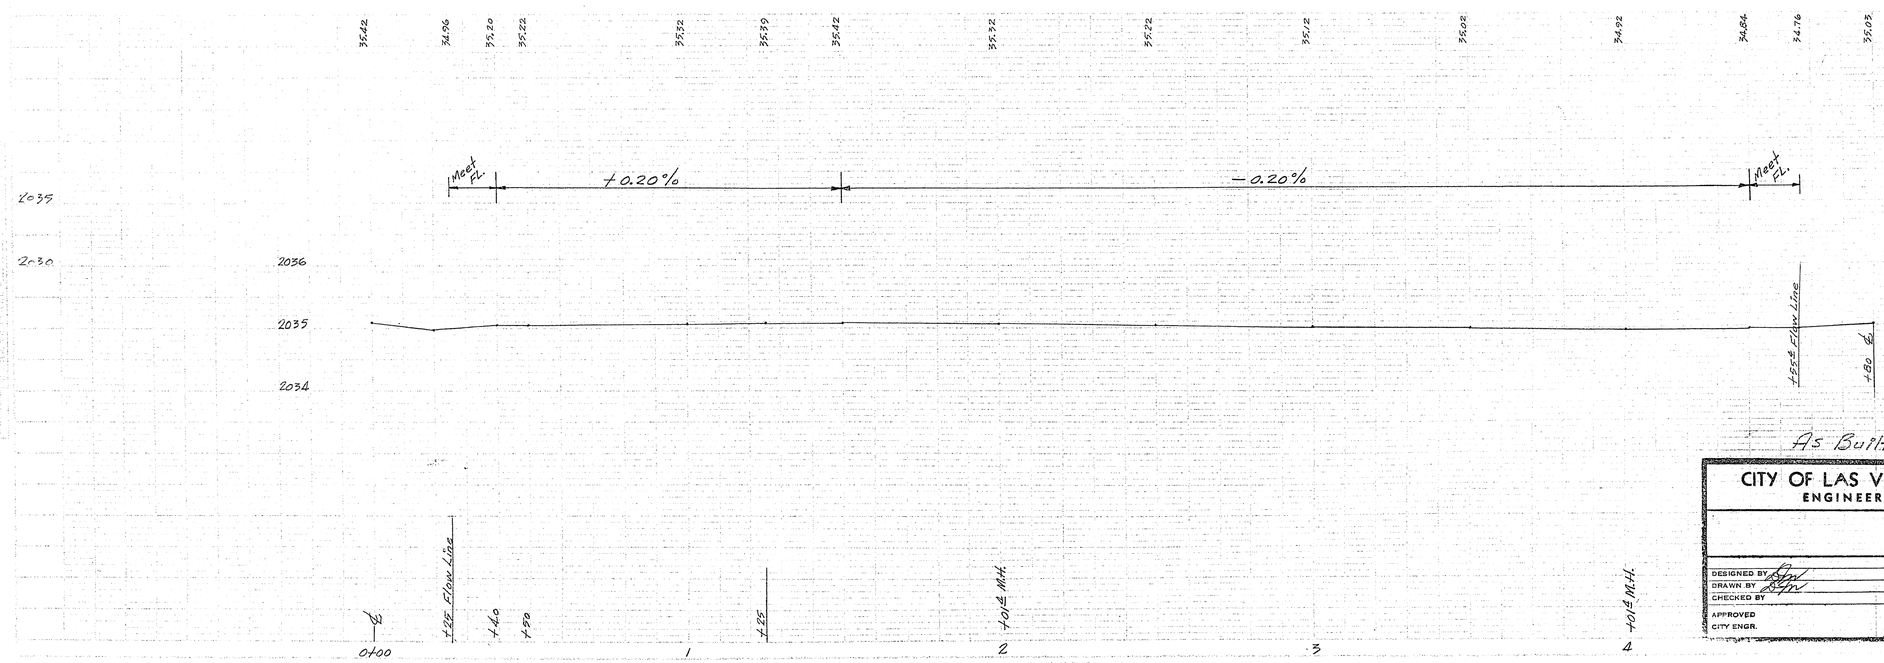

As Built

CITY OF LAS VEGAS, NEVADA ENGINEERING DEPT.		
	DATE	SCALE 1" = 20'
DESIGNED BY	12-1-55	FIELD BOOK NO. 100-17
DRAWN BY	12-5-55	WORK ORDER NO.
CHECKED BY		DRAWING NO.
APPROVED CITY ENGR.		

108-V28