
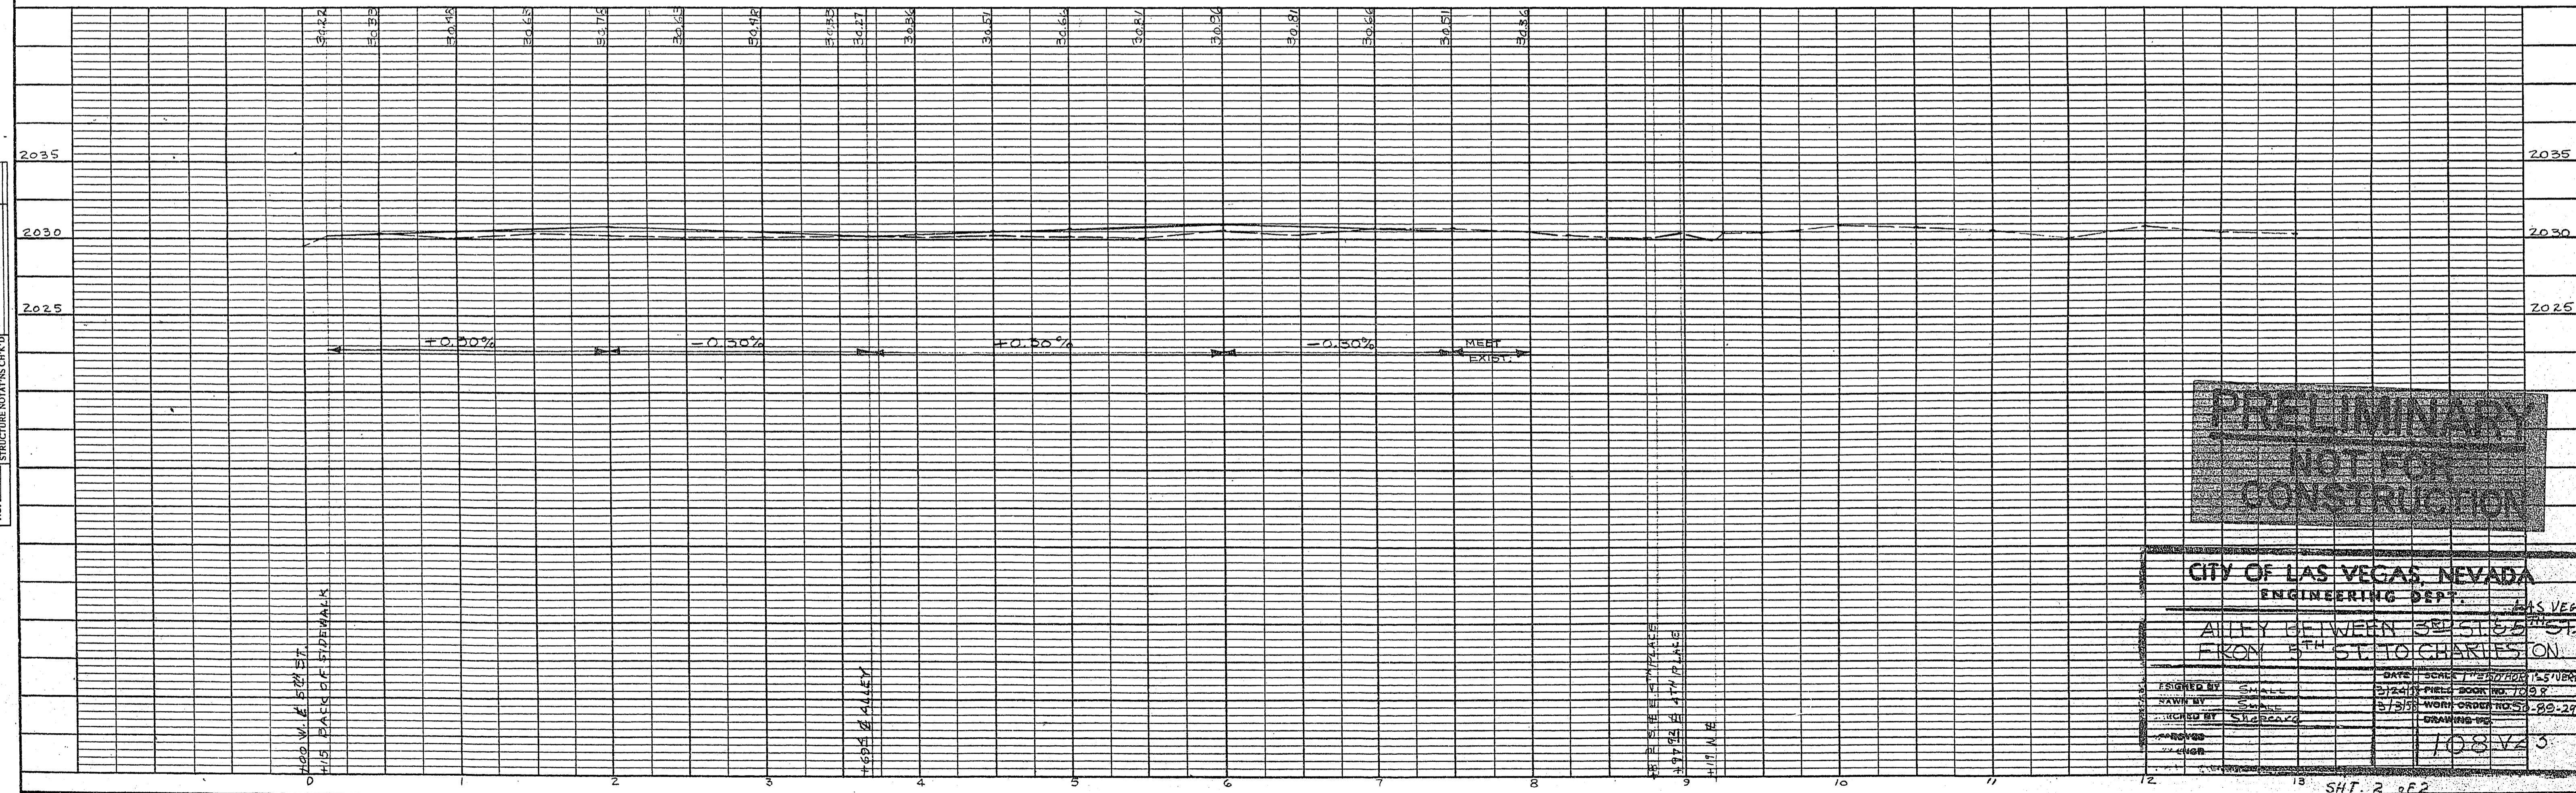


25-101

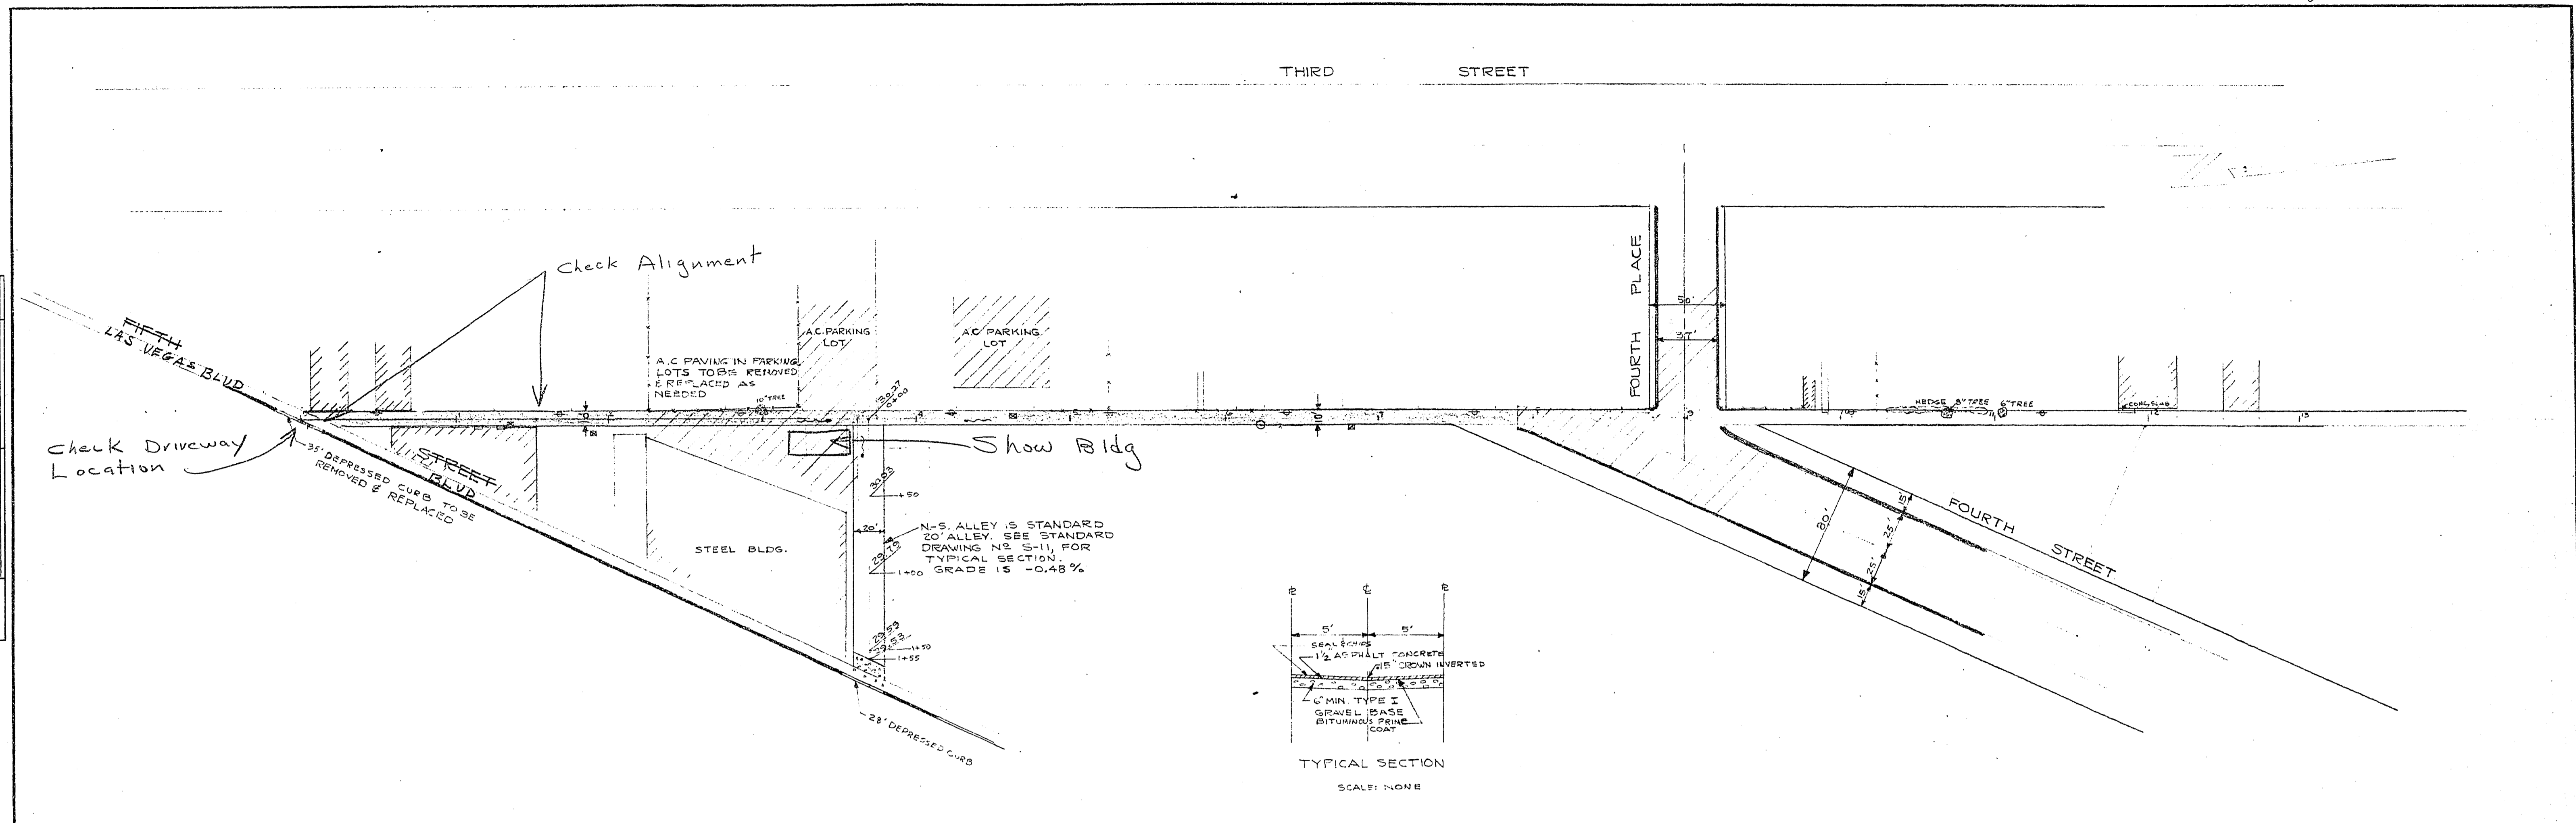

DATE: 12/22/78
 BY: S.MALL
 CHECKED: S.MALL
 NO. 072

DATE: 12/22/78
 BY: S.MALL
 CHECKED: S.MALL
 NO. 072

PRELIMINARY
NOT FOR
CONSTRUCTION

CITY OF LAS VEGAS, NEVADA
 ENGINEERING DEPT.

ALLEY BETWEEN 3RD ST & 4TH ST
 FROM 5TH ST TO CHARLES ON

DATE: 12/22/78
 DRAWN BY: S.MALL
 CHECKED BY: S.MALL
 NO. 072

108143