
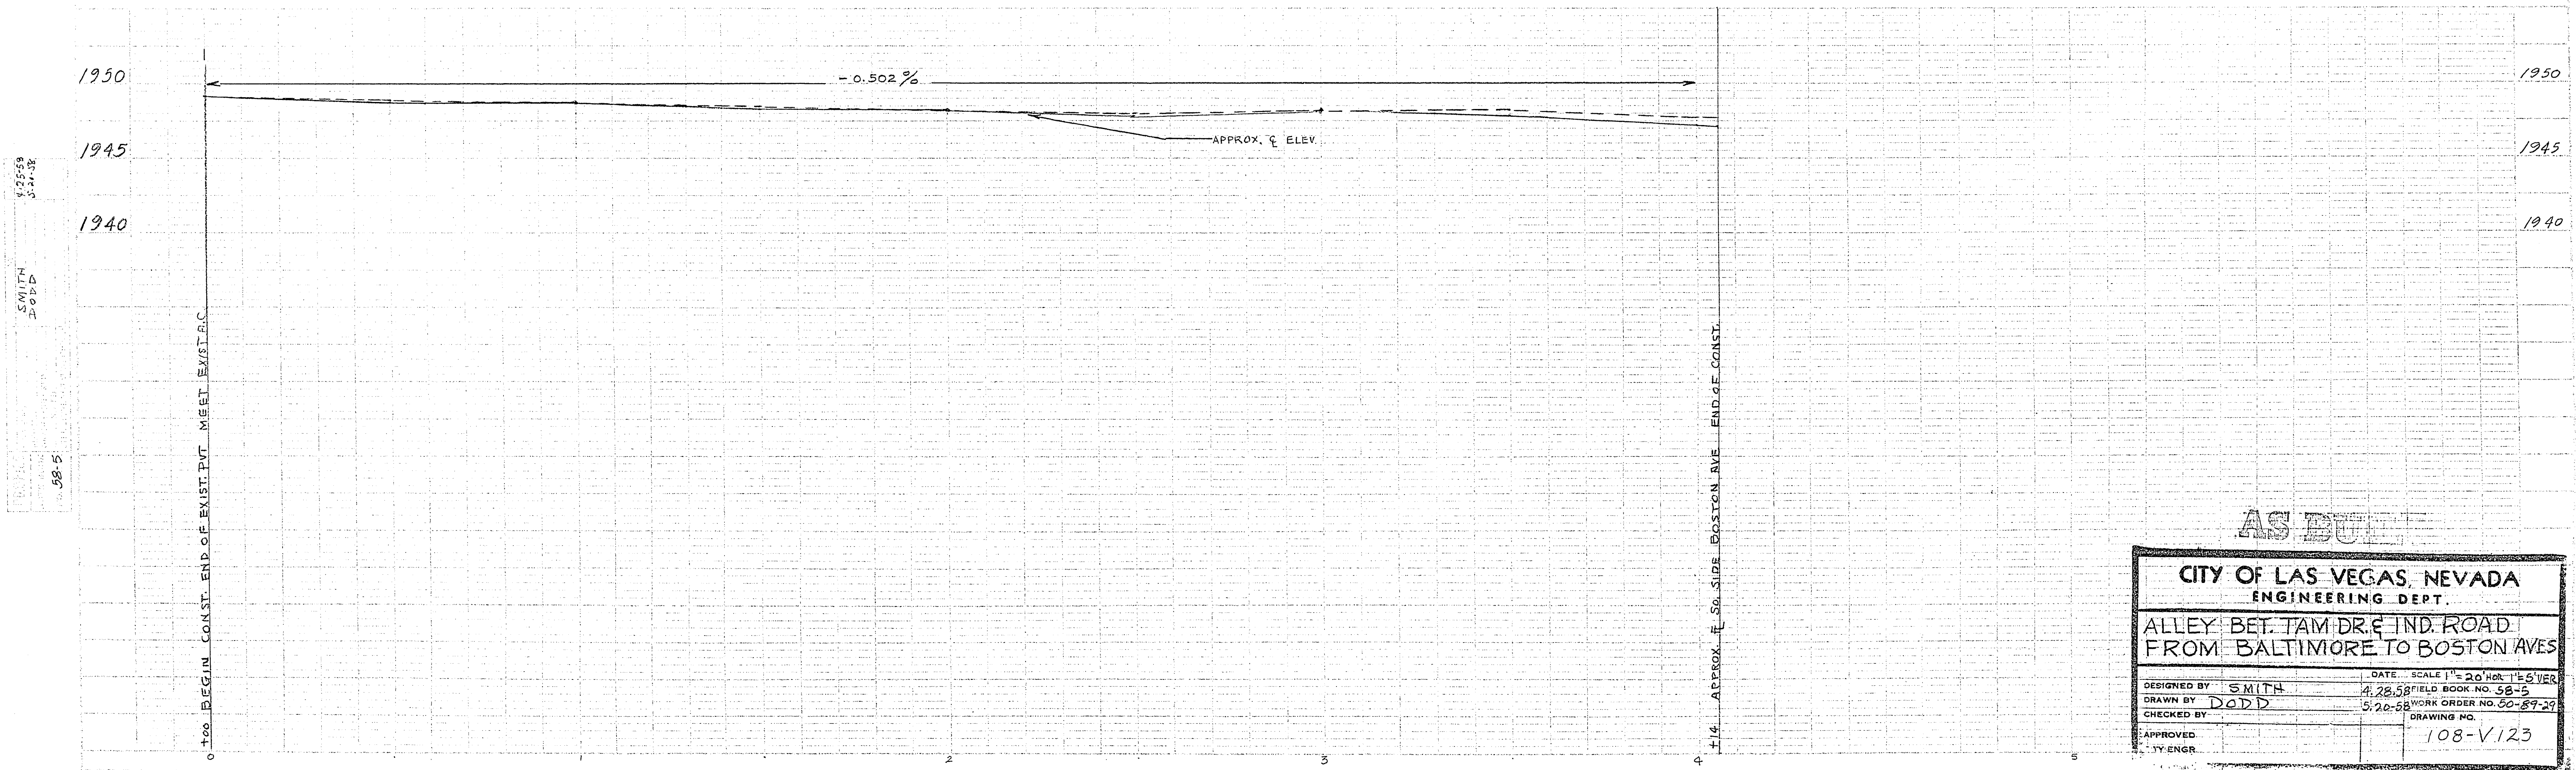
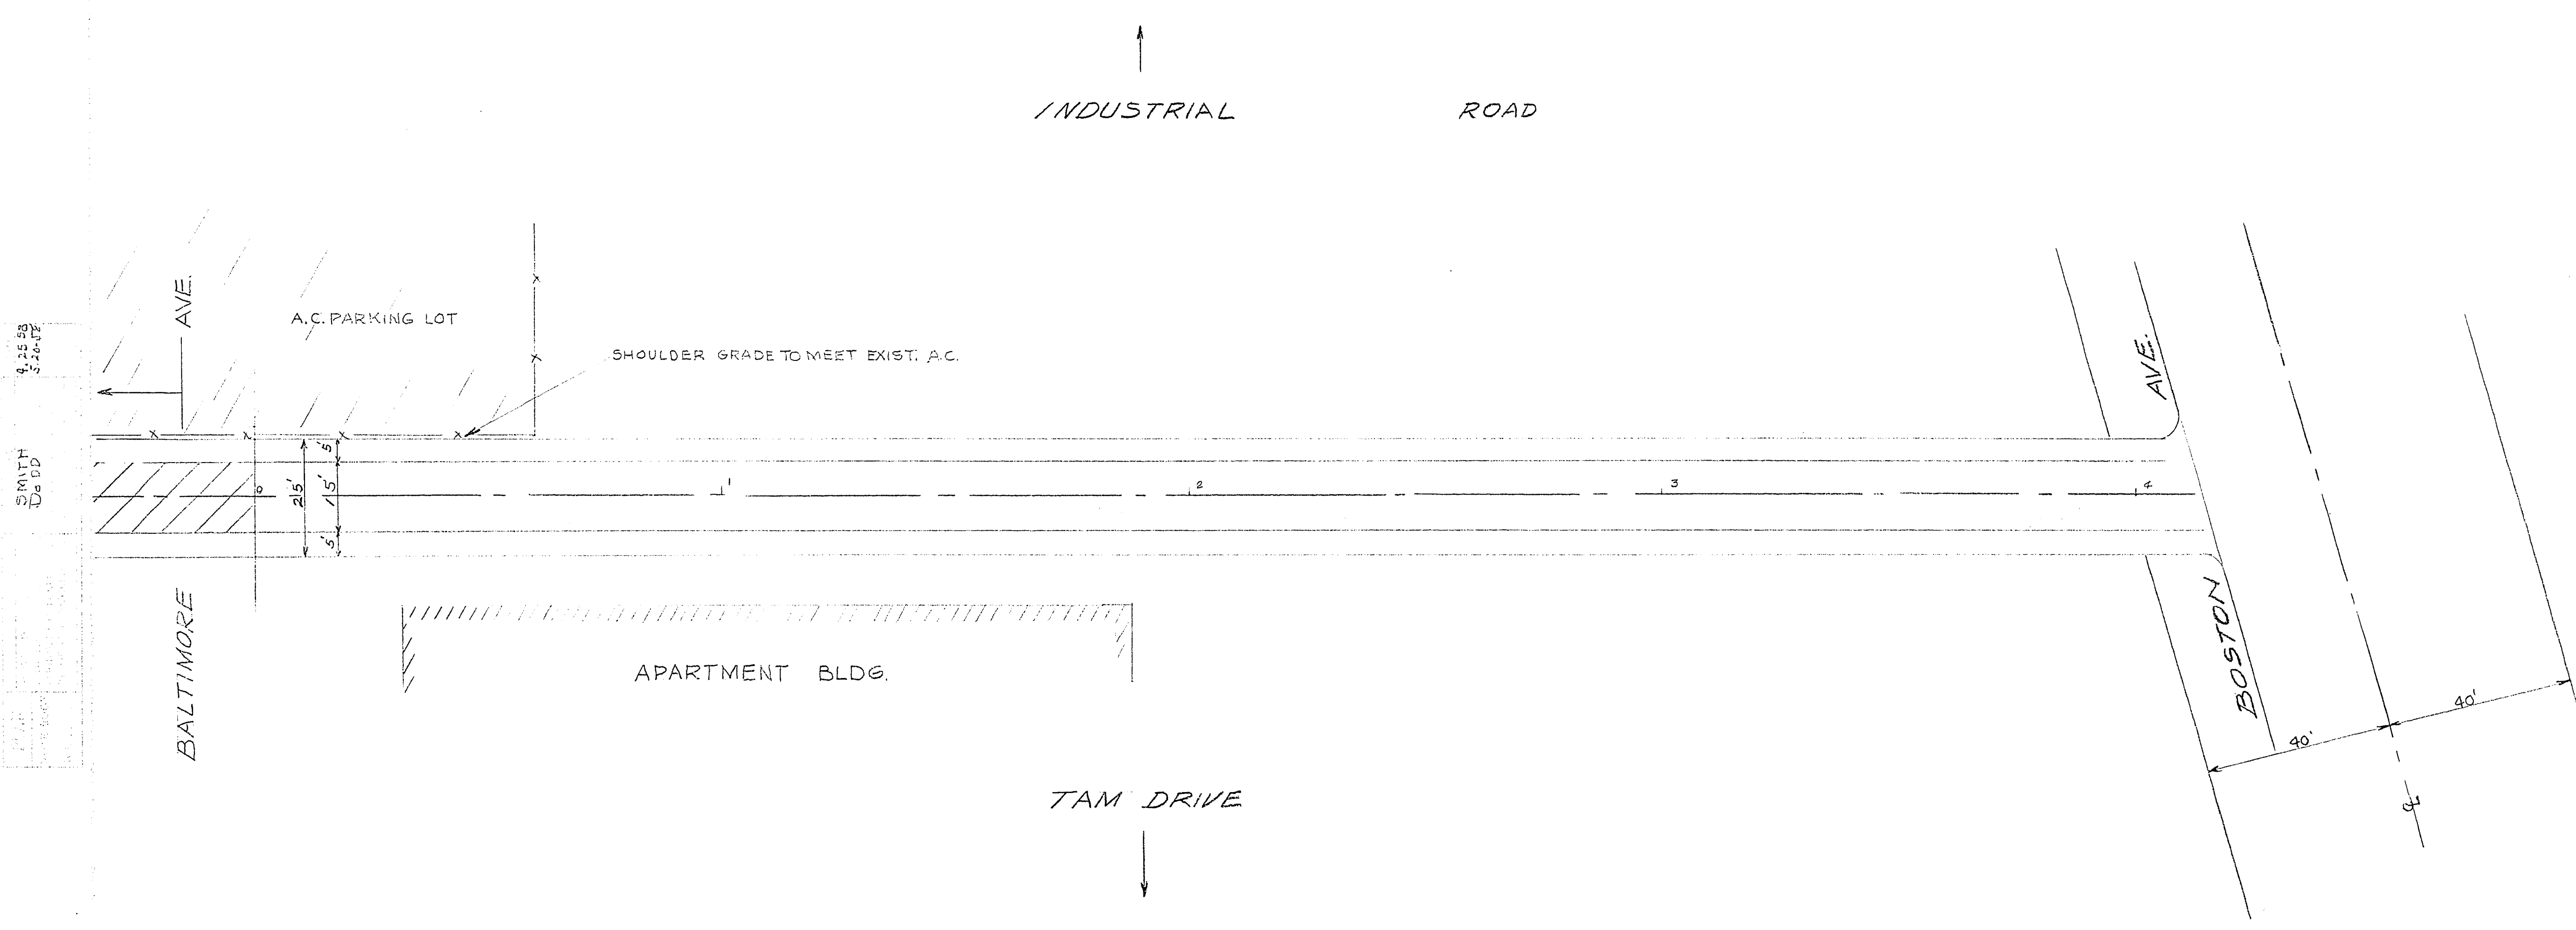


3510

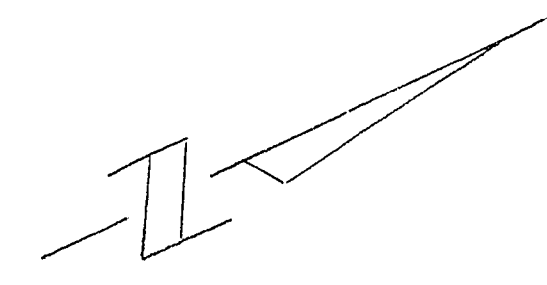

DESIGNED BY SMITH
DRAWN BY DADD
CHECKED BY
APPROVED BY
DATE 4-28-58
SCALE 1" = 20' HOR. 1" = 5' VER.
FIELD BOOK NO. 58-5
WORK ORDER NO. 60-59-29
DRAWING NO. 108-V123

CITY OF LAS VEGAS, NEVADA ENGINEERING DEPT.	
ALLEY BET. TAM DRIVE IND. ROAD FROM BALTIMORE TO BOSTON AVES	
DESIGNED BY SMITH	DATE 4-28-58
DRAWN BY DADD	SCALE 1" = 20' HOR. 1" = 5' VER.
CHECKED BY	FIELD BOOK NO. 58-5
APPROVED BY	WORK ORDER NO. 60-59-29
TY-ENGR	DRAWING NO. 108-V123