


Charleston Heights Tract No. 5

In the City of Las Vegas, Nevada

BEING A SUBDIVISION OF A PORTION OF THE N $\frac{1}{2}$ OF THE S.W. $\frac{1}{4}$
OF SECTION 36, T.20 S., R. 60 E., M.D.B. & M.

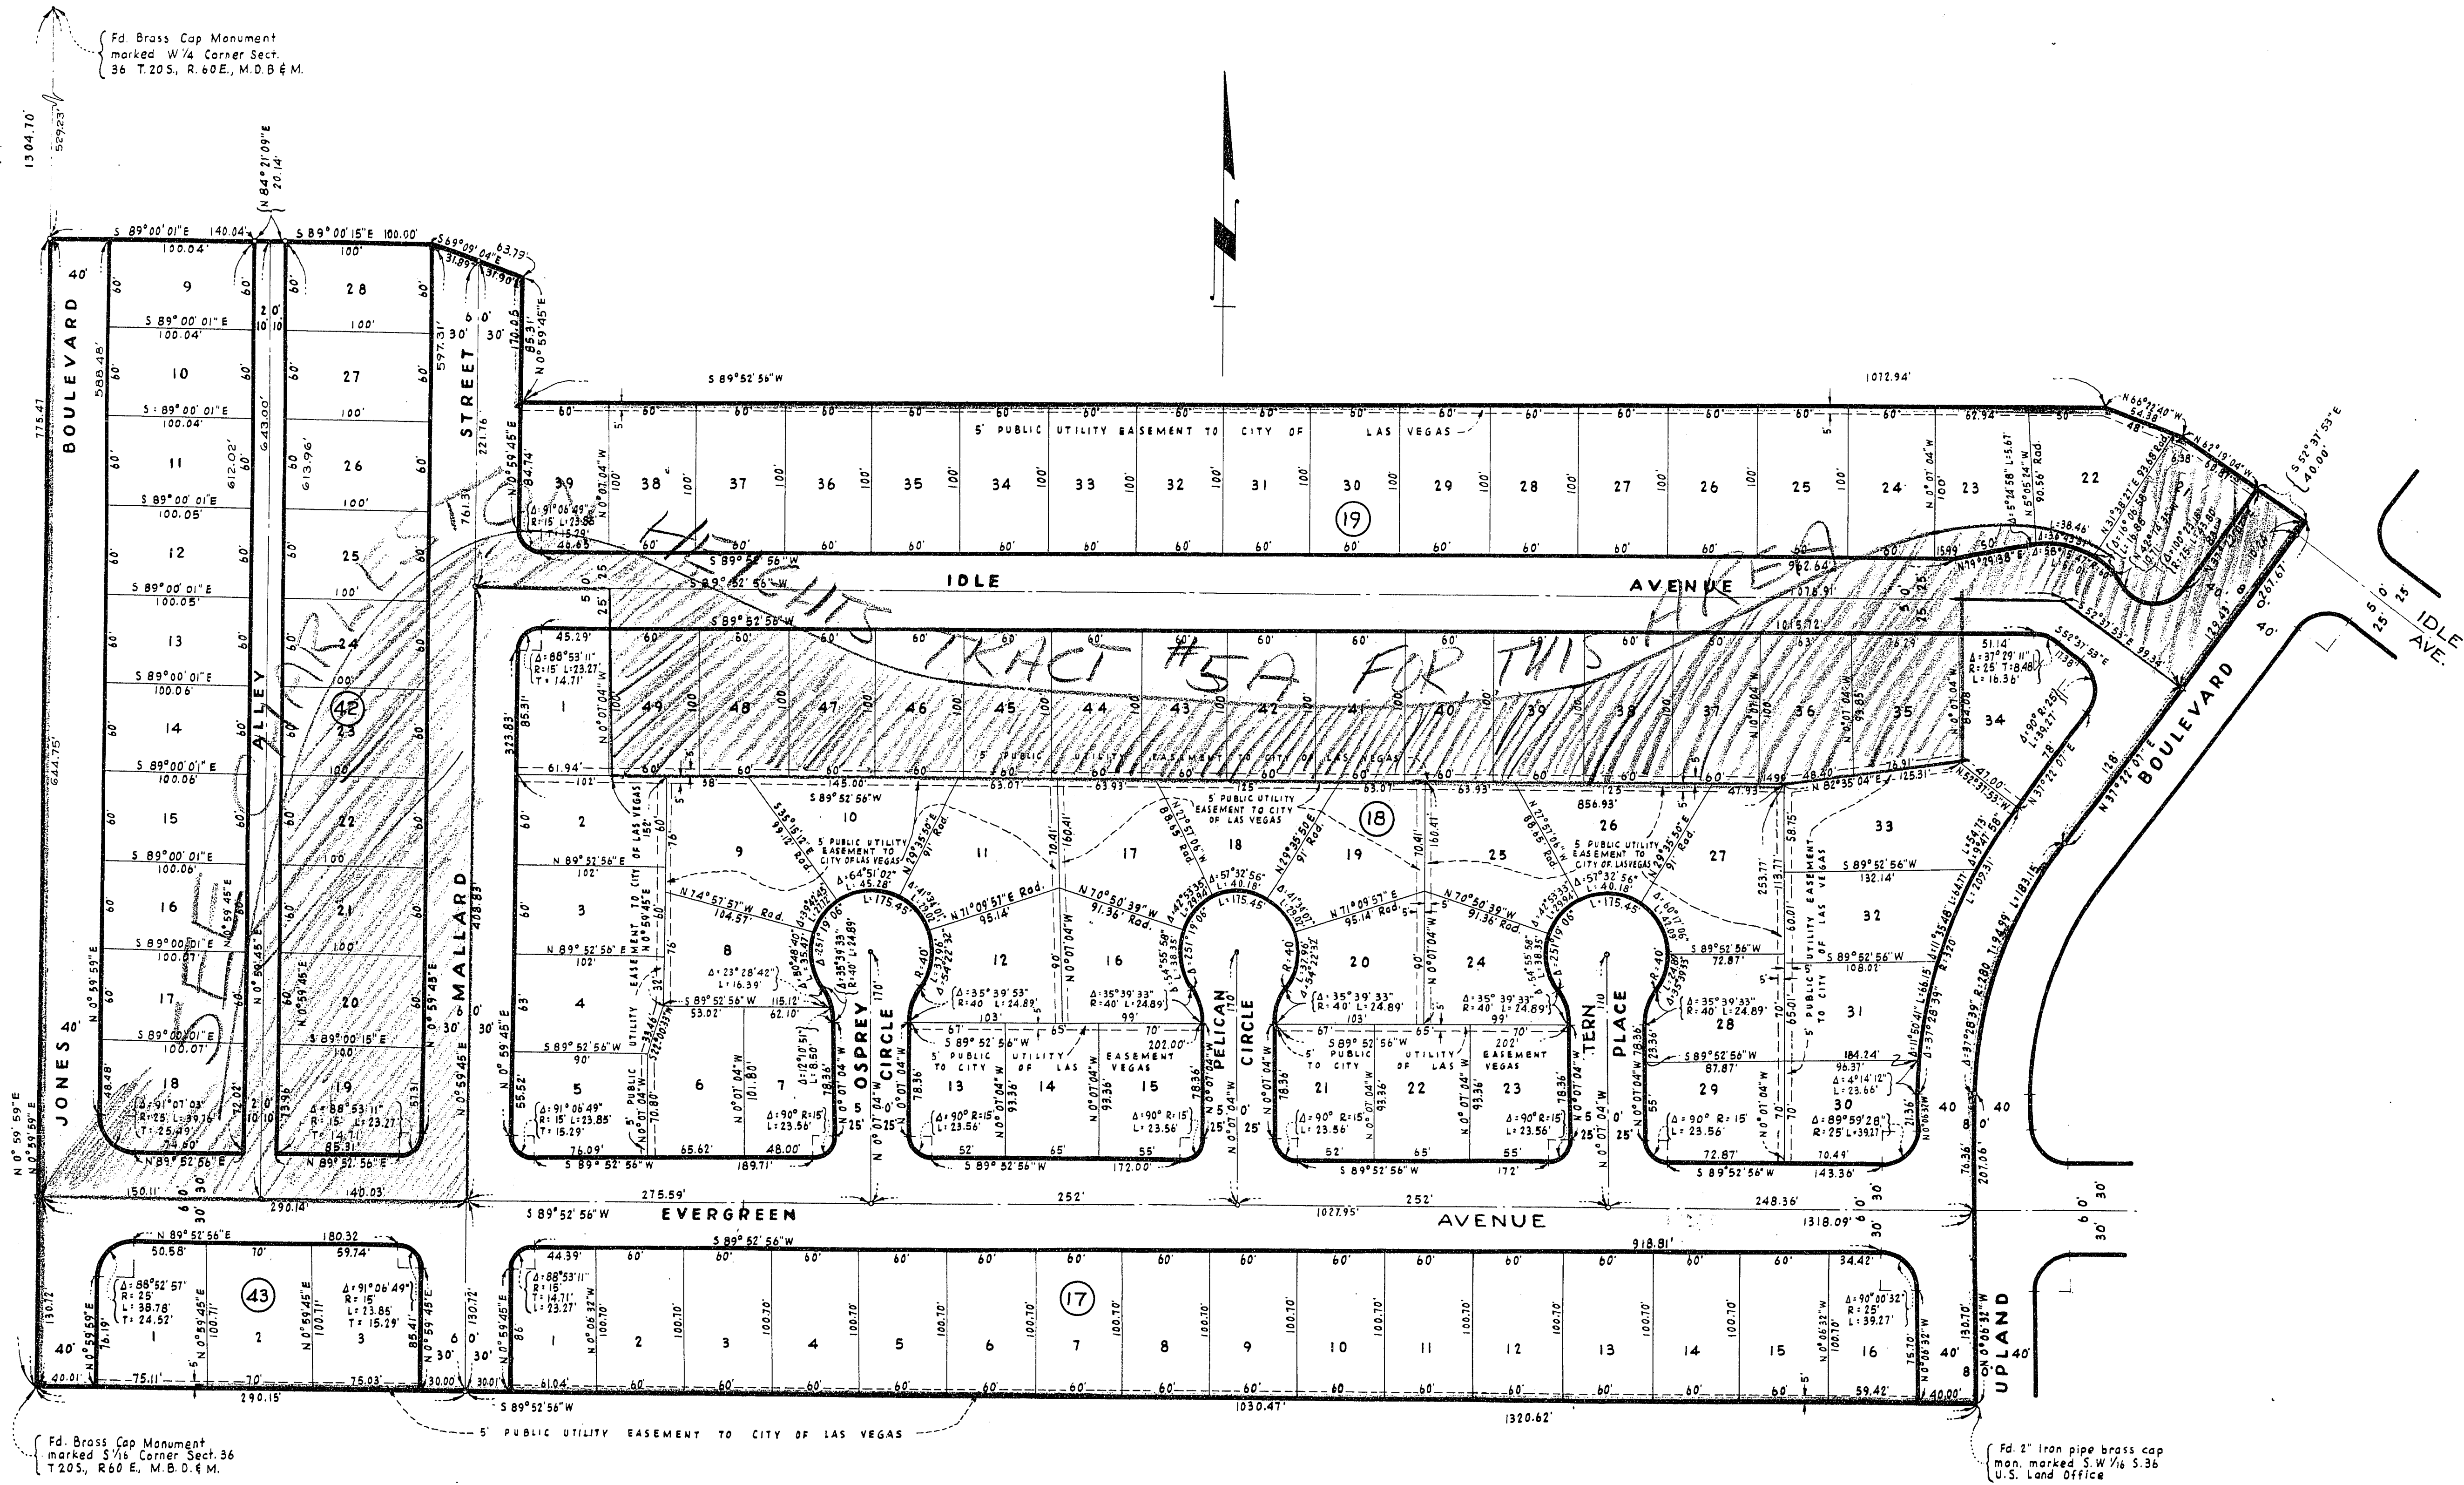

C-22-47A

Charleston Heights Tract No. 5
1040-5
1040-5