

A PORTION OF THE E $\frac{1}{2}$, W $\frac{1}{2}$, SE $\frac{1}{4}$ OF SECTION 34, T20S, R60E, M.D.M., NEVADA
CITY OF LAS VEGAS COUNTY OF CLARK STATE OF NEVADA

A PORTION OF THE E $\frac{1}{2}$, W $\frac{1}{2}$, SE $\frac{1}{4}$ OF SECTION 34, T20S, R20E, M.D.M., NEVADA
CITY OF LAS VEGAS COUNTY OF CLARK STATE OF NEVADA

SUPERIMPOSED ON RECORD
 DOCUMENT:
 LINES ~~1-14~~
 FIGURES *50.00
 PARCEL DESIGNATION * ()
 PARCEL A INCLUDES:
 LOT 17 OF BLK. 2
 LOTS 13-17, INCL. OF BLK 3
 LOT 10 OF BLK. 4
 LOTS 1-14, INCL. OF BLK 5
 LOTS 1-7, INCL. OF BLK. 7
 28 LOTS & 6.428 ACRES
 PARCEL B INCLUDES:
 REMAINING LOTS
 49 LOTS & 10.14 ACRES.

SURVEYOR'S CERTIFICATE

Now I declare and fully certify that I am Surveyor of the State of Nevada, believing verily that this is a true and correct copy of the land surveyed under my direct supervision at the instance of the United States, a New Mexico Cession, and said land includes lots, blocks, streets and easements as shown hereon, that said lots, blocks, streets and easements are situated wholly within a portion of 21 feet to the E 1/4 corner, said point being the SE corner of Charleston Rainbow Unit 1 as shown by record in the index to the County Recorder's Register Book 10 of - 1474 Clark County Nevada 1912 Records, thence N 60° 38' 55" W along the East line of Charleston Rainbow Unit 1 a distance of 155.08 feet to the TRUE POINT OF BEGINNING, thence along the North line of said Charleston Rainbow Unit 1 as shown S 89° 18' W a distance of 330.20 feet, thence S 60° 38' 55" a distance of 155.1 feet, thence N 89° 30' 18" W a distance of 154.20 feet, thence N 60° 38' 55" a distance of 126.11 feet, thence S 89° 38' 16" W a distance of 125.18 feet, thence bearing from said North line of Charleston Rainbow Unit 1 as shown N 17° 16' a distance of 1119.15 feet to a point on the North line of the S 1/4 of Section 34, thence along said North line of the S 1/4 of Section 34 a distance of 65.30 feet, to the E 1/4 C.C. corner, thence S 60° 38' 55" a distance of 155.1 feet to the TRUE POINT OF BEGINNING, that this survey was completed on April 12, 1922.

Kay L Adams
Registered Land Surveyor
Nevada Certificate N° 2030
Kay - Adams

CITY ENGINEER'S CERTIFICATE

administered by the Department of Planning and Zoning are fully complied with and that I am satisfied that this map is technically correct.

Dated this 6th day of April, 1966

R. P. Sauer
R. P. SAUER - CITY ENGINEER - R. P. E. NO. 396

OWNER'S CERTIFICATE AND DEDICATION



Dated this 12 day of April 1966

R.B. Cline, Vice President,
Sprout Homes, Inc.

ACKNOWLEDGEMENT

On the 19 day of April, 1966, personally appeared before me, Merlin Eugene Vance Notary Public in and for said County of Santa Clara, California, to me to be Vice President of the Corporation that executed the foregoing instrument, and upon oath he deposed that he is the officer of said Corporation and that the seal affixed to said instrument is the Corporation seal of said Corporation, that the signature to said instrument was made by the officer of said Corporation as indicated on the said signature, and that said Corporation executed the said instrument freely and voluntarily and for the uses and purposes therein mentioned.

Notary Public in and for said County and State
My commission expires: 5-14-69

LEGEND

- CC-007
- case no 72 # tapped R.L. 5 2200
man round
lot number
block number
- 25 front yard setback line
15 side yard setback line
5 public utility easement
- 3' terrace easement

BASIS OF BEARINGS

N 20° 38' 55" W. being the east line of Charleston Rainbow Unit 1 per Book 10 Page 61 of plats, Clark County, Nevada, Official Records

APPROVED.

In conformity with the tentative map, approved this 14th day of Sept 1962, by the City Planning Commission, City of Las Vegas, County of Clark, State of Nevada.

APPROVED:

Approved and accepted this 6th day of April, 1969, by the Board
of Commissioners of the City of Las Vegas, County of Clark, State of Nevada.

Attest _____
EDWINA COLE CITY CLERK

Divided into Units 2-A & 2-B


Initial

M. City

NO. 571390
Records of 18 copies of
3000. HOLLIS, 18
Date 4 25. 66
Book 10 Page 81
at 3:26 P.M.
Office copy of 7
OF PLATS
City of 1, 1 only
Official Records
Plat 5. 1871, 1872
Sec 99 75 m. 1871

CHARLESTON-RAINBOW UNIT


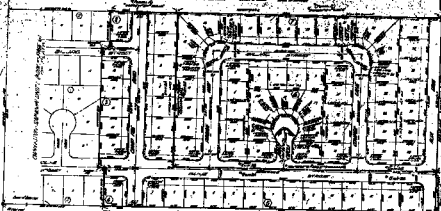




