

BOOK 891025

00976 10-12-24

Boo. 5 ~~881207~~

~~70970~~

AMENDED PLAT OF FOOTHILLS COUNTRY CLUB UNIT NO. 3

A PORTION OF SECTION 5, T 21 S, R 60 E, M. D. M.,
CITY OF LAS VEGAS, CLARK COUNTY, NEVADA

MATCH LINE
SEE SHEET 5 OF 12

MATCH SEE SHEET 5 OF 12

LINE

MATCH SEE SHEET 10 OF 12
LINE



LOT C

474,737 S.F.
11.358 AC.

LOT B
(GOLF COURSE AREA)
1,760,746 S.F.
40.421 AC.

LEGEND

- ⊗ BLOCK NUMBER
- C2 CURVE NUMBER
- 6 LOT NUMBER
- SUBDIVISION BOUNDARY
- ⊙ FND. MON. AS SHOWN
- SET 5/8" REBAR AND ALUM. CAP
R.L.S. 2050 W/BRASS CAP
REF. TIES SET IN T.O.C.

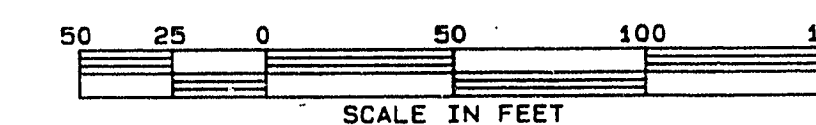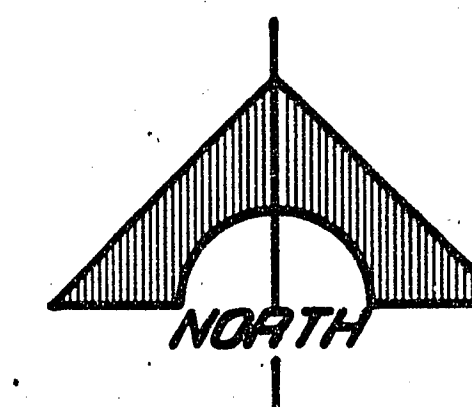

6 OF 12
SHEET 5 OF 11