

Book 890313

10-12-46

00525

AMENDED PLAT OF FOOTHILLS COUNTRY CLUB UNIT NO. 2

LEGEND

2 BLOCK NUMBER

C7 CURVE NUMBER

11 LOT NUMBER

SETBACK LINE:

20' MIN. FRONT YARD - FRONT ENTRY GARAGE

10' MIN. FRONT YARD - SIDE ENTRY GARAGE

5' MIN. SIDE YARD CORNER




FND. MON. AS SHOWN

SET 5/8" REBAR AND ALUM. CAP

R.L. S. 2050 W/BRASS CAP

REF. TIES SET IN T.O.C.

CURVE	DELTA	RADIUS	LENGTH	TANGENT
1	6°47'45"	376.00	44.80	22.33
2	18°00'24"	1008.00	281.60	141.72
3	21°21'01"	174.00	84.84	32.80
4	37°47'17"	226.00	149.05	77.35
5	99°04'22"	50.50	87.32	59.20

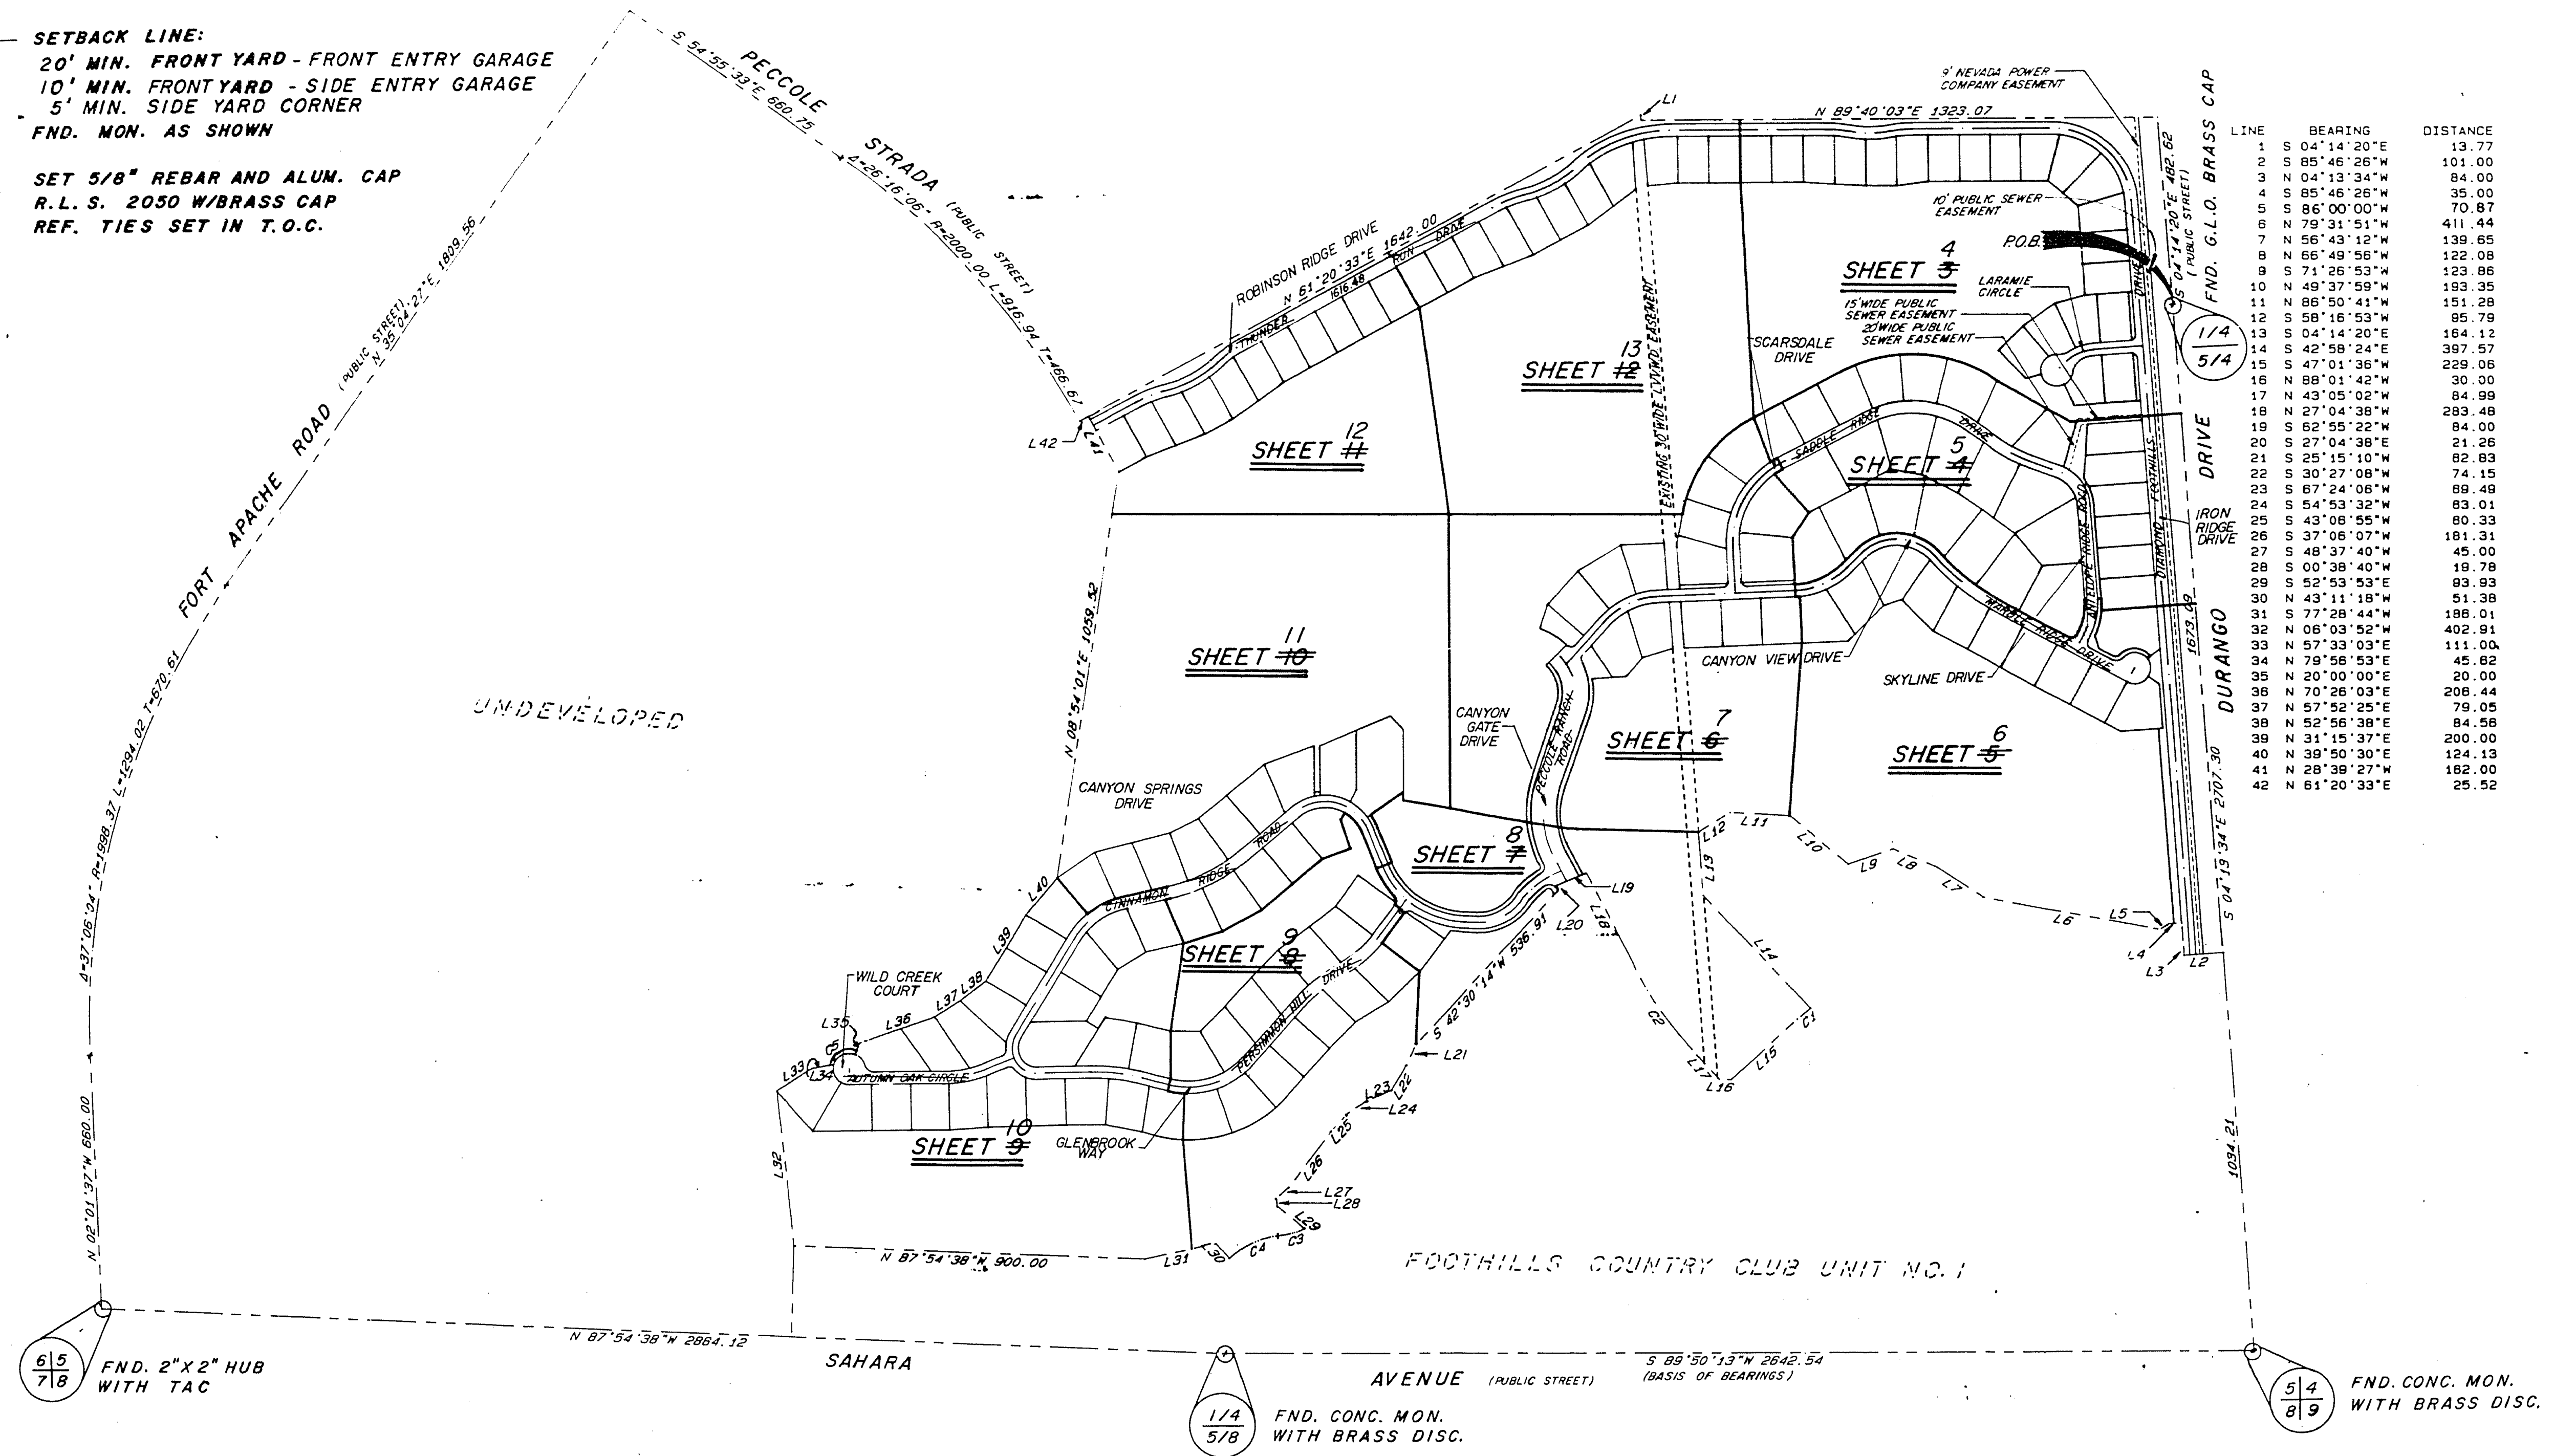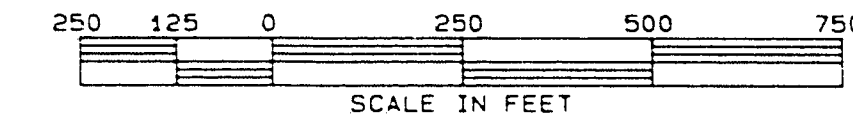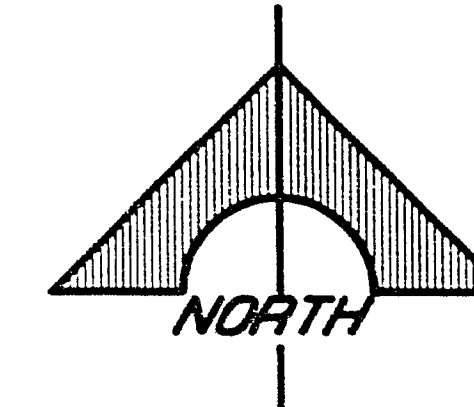

3 OF 13
SHEET 2 OF 12

Book 42 Page 4

Book 37 Page 37

1407-2 Amended