


10-12-48

00525



BOOK 890313
AMENDED PLAT OF
FOOTHILLS COUNTRY CLUB UNIT NO. 2

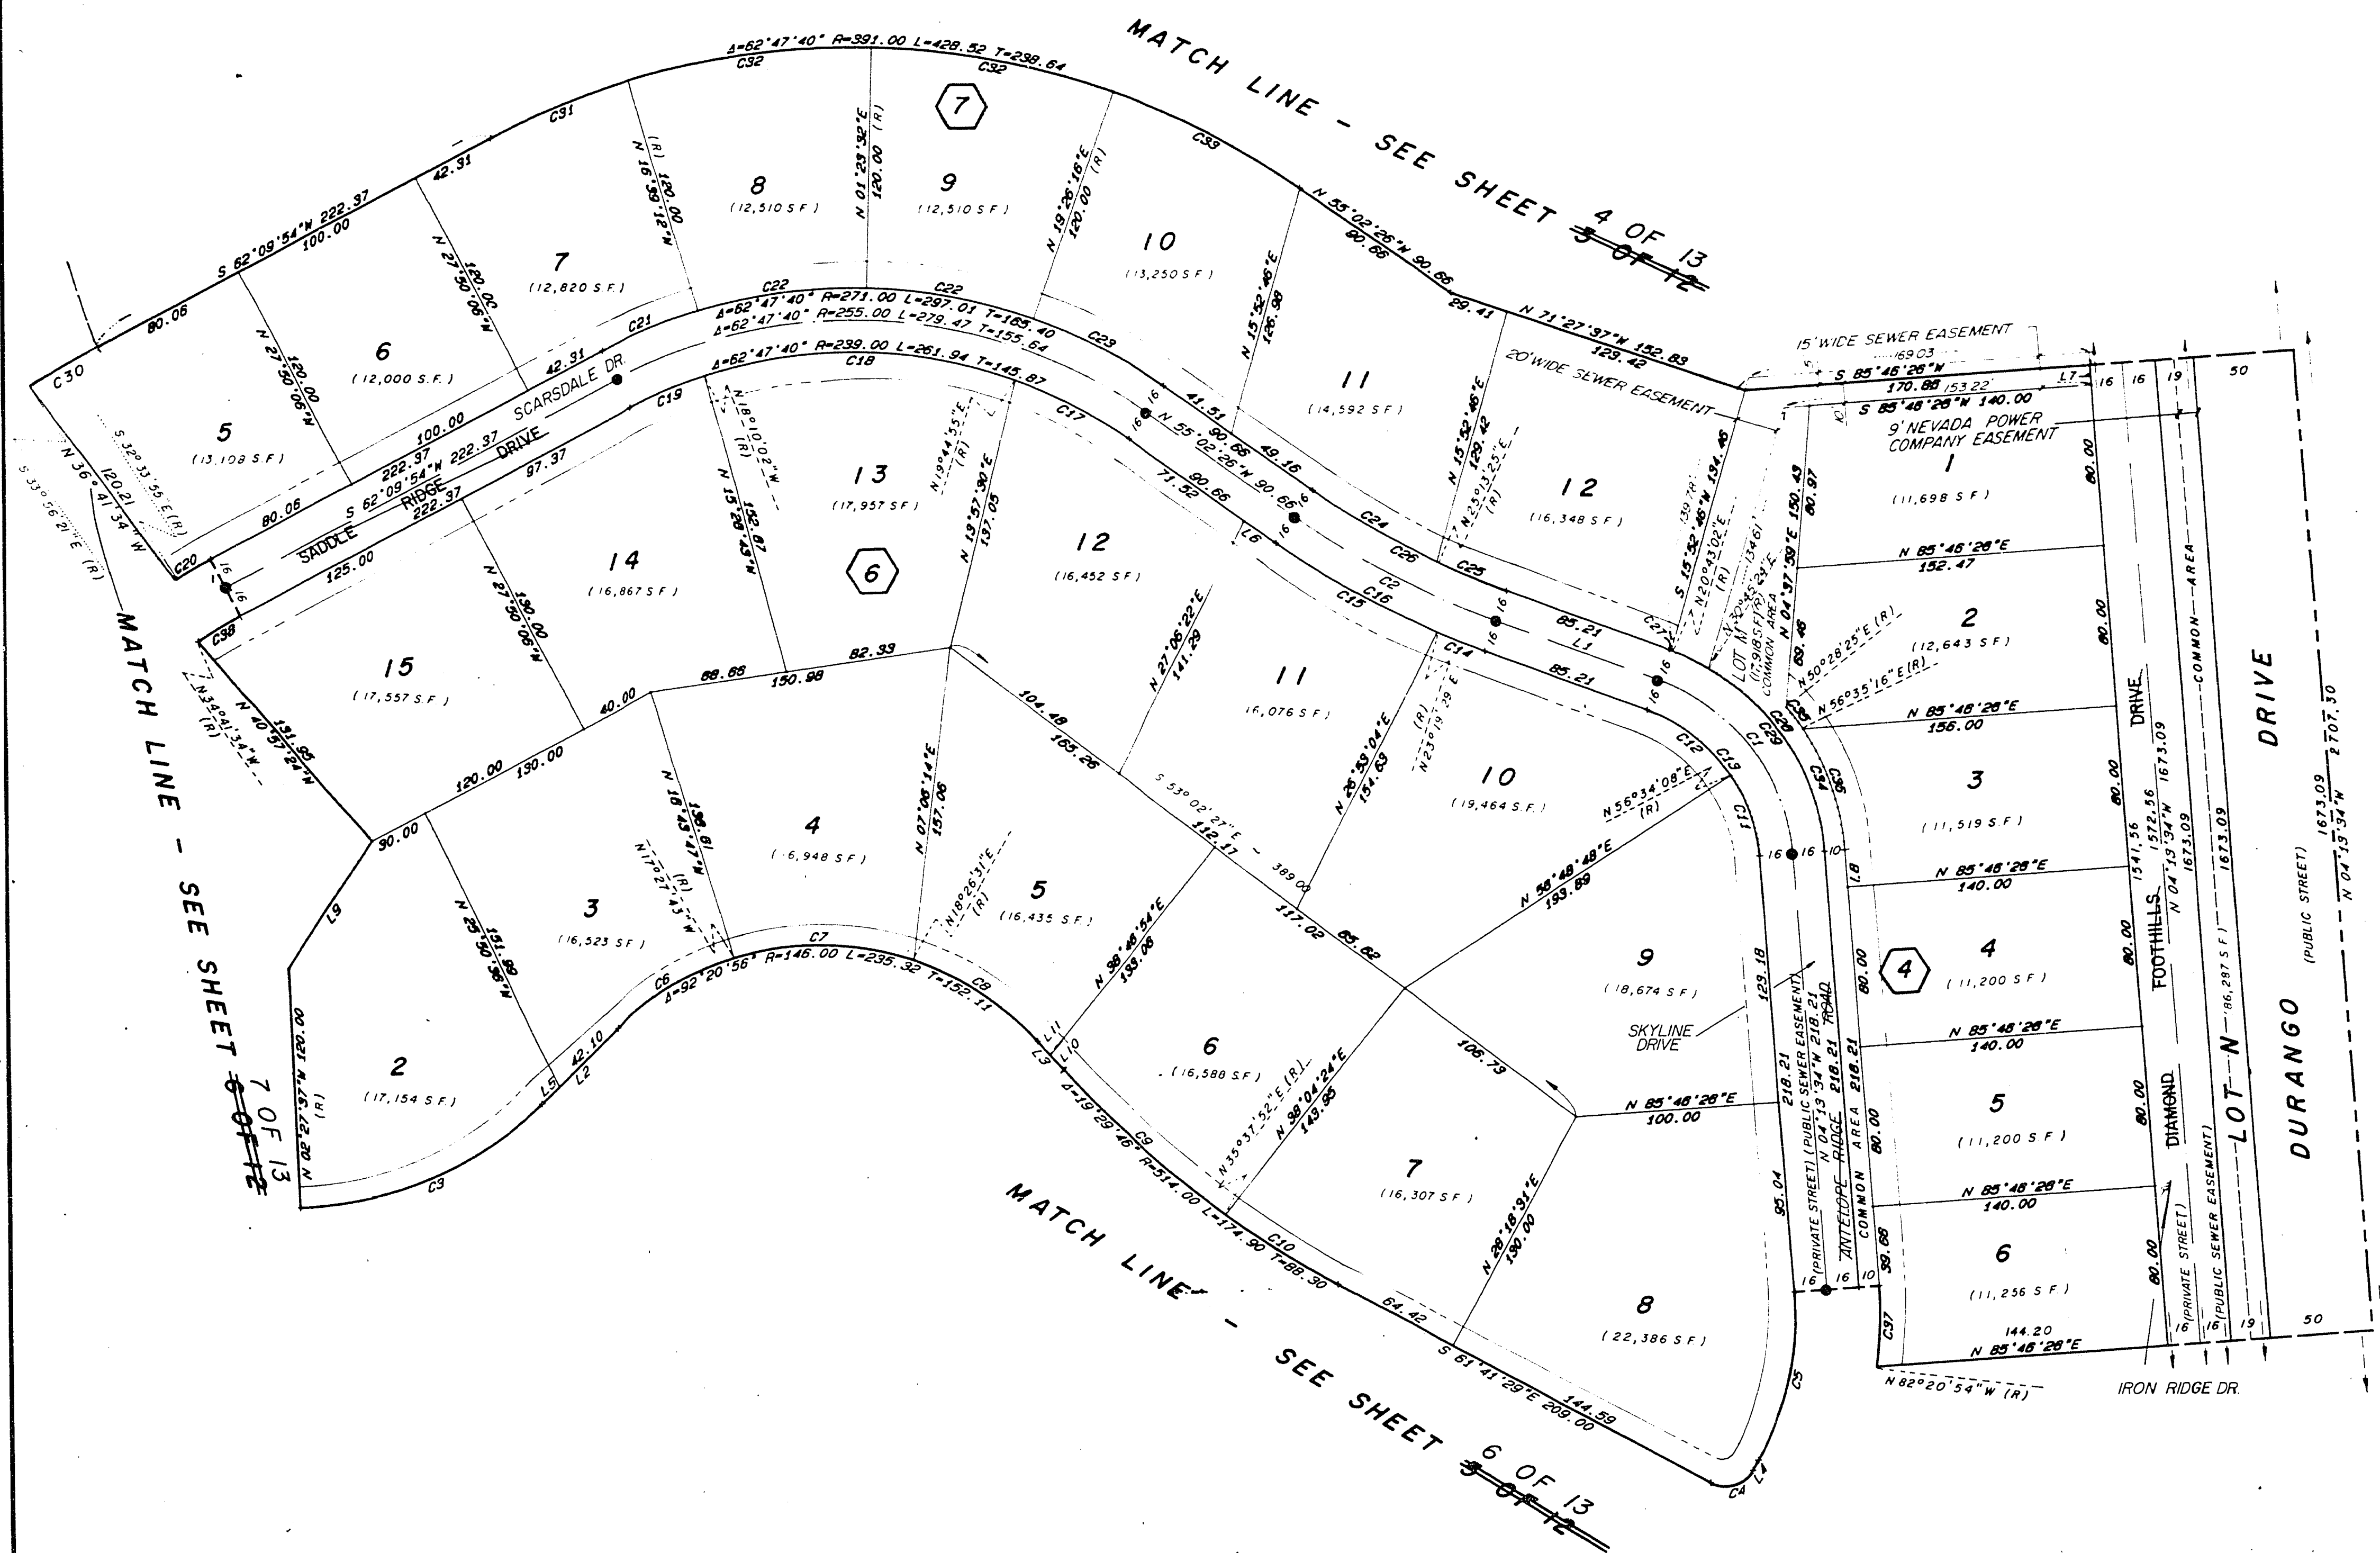

LINE	BEARING	DISTANCE
1	N 69°54'18"W	85.21
2	N 45°27'21"E	54.21
3	S 42°11'43"E	19.17
4	N 28°18'31"E	4.84
5	S 45°27'21"W	12.11
6	S 55°02'26"E	19.14
7	S 04°13'34"E	10.00
8	N 04°13'34"W	18.56
9	N 33°20'44"E	76.71
10	N 42°11'43"W	10.00
11	N 42°11'43"W	9.17

CURVE	DELTA	RADIUS	LENGTH	TANGENT
1	65°40'44"	100.00	114.63	64.54
2	14°51'52"	433.00	112.33	56.48
3	42°05'02"	184.00	135.15	70.79
4	50°00'00"	15.00	23.56	15.00
5	32°32'05"	154.00	87.45	44.84
6	27°04'56"	146.00	69.01	35.16
7	35°54'14"	146.00	91.49	47.30
8	29°21'46"	146.00	74.82	38.25
9	12°10'25"	514.00	109.21	54.81
10	7°19'21"	514.00	65.69	32.89
11	29°12'16"	84.00	42.82	21.88
12	36°28'26"	84.00	53.47	27.68
13	65°40'44"	84.00	96.29	54.22
14	3°13'47"	449.00	25.31	12.66
15	11°38'05"	449.00	91.18	45.75
16	14°51'52"	449.00	116.49	58.57
17	15°12'39"	239.00	63.45	31.91
18	37°54'58"	239.00	159.16	82.10
19	9°40'04"	239.00	40.33	20.21
20	4°43'49"	241.00	19.90	9.95
21	11°10'54"	271.00	52.89	26.53
22	18°02'44"	271.00	85.35	43.03
23	15°31'18"	271.00	73.42	36.93
24	9°44'09"	417.00	70.86	35.51
25	5°07'43"	417.00	37.33	18.68
26	14°51'52"	417.00	108.18	54.40
27	0°37'20"	116.00	1.26	0.63
28	65°03'24"	116.00	131.71	73.98
29	65°40'44"	116.00	132.97	74.87
30	0°47'06"	391.00	4.95	2.47
31	11°10'54"	391.00	76.31	38.28
32	19°02'44"	391.00	123.15	62.08
33	15°31'18"	391.00	105.92	53.29
34	35°18'01"	126.00	77.63	40.09
35	6°06'51"	126.00	13.45	6.73
36	29°11'10"	126.00	64.18	32.80
37	11°52'40"	196.00	40.63	20.39
38	6°51'29"	209.00	25.02	12.52
39	6°06'15"	361.00	38.46	19.25

UNDEVELOPED

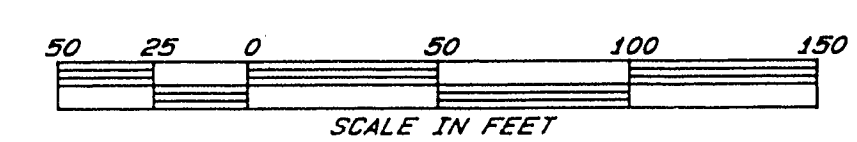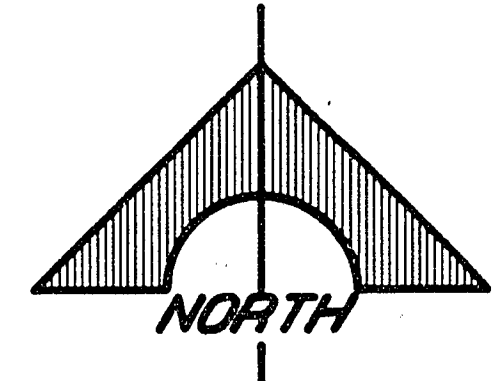

5 OF 13
SHEET 4 OF 12