


10-12-50

00525

BOOK 890313
AMENDED PLAT OF
FOOTHILLS COUNTRY CLUB UNIT NO. 2


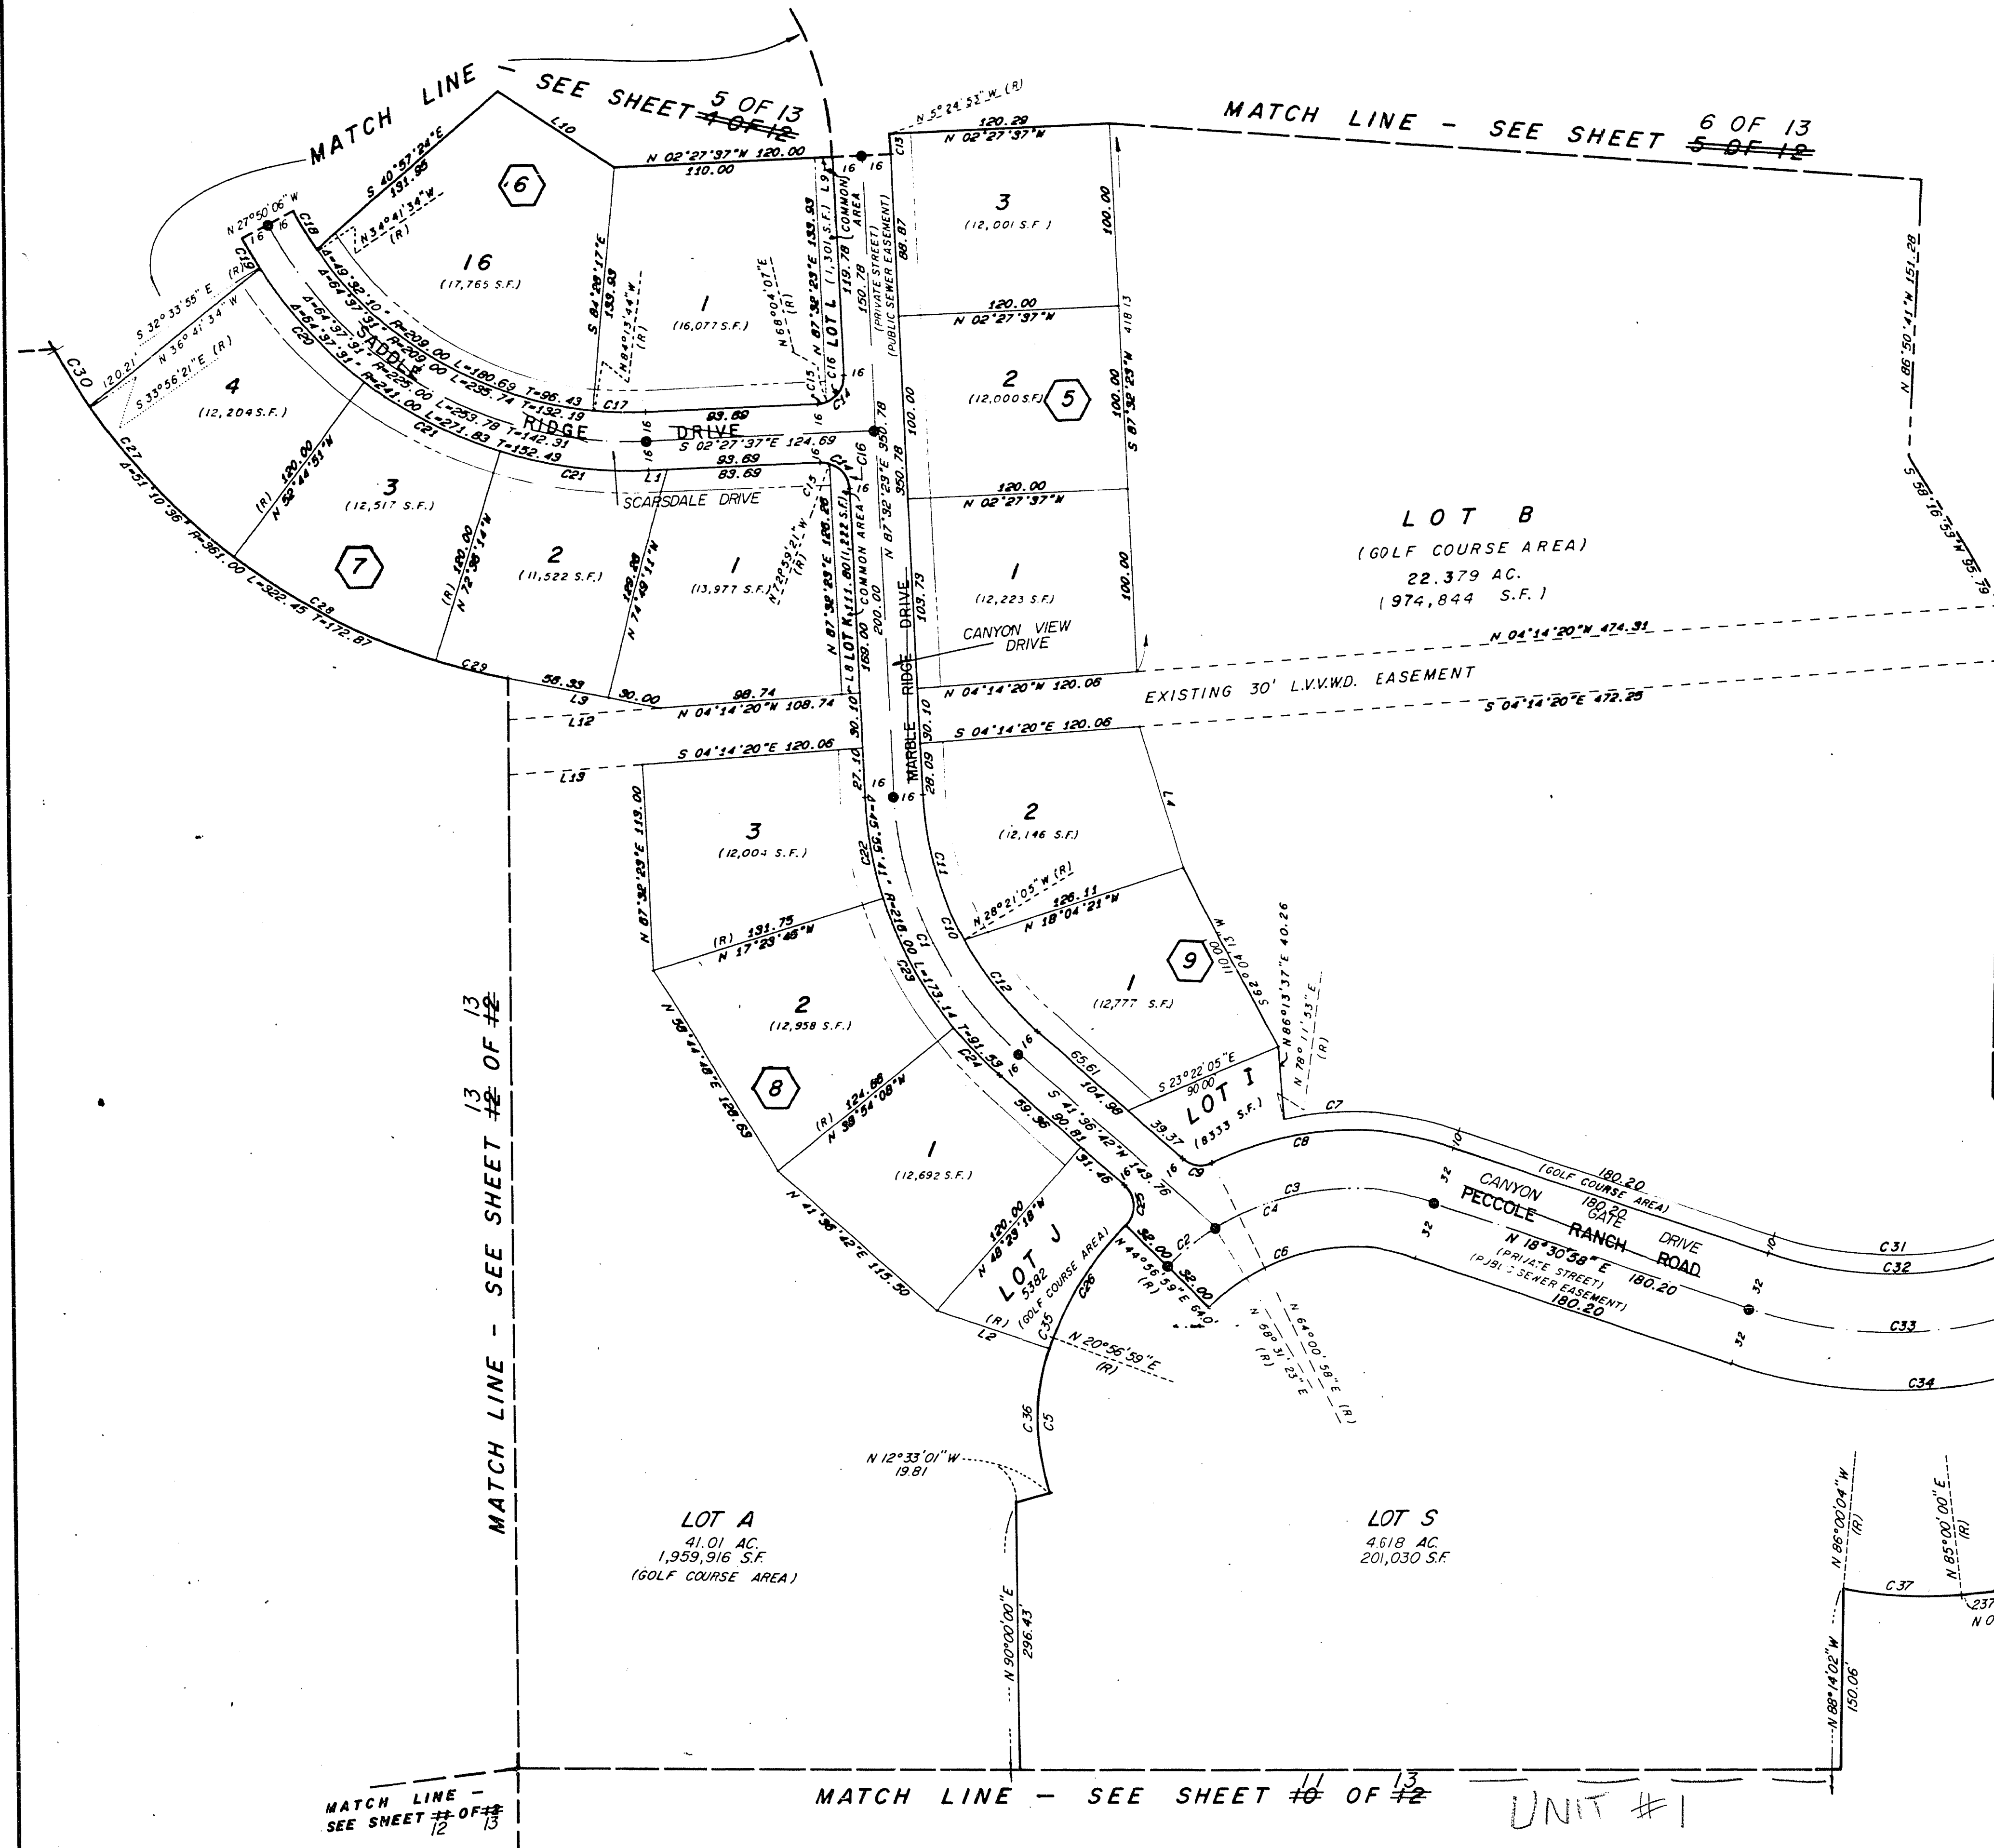


LINE	BEARING	DISTANCE
1	N 02°27'37\"	10.00
2	N 18°22'57\" E (R)	65.09
3	N 10°59'18\"	86.33
4	S 73°14'55\" W	80.72
5	S 41°38'49\" W	65.00
6	S 86°36'45\" W	35.36
7	S 86°36'45\" W	59.00
8	N 04°14'20\"	10.00
9	S 02°27'37\" E	10.00
10	N 33°20'44\"	76.71
11	N 44°58'49\"	10.00
12	S 04°14'20\" E	84.88
13	S 04°14'20\"	74.96

CURVE	DELTA	RADIUS	LENGTH	TANGENT
1	45°55'41\"	200.00	150.32	84.75
2	13°34'24\"	145.00	34.35	17.26
3	49°59'35\"	145.00	126.52	67.60
4	63°33'58\"	145.00	160.87	89.85
5	33°30'00\"	137.00	80.10	41.23
6	63°33'59\"	113.00	125.37	70.08
7	30°19'08\"	187.00	98.95	50.66
8	44°30'00\"	177.00	137.47	72.41
9	67°35'44\"	15.00	17.70	10.04
10	45°55'41\"	184.00	147.49	77.97
11	25°53'28\"	184.00	83.15	42.30
12	20°02'19\"	184.00	64.35	32.51
13	2°57'16\"	216.00	11.14	5.57
14	90°00'00\"	15.00	23.56	15.00
15	19°28'16\"	15.00	5.10	2.57
16	70°31'44\"	15.00	18.46	10.61
17	8°13'53\"	209.00	30.03	15.04
18	6°51'28\"	209.00	25.01	12.52
19	4°43'49\"	241.00	19.90	9.95
20	20°10'56\"	241.00	84.89	42.89
21	19°51'23\"	241.00	83.52	42.18
22	14°56'09\"	216.00	56.31	28.31
23	21°30'22\"	216.00	81.08	41.09
24	9°28'10\"	216.00	35.76	17.92
25	83°20'17\"	15.00	24.44	15.90
26	24°00'00\"	177.00	74.14	37.62
27	24°07'59\"	361.00	152.02	77.15
28	19°51'23\"	361.00	125.11	63.19
29	6°24'28\"	361.00	40.37	20.21
30	0°44'00\"	361.00	4.93	2.47
31	48°35'36\"	188.00	157.56	83.22
32	48°35'36\"	208.00	165.52	87.42
33	48°35'36\"	240.00	190.98	100.87
34	48°35'36\"	272.00	216.45	114.32
35	02°34'02\"	137.00	6.14	3.07
36	30°55'58\"	137.00	73.96	37.91
37	09°59'56\"	385.00	60.47	30.30
38	18°48'30\"	361.00	118.50	59.79
39	06°06'15\"	361.00	38.46	19.25

SHEET 8 OF 13

SEE

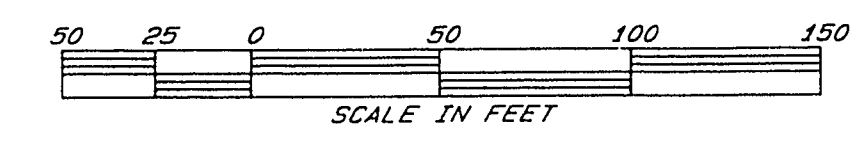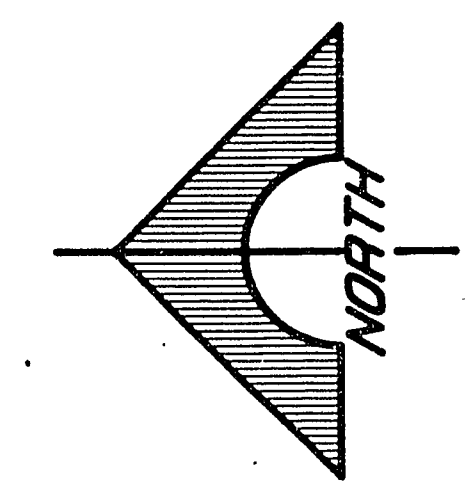

7 OF 13
SHEET 8 OF 12