


BOOK 890313 AMENDED PLAT OF
FOOTHILLS COUNTRY CLUB UNIT NO. 2

00525


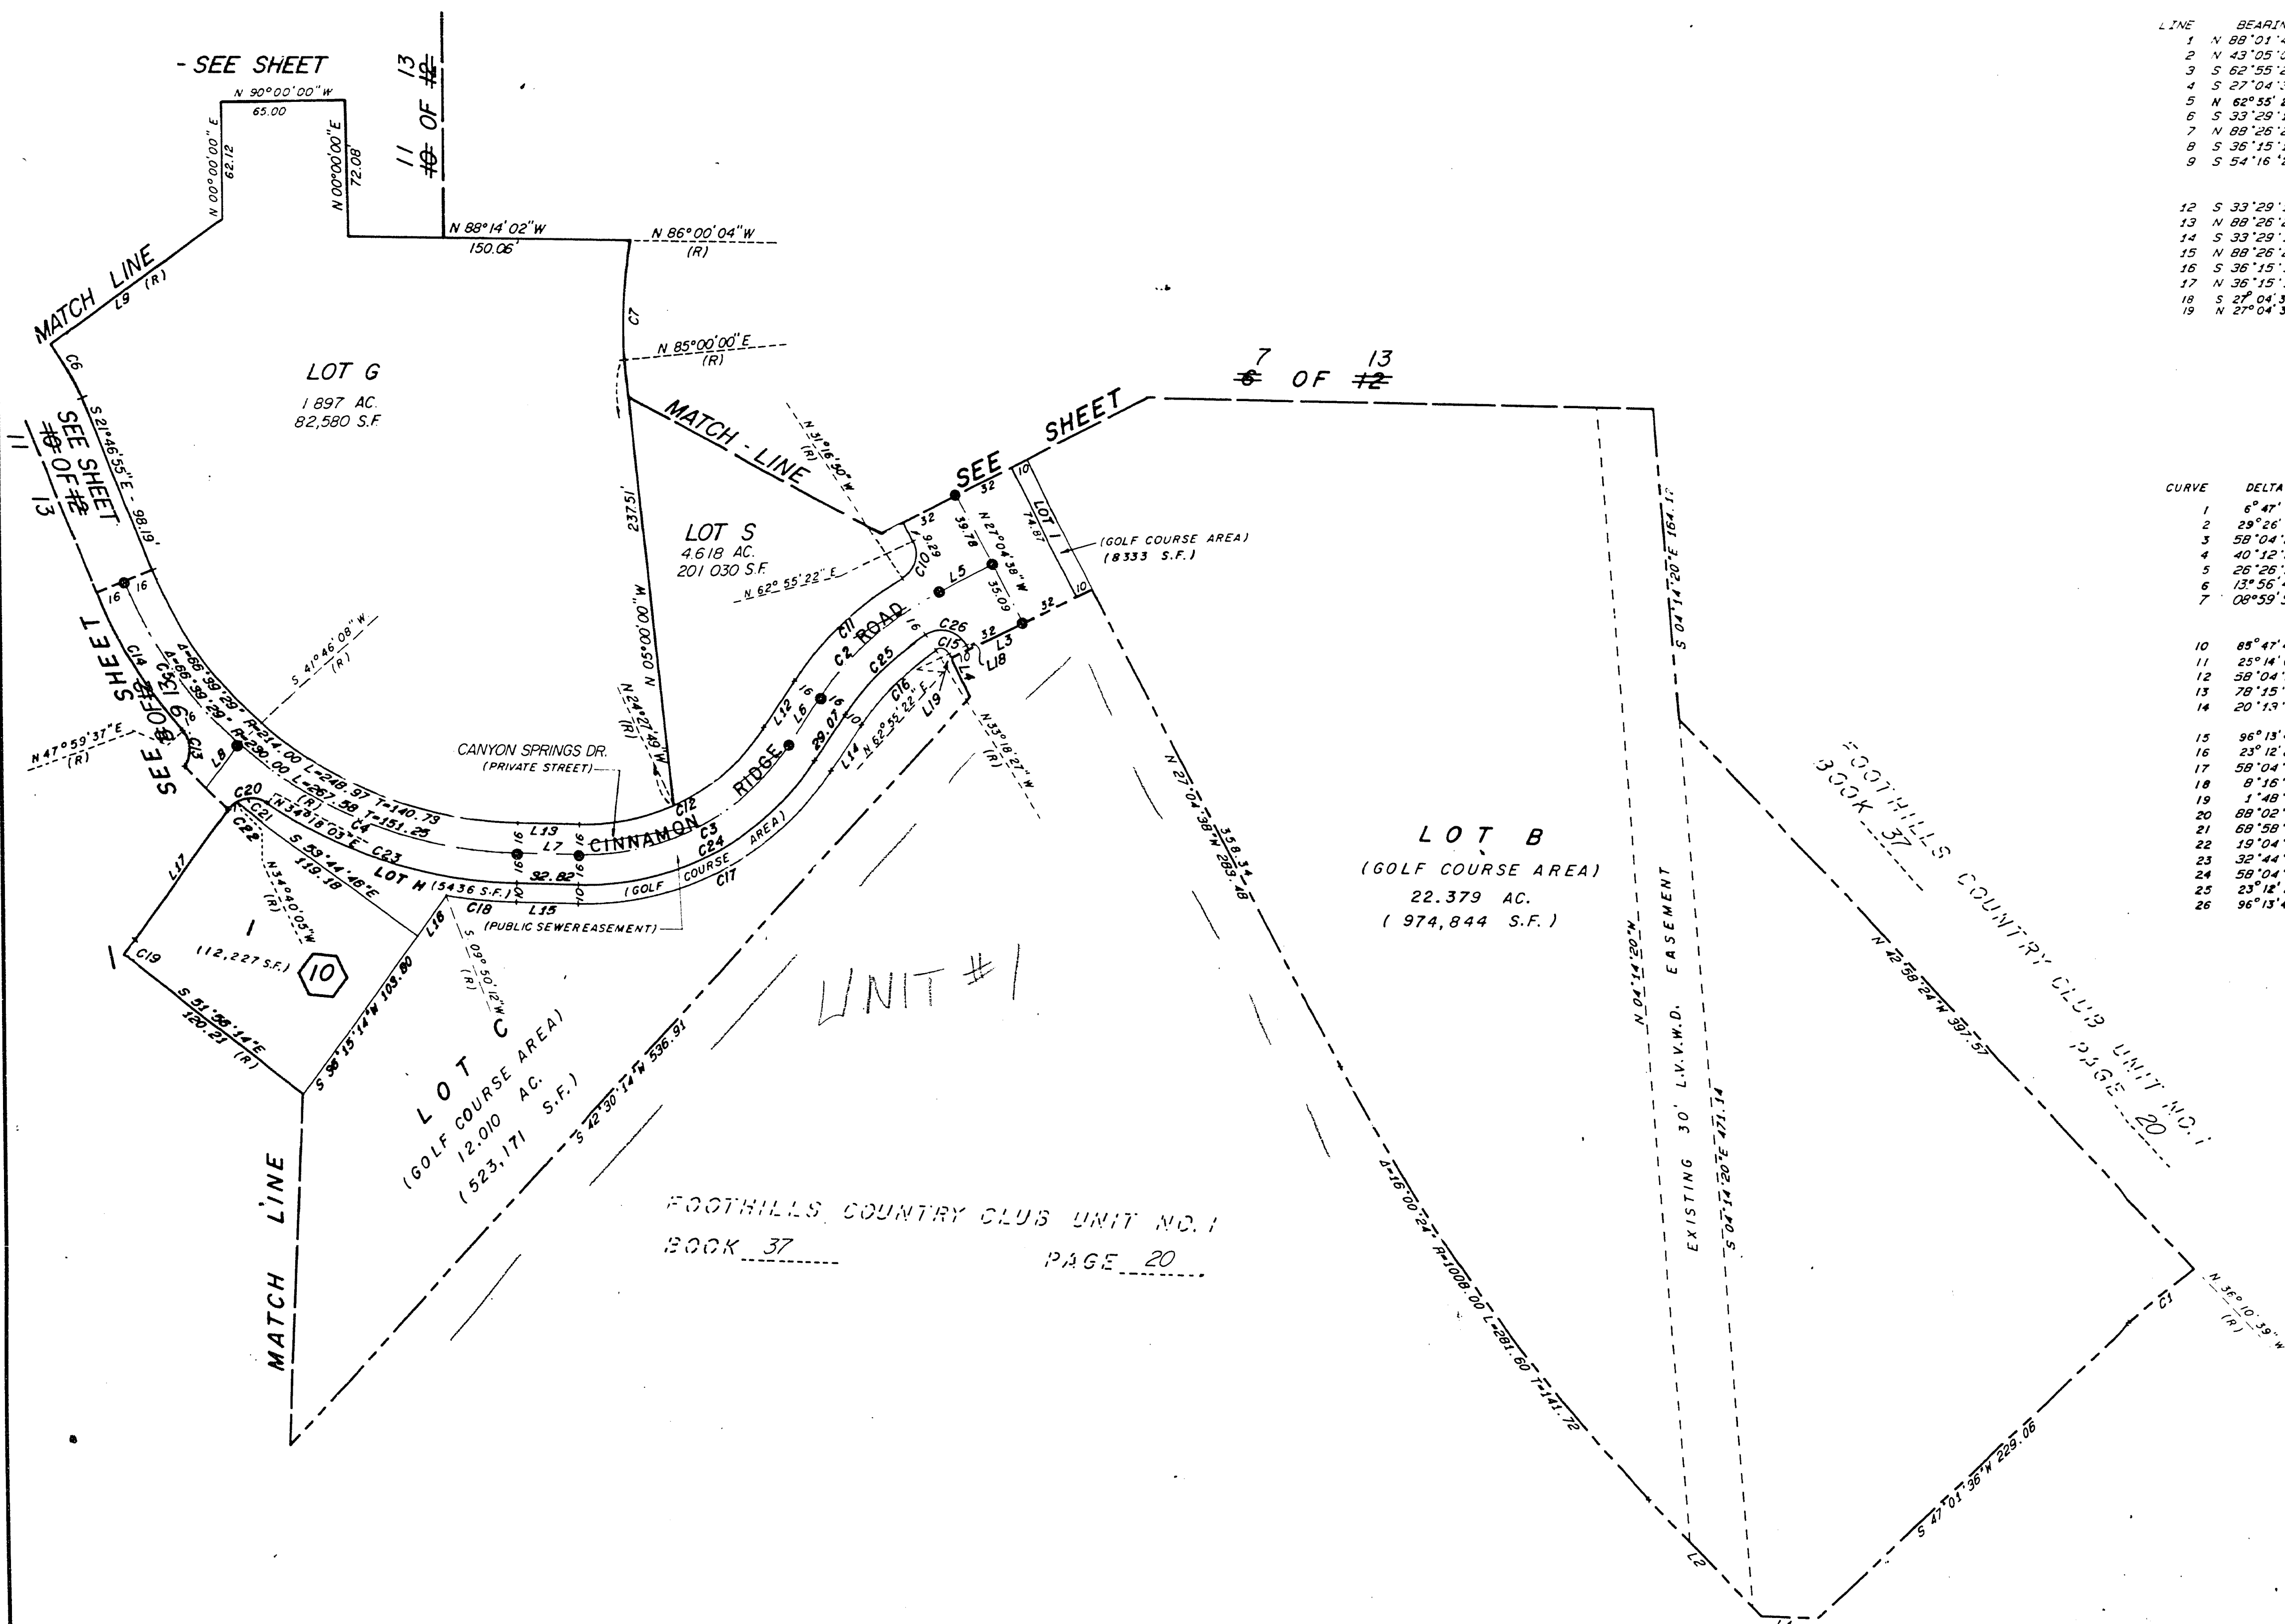


LINE	BEARING	DISTANCE
1	N 88°01'42"W	30.00
2	N 43°05'02"W	84.99
3	S 62°55'22"W	84.00
4	S 27°04'39"E	21.26
5	N 62°55'22"E	33.00
6	S 33°29'10"W	29.07
7	N 89°26'24"W	32.82
8	S 36°15'14"W	29.26
9	S 54°16'25"W (R)	113.48

12	S 33°29'10"N	29.07
13	N 88°26'24"N	32.82
14	S 33°29'10"N	29.07
15	N 88°26'24"N	32.82
16	S 36°15'14"N	26.68
17	N 36°15'14"E	85.44
18	S 27°04'38"E	3.32
19	N 27°04'38"W	3.32

CURVE	DELTA	RADIUS	LENGTH	TANGENT
1	6° 47' 45"	376.00	44.60	22.33
2	29° 26' 12"	160.00	82.20	42.05
3	58° 04' 26"	130.00	131.77	72.17
4	40° 12' 32"	230.00	161.41	84.19
5	26° 26' 57"	230.00	106.17	54.05
6	13° 56' 40"	136.00	33.10	16.63
7	08° 59' 56"	385.00	60.47	30.30

10	85° 47' 46"	15.00	22.46	13.94
12	58° 04' 26"	15.00	115.55	53.29
13	78° 15' 37"	15.00	20.49	12.20
14	20° 13' 28"	246.00	86.83	43.87
15	96° 13' 49"	5.00	8.40	5.58
17	58° 04' 26"	15.00	89.60	85.60
19	1° 48' 32"	306.00	9.66	4.83
20	88° 02' 49"	15.00	23.05	14.50
21	68° 58' 08"	15.00	18.06	10.30
22	19° 04' 41"	15.00	4.99	2.52
23	32° 44' 12"	246.00	14.57	72.26
24	58° 04' 26"	146.00	161.98	84.19
25	23° 16' 21"	15.00	59.32	29.57

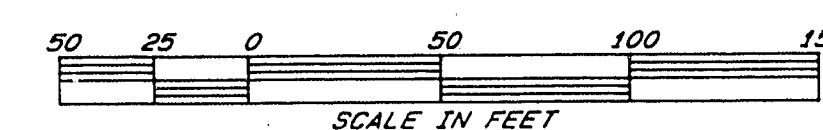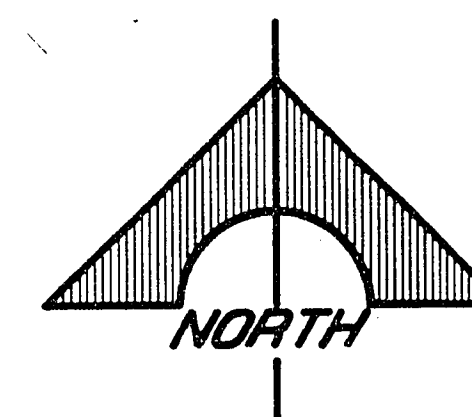

SHEET ~~7 OF 12~~ 8 OF 13