




10-14-52

C0525

AMENDED PLAT OF FOOTHILLS COUNTRY CLUB UNIT NO. 2

LINE	BEARING	DISTANCE
1	S 25°15'10"W	62.83
2	S 30°27'08"W	74.15
3	S 67°24'05"W	69.49
4	S 54°53'32"W	63.01
5	S 43°05'55"W	60.33
6	S 49°37'40"W	45.00
7	S 00°38'40"W	13.78
8	N 43°11'18"W (R)	51.38
9	S 77°28'44"W	166.01
10	N 57°50'52"E	65.42
11	N 36°15'14"E	88.09
12	S 57°50'52"W	14.00
13	S 28°55'17"W	20.00
14	S 18°57'42"E	78.73
15	S 70°00'00"W	80.00

CURVE	DELTA	RADIUS	LENGTH	TANGENT
1	21°21'01"	174.00	64.84	32.80
2	37°47'17"	226.00	149.05	77.35
3	21°59'05"	336.00	128.93	65.27
4	6°38'07"	336.00	38.91	19.48
5	18°34'50"	184.00	59.67	30.10
6	43°30'22"	184.00	139.72	73.42
7	6°38'07"	216.00	25.01	12.52
8	21°59'05"	216.00	82.88	41.98
9	11°28'55"	216.00	43.29	21.72
10	15°57'02"	390.00	108.57	54.64
11	21°35'38"	290.00	109.30	55.30
12	1°48'32"	306.00	9.68	4.83
13	18°07'09"	306.00	86.77	48.79
14	1°39'57"	306.00	8.90	4.45
15	21°35'38"	306.00	115.33	58.36
16	5°41'46"	374.00	37.18	18.61
17	10°15'16"	374.00	66.94	33.56
18	15°57'02"	374.00	104.12	52.40
19	15°57'02"	406.00	113.03	56.88
20	8°42'28"	406.00	61.70	30.91
21	7°14'34"	406.00	51.32	25.70
22	19°58'22"	274.00	95.51	48.25
23	1°37'16"	274.00	7.75	3.88
24	21°35'38"	274.00	103.27	52.25
25	78°15'37"	15.00	20.49	12.20
26	59°12'44"	15.00	15.50	8.52
27	19°02'53"	15.00	4.89	2.52
28	20°13'28"	246.00	86.83	43.87
29	39°17'48"	104.00	71.33	37.13

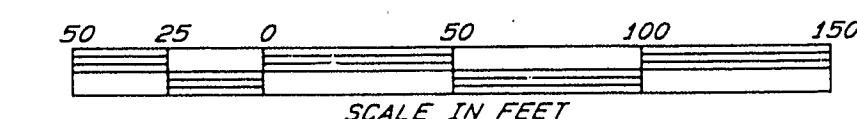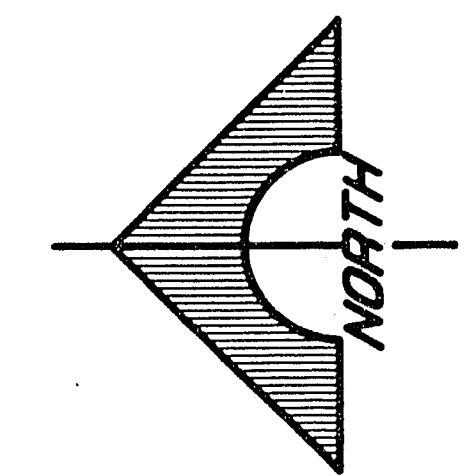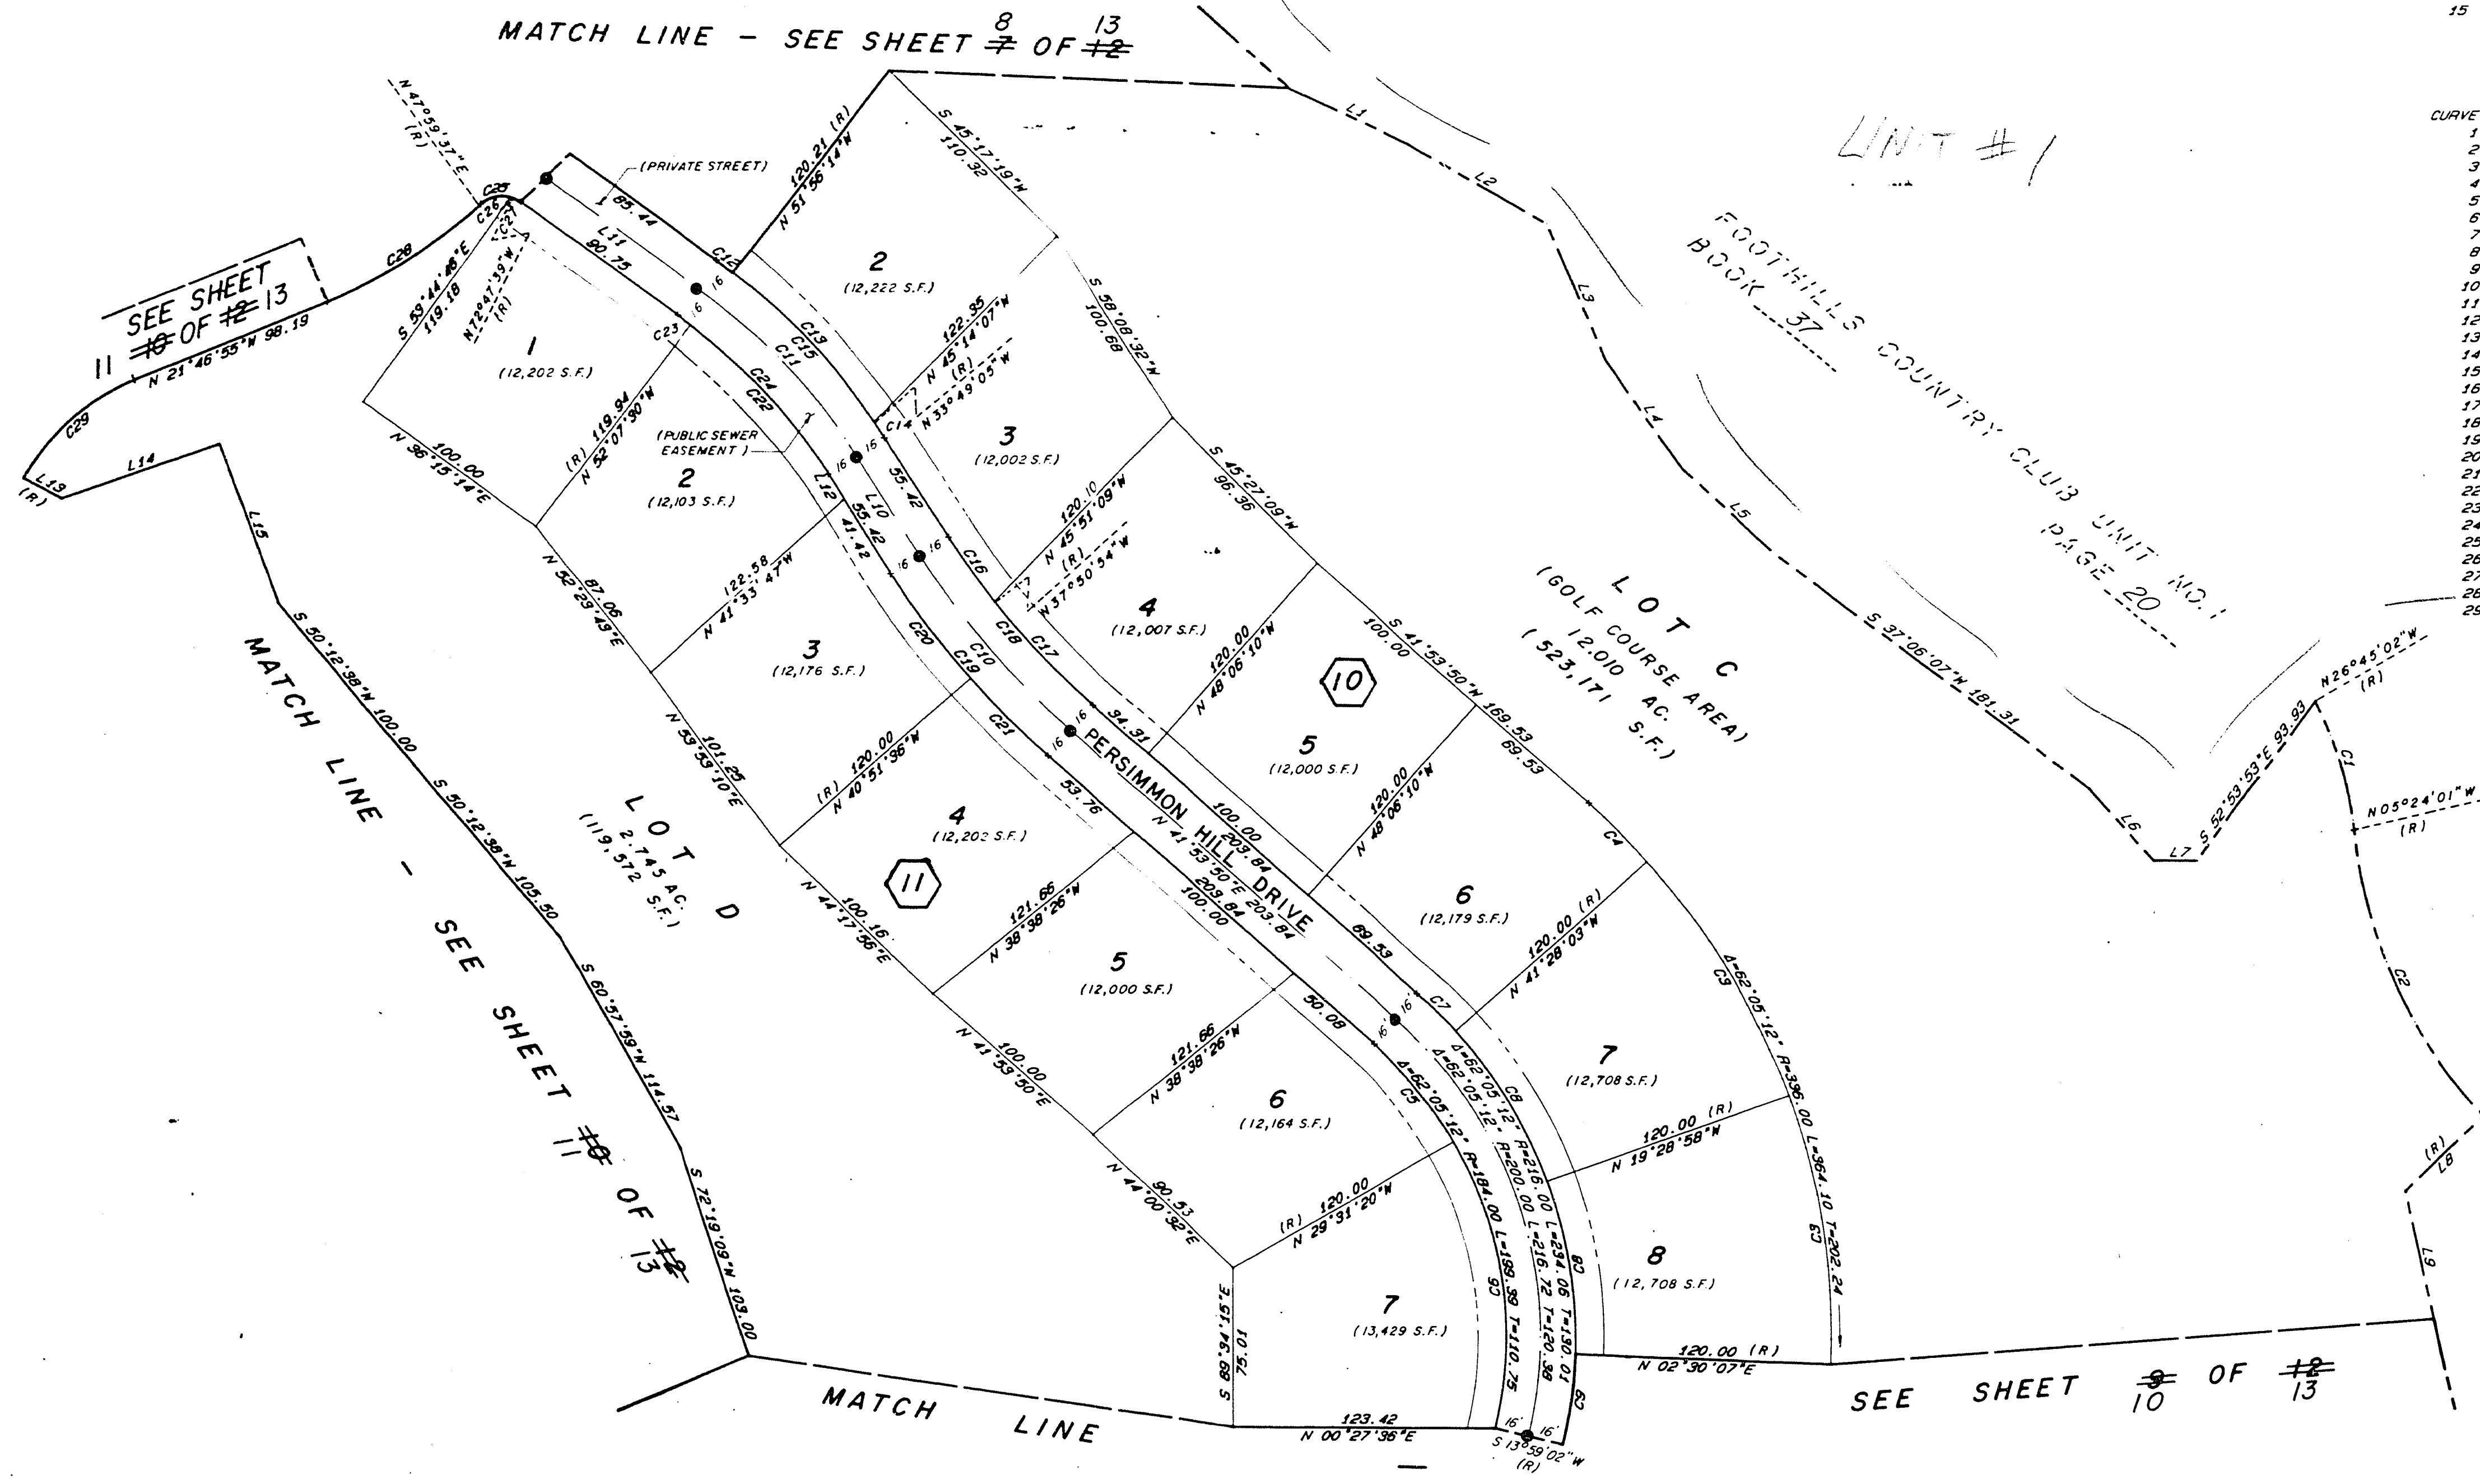

9 OF 13
SHEET 8 OF 12